



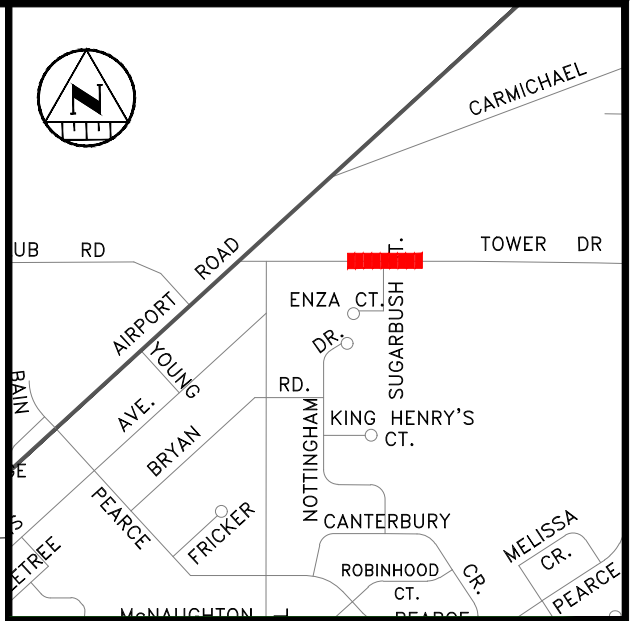

KEY PLAN
LEGEND

REVISIONS				
no.	date	by	description	
1.	8 Jun 2015		As-Built	

Disclaimer
The information contained on this drawing may be based upon data provided by others and may not have been verified by either as-constructed drawings or an Ontario Land Surveyor. The City of North Bay cannot accept responsibility for any errors or omissions on any information shown herein. Field verification, land surveys or excavation (with City approvals) may be required to determine actual location of any and all utilities or property lines.

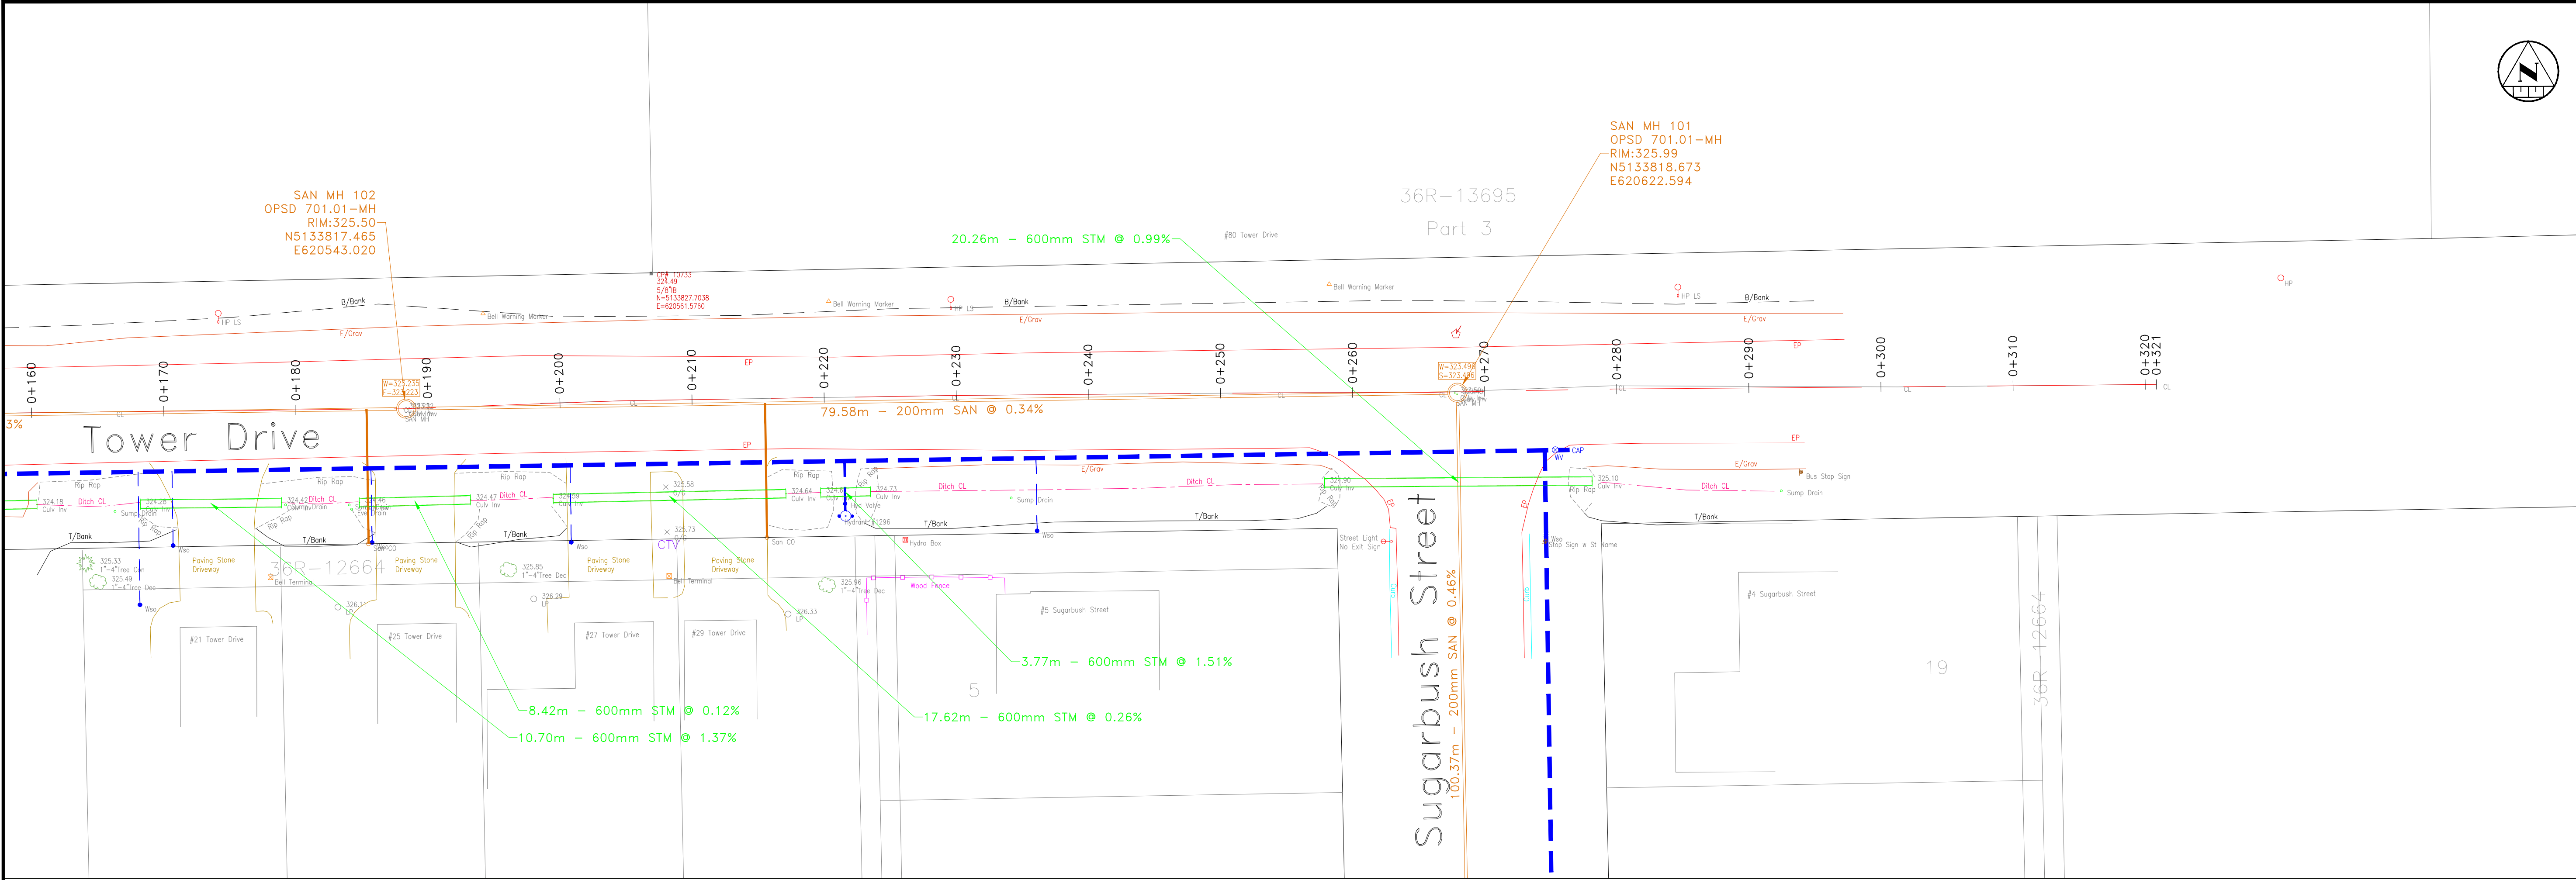

**From #25 Tower Dr.
To Enza Court**

AS-BUILT	
TOWER_DRIVE	
STA. 0+170 to 0+320.85	
designer	drawn by: G.W.C.
checked by:	approved by:
scale H:1:250 V:1:50	
date 8/06/2015	drawing number T-352

