
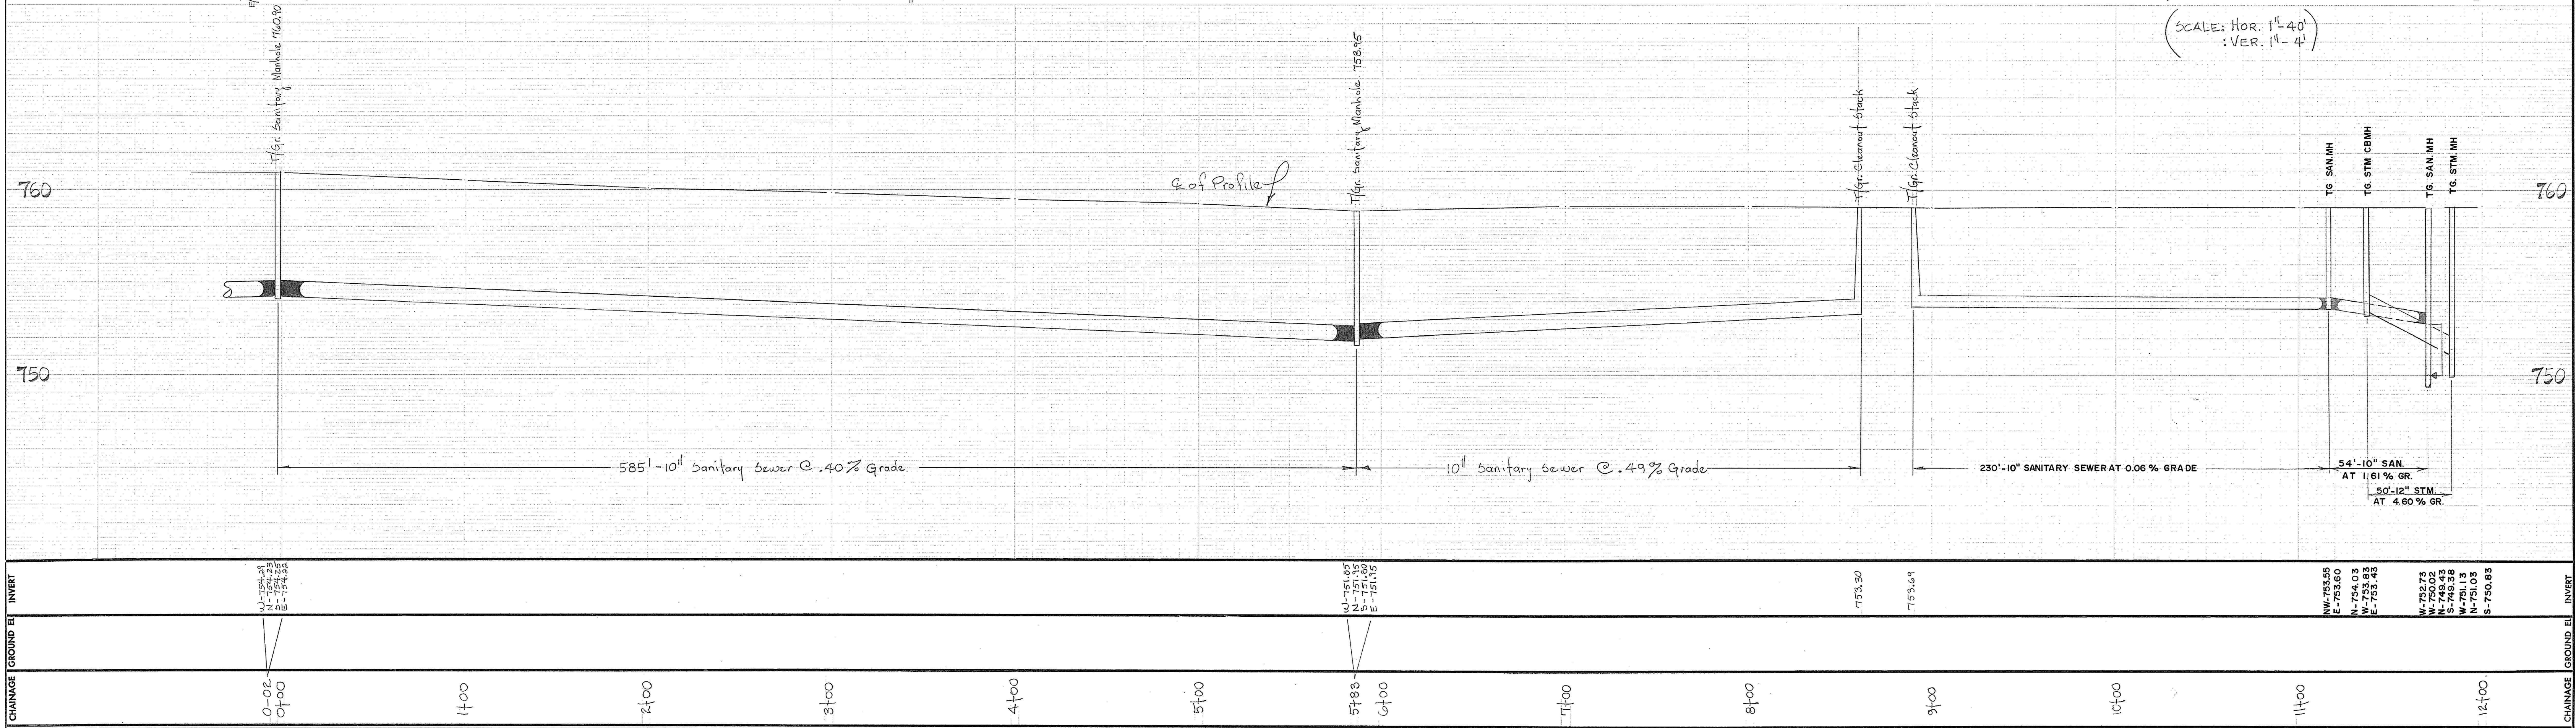


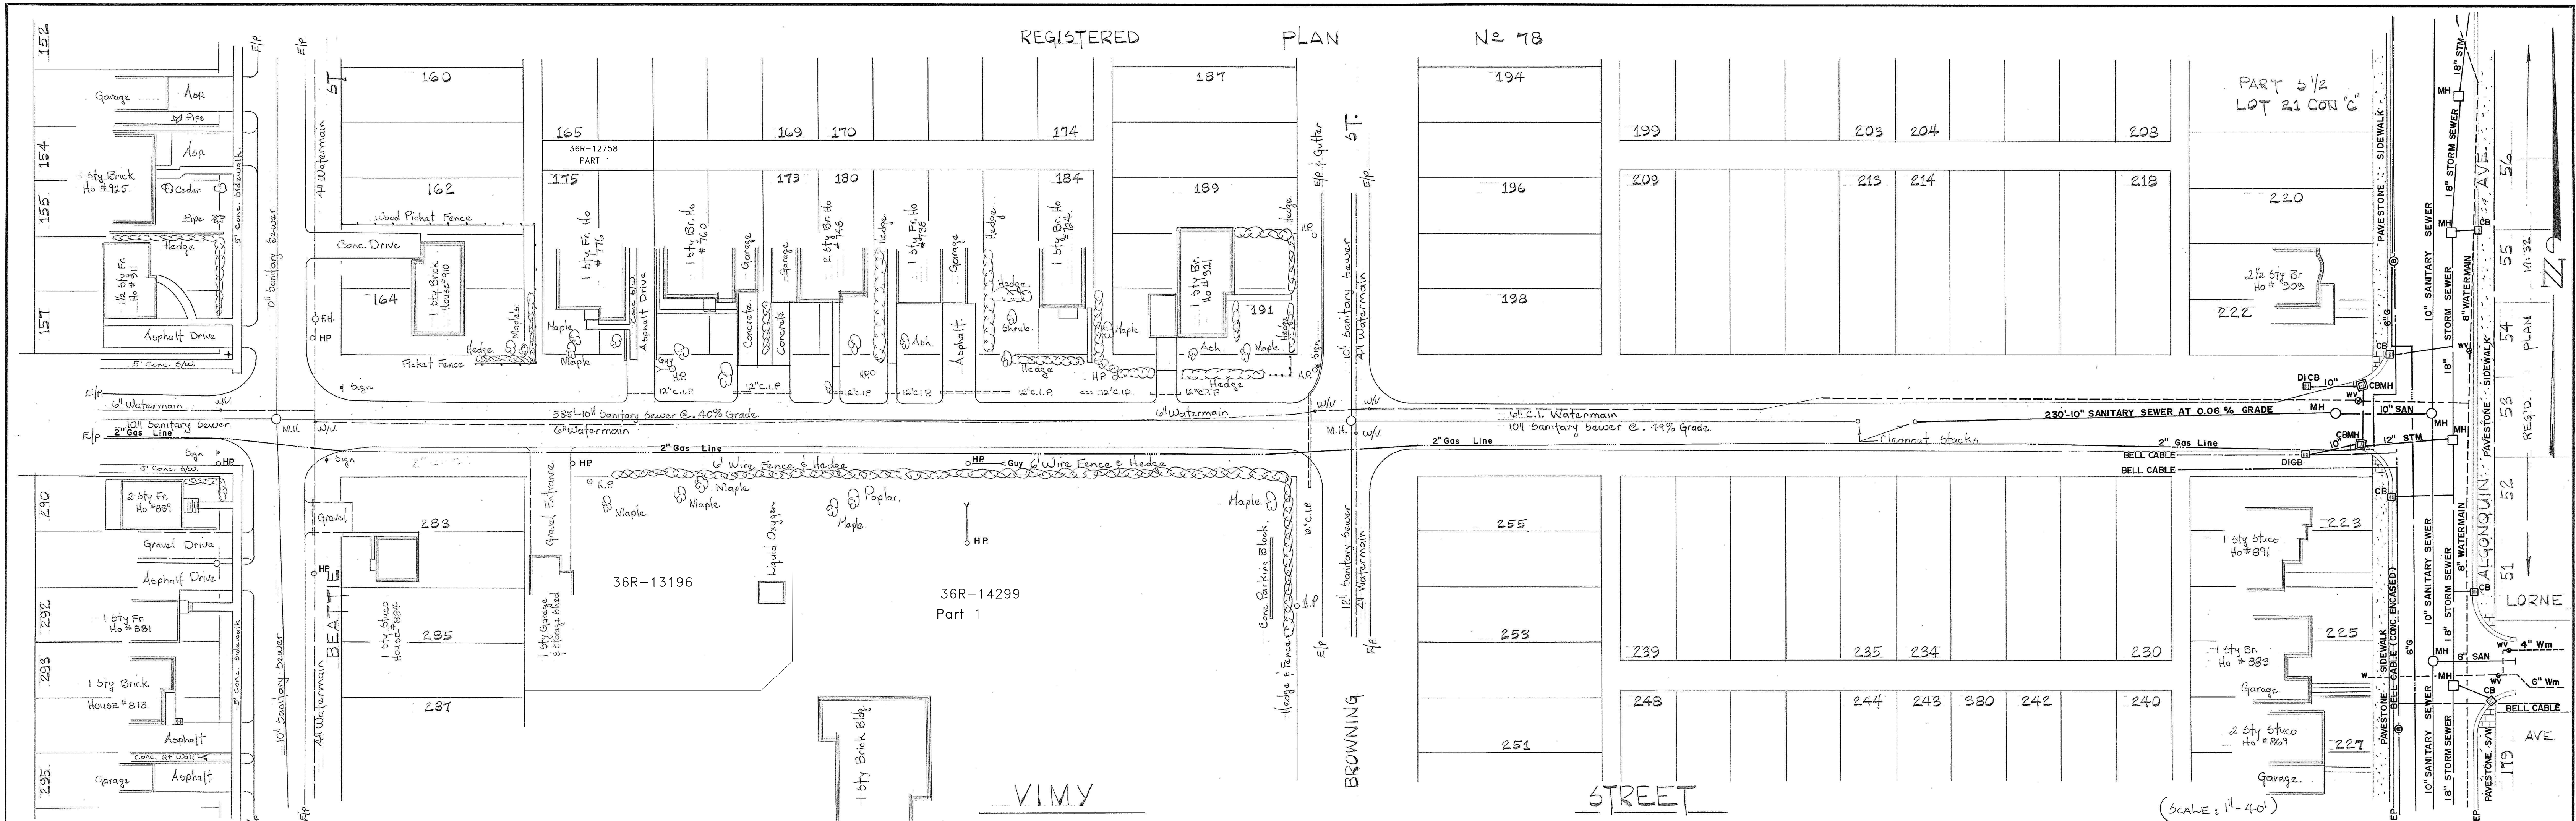

DWG. NO.	NOTES: DISCLAIMER The information contained on this drawing may be based upon data provided by others and may not have been verified by either as-constructed drawings or an Ontario Land Surveyor. The City of North Bay cannot accept responsibility for any errors or omissions on any information shown herein. Field verification, land surveys or excavation (with City approvals) may be required to determine actual location of any and all utilities or property lines.	1	NEW DRAWING (FEB. 1956)	OCT 72	RFB	APPROVED	VIMY STREET BEATTIE STREET TO ALGONQUIN AVENUE REG'D PLAN NO.: 78 & M: 32	CITY OF NORTH BAY ENGINEERING DEPARTMENT				
		2	GAS LINE, BEATTIE TO ALGONQUIN.	DEC. 75	A.P.							
		3	HYDRO POLE LOCATIONS.	JULY 78	J.D.M.			SCALE: AS SHOWN ABOVE DATE: OCT 1972				
		4	REVISED ALGONQUIN AVE. CONT 101-90 BK 287	APRIL/94	RT							
		5	36R-12758 Added	Sept 09	G.W.C.			DRAWN BY: RFB C.D. BY:	FIELD BOOK No. # 221	DRAWING No. V-1	REV.	
		6	36R-13196 Added	Jan. '12	G.W.C.							
		No.	REVISION	DATE	INITIAL							