
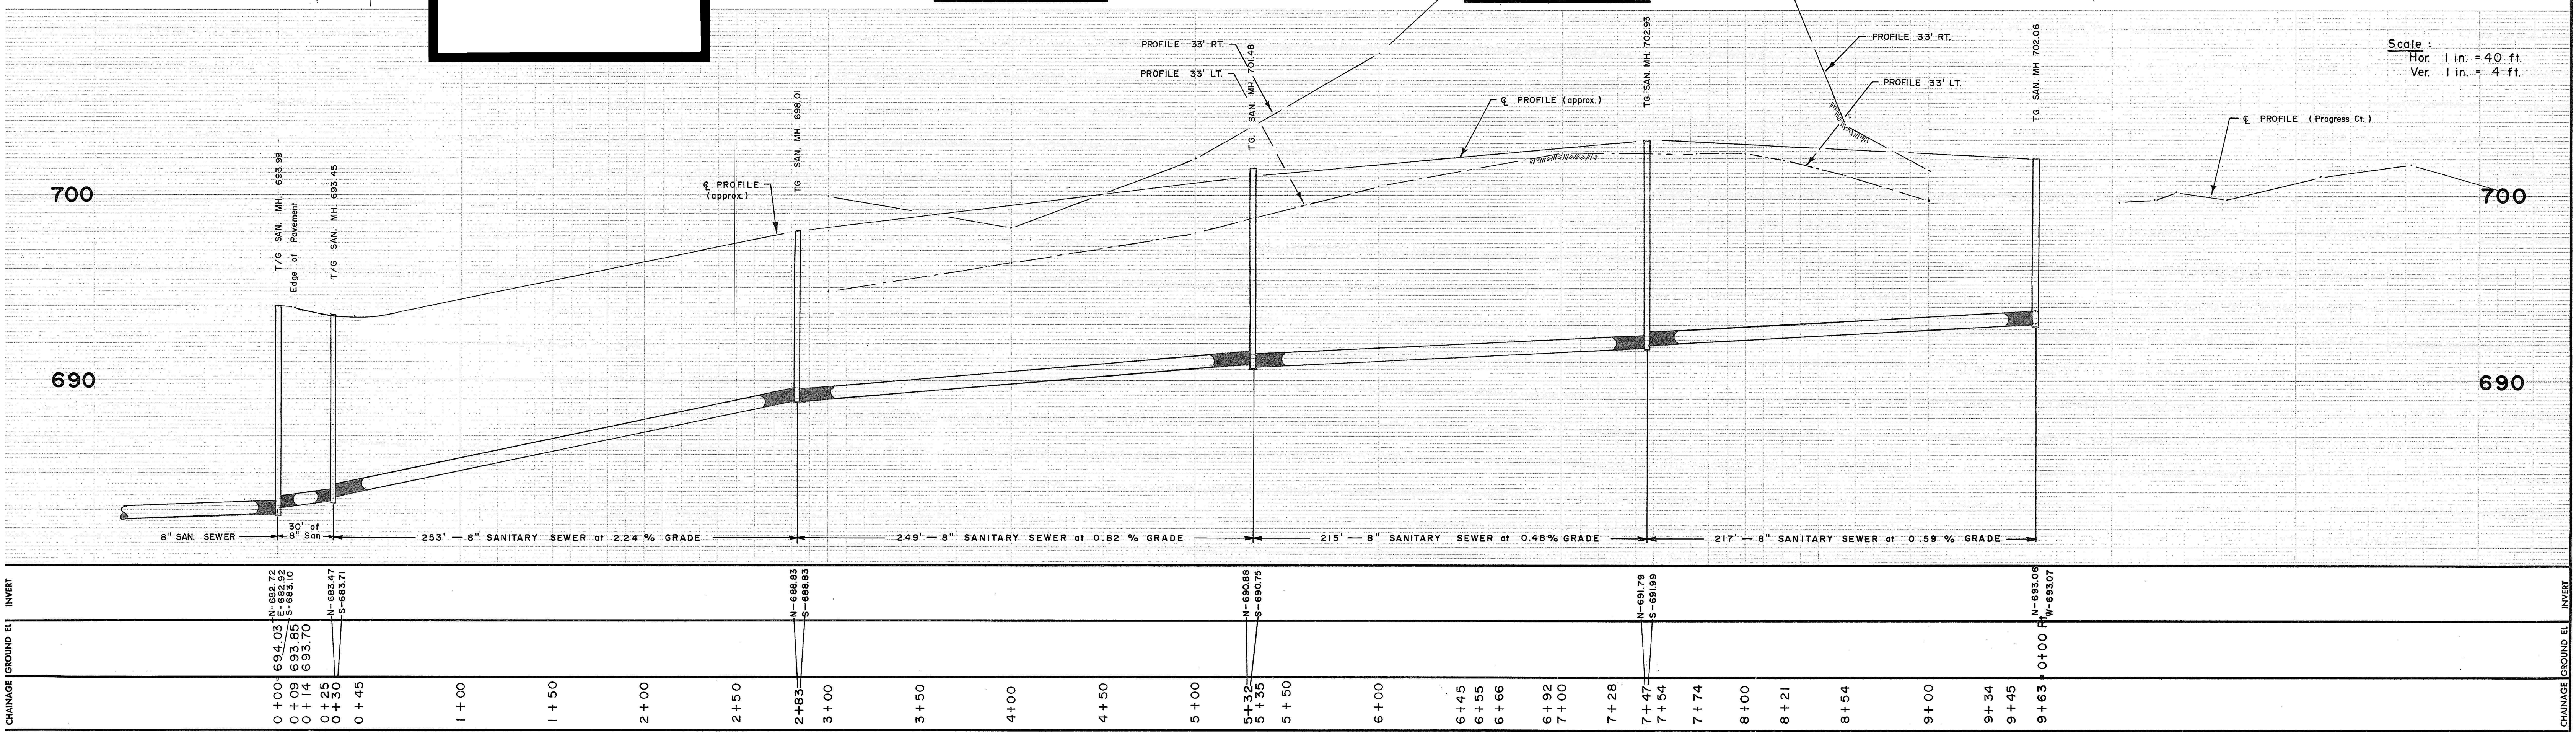


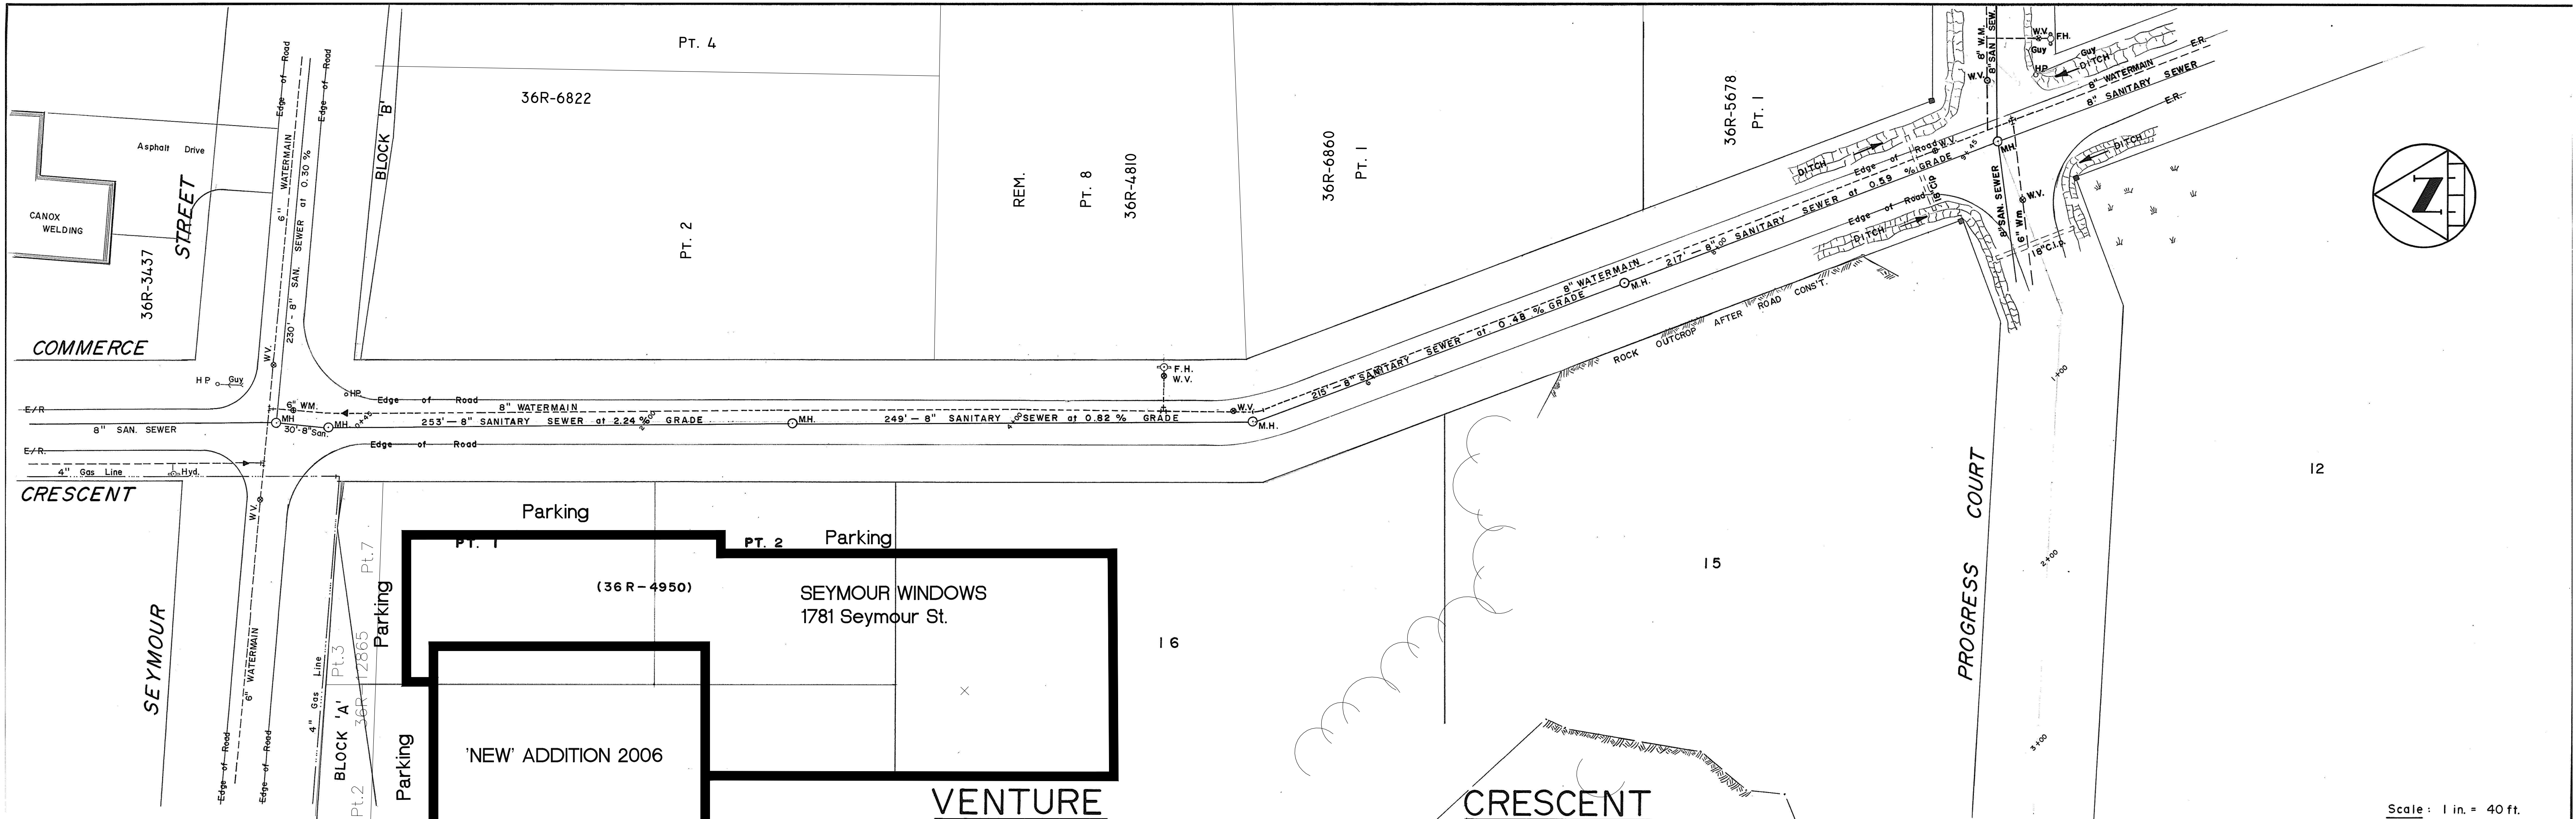

NOTES:	DISCLAIMER The information contained on this drawing may be based upon data provided by others and may not have been verified by either as-constructed drawings or an Ontario Land Surveyor. The City of North Bay cannot accept responsibility for any errors or omissions on any information shown herein. Field verification, land surveys or excavation (with City approvals) may be required to determine actual location of any and all utilities or property lines.	1.	NEW DRAWING.	AUG. 78	J. d.m.	APPROVED	VENTURE CRESCENT		CITY OF NORTH BAY ENGINEERING DEPARTMENT			
		2.	AS CONST INVERTS ON SAN. EXTENSION	MAR. 79	A.P.		SEYMOUR ST. to PROGRESS CT.					
		3.	REVISION TO ENTERANCE LOCATIONS.	MAR. 79	A.P.		Reg'd Plan 36R-4810 M - 519					
		4.	€ PROFILE (approx.) Removed Postal Station	May 80	J. d.m.				SCALE: AS SHOWN	DATE: AUG. 78		
		5.	Added 36R-12865	Jun/10	C.W.C.				DRAWN BY: J. d.m. C.W.C. BY:	FIELD BOOK No. 250	DRAWING No. V-126	REV.