
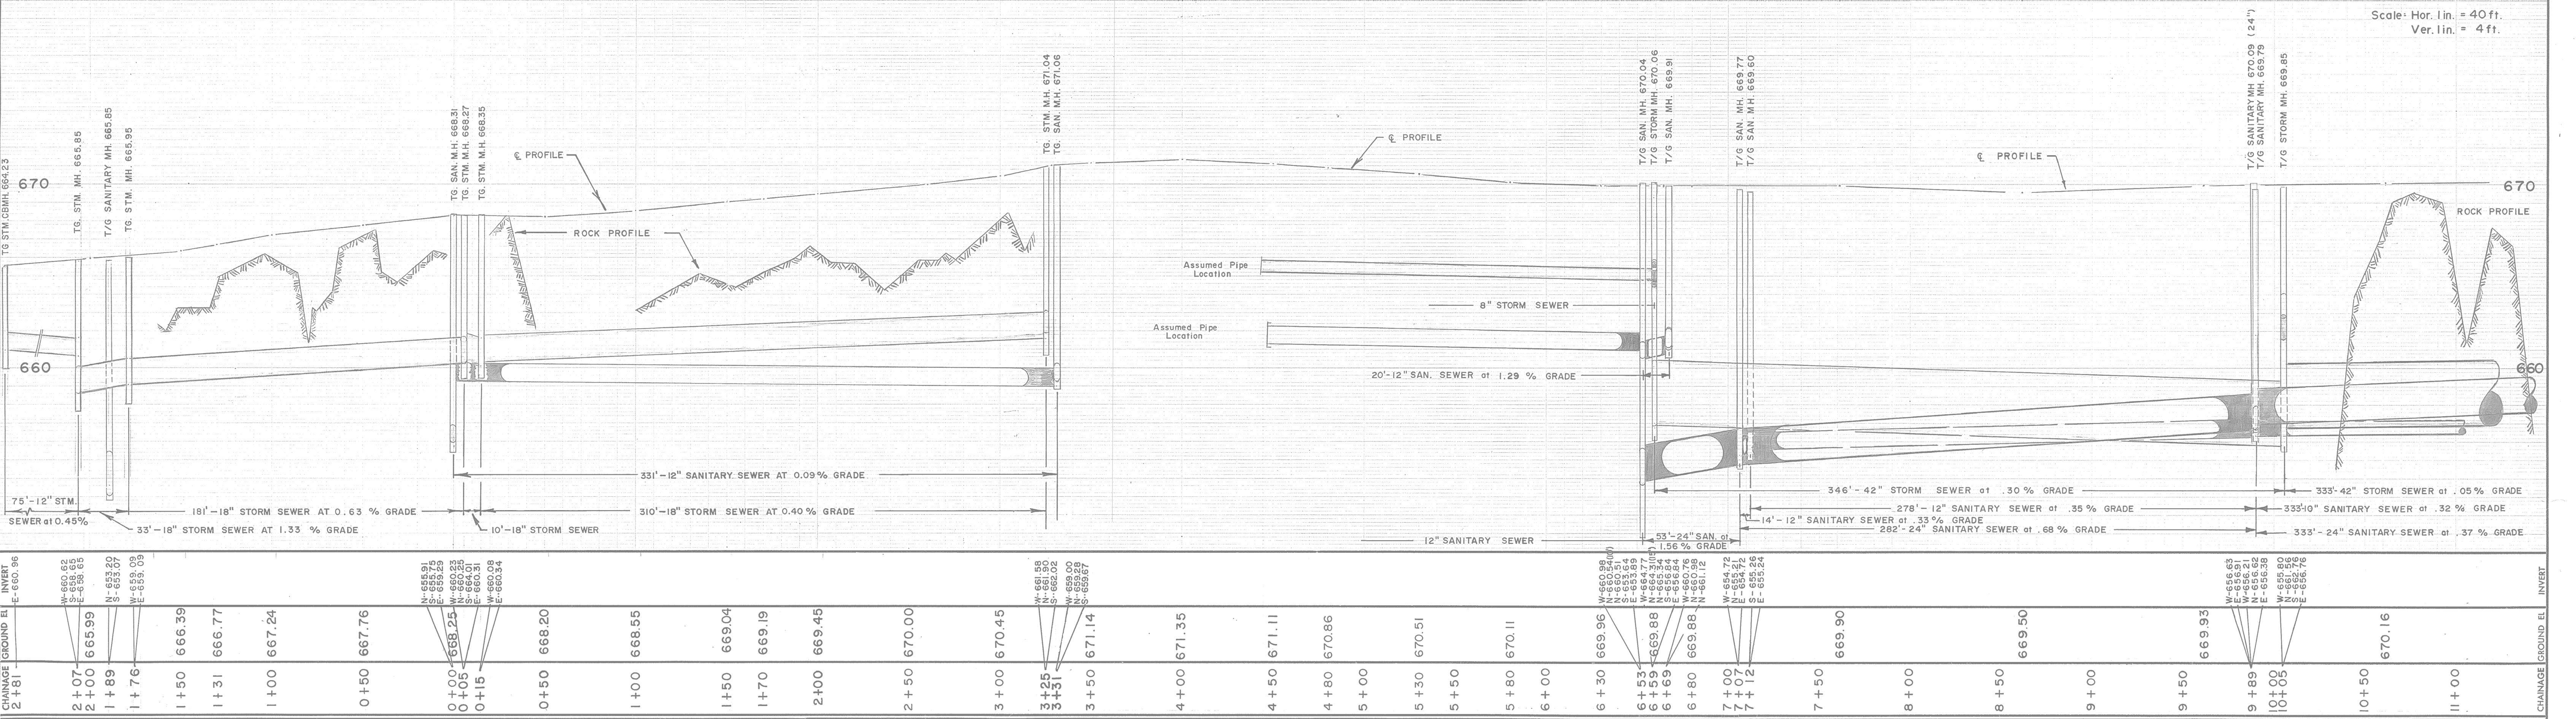


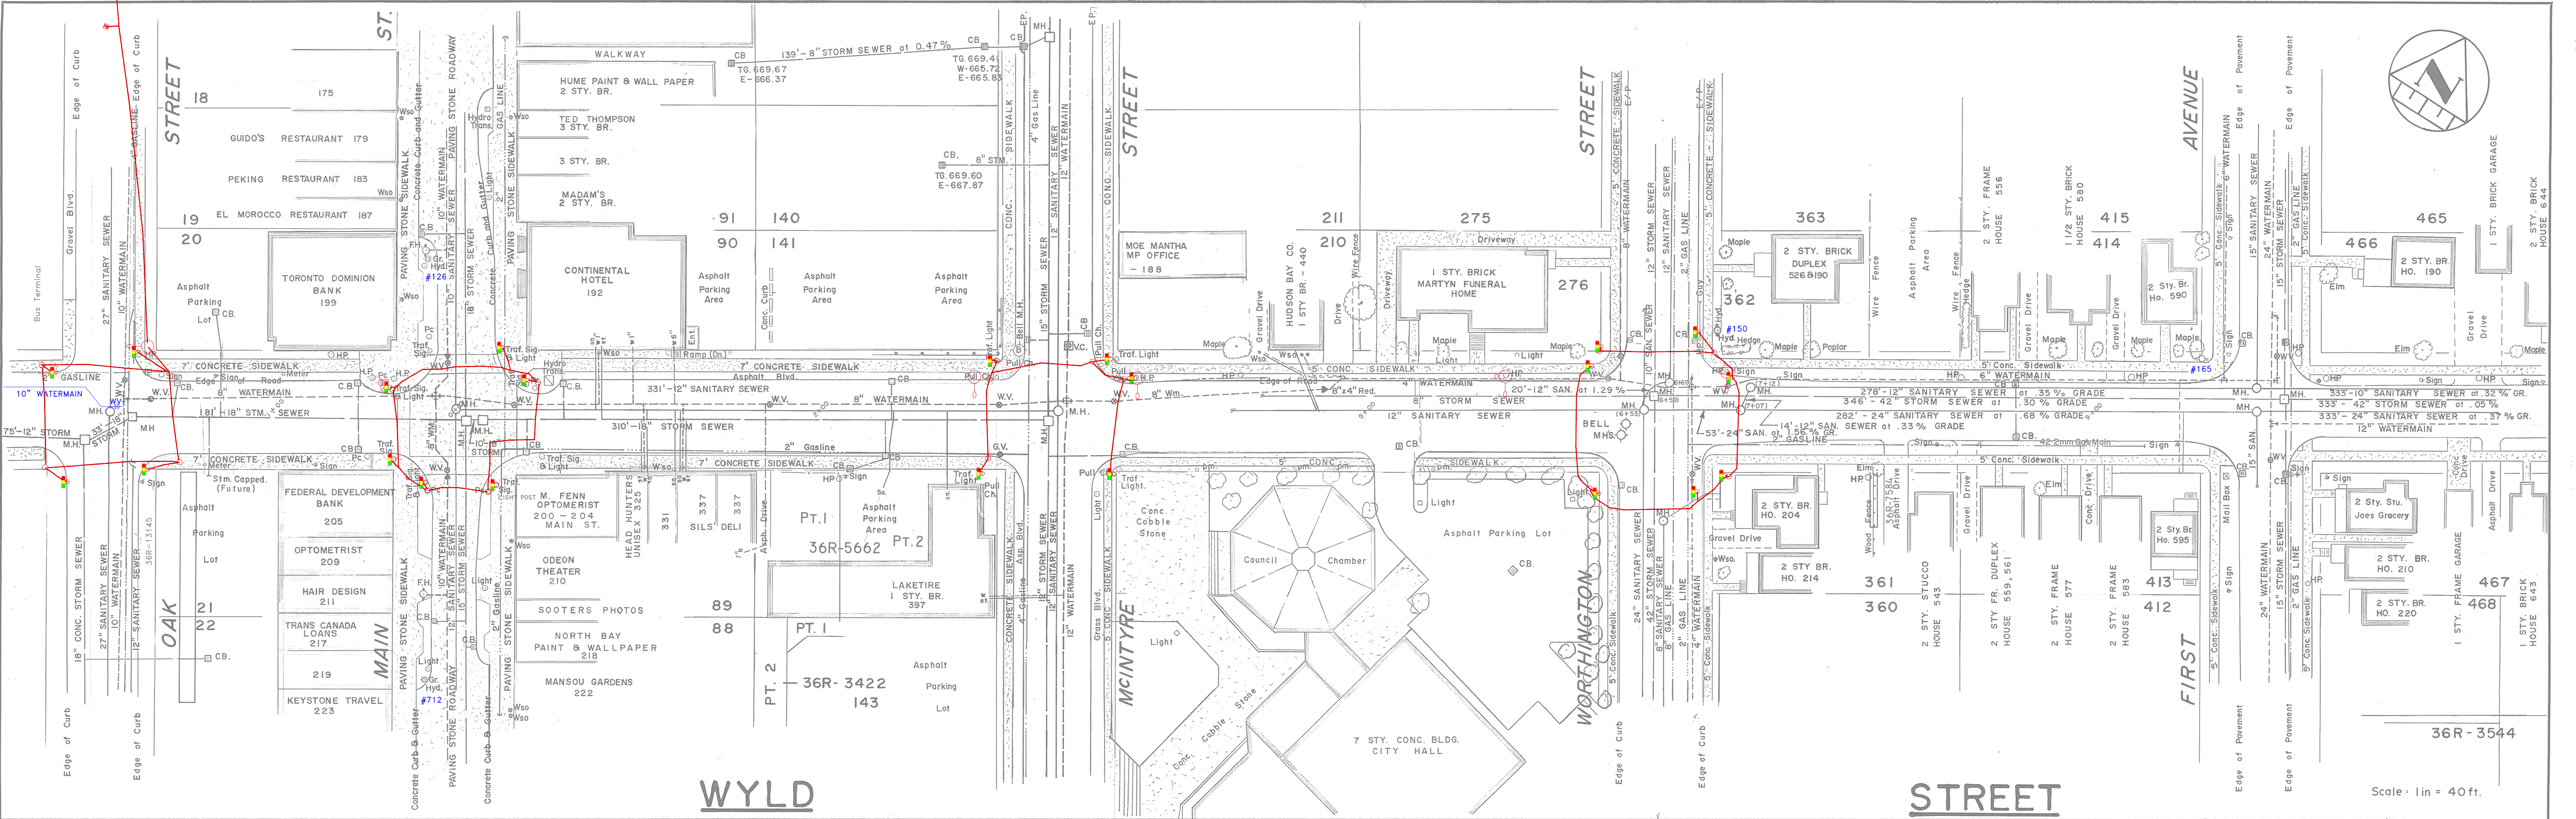

DATE: 10-10-2023	NOTES:		8. UPDATE OAK to MCINTYRE		NOV. 85 J.S.		1. NEW DRAWING		Mar 76 j.d.m.		APPROVED	WYLD STREET		CITY OF NORTH BAY ENGINEERING DEPARTMENT		SCALE: AS SHOWN DATE: MAR. 1976		DRAWN BY: j.d.m. CK'D BY:		FIELD BOOK No. 215, 232, 246 213, 187.		DRAWING No. W-26		REV.	
	DISCLAIMER		9. AS CONST. I13-82 OAK to MCINTYRE BK. 266-Align. 282-Elev.		NOV. 87 Rick B.		2. 6 PROFILE (Worthington St. east)		June 76 j.d.m.			OAK STREET To FIRST AVENUE													
	The information contained on this drawing may be based upon data provided by others and may not have been verified by either as-constructed drawings or an Ontario Land Surveyor. The City of North Bay cannot accept responsibility for any errors or omissions on any information shown herein. Field verification, land surveys or excavation (with City approvals) may be required to determine actual location of any and all utilities or property lines.		10. Updated Water at Oak Street		NOV 09 G.W.C.		3. McIntyre to Worthington Revision to Road Location.		Oct. 80 j.d.m.			Reg'd Plan No's: 10, 21 & 38													
			11. Added 36R-13145		October '11 G.W.C.		4. 6 PROFILE OAK to WORTHINGTON		DEC. 80 j.d.m.			36R-3422, 36R-3544													
			U/G Hydro traffic lights (approx)		Nov.2020 rjo		5. REVISED Road Detail Worthington to Oak Bk.262.		APR. 82 Rick B.																
								6. 6 PROFILE OAK to MCINTYRE		DEC. 82 J.S.															
								7. Revised Curb detail at Main St.		FEB. 84 J.S.															
				No.		REVISION		DATE		INITIAL		No.		REVISION		DATE		INITIAL							