


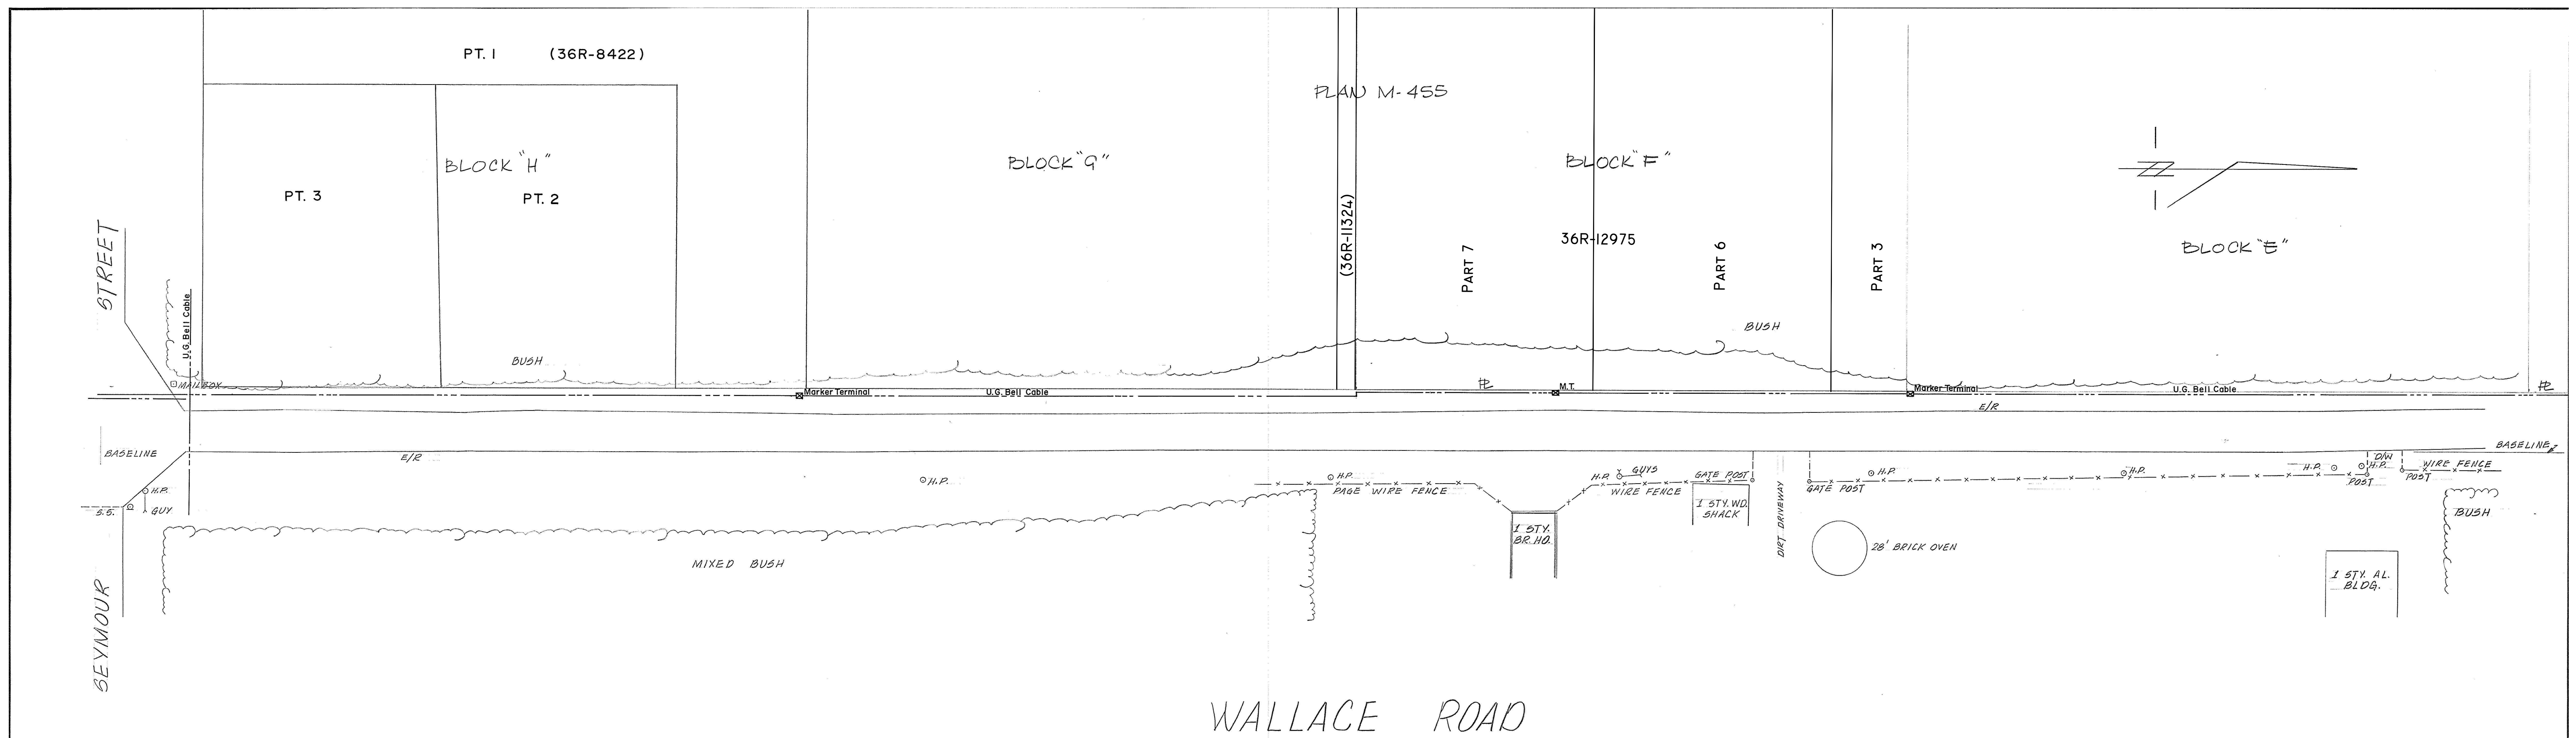

NOTES: DISCLAIMER The information contained on this drawing may be based upon data provided by others and may not have been verified by either as-constructed drawings or an Ontario Land Surveyor. The City of North Bay cannot accept responsibility for any errors or omissions on any information shown herein. Field verification, land surveys or excavation (with City approvals) may be required to determine actual location of any and all utilities or property lines.	I.	ADDED 36R-12975	DEC'10	G.W.C.	APPROVED	WALLACE ROAD SEYMOUR STREET 1300 FT. NORTHERLY	CITY OF NORTH BAY			
							ENGINEERING DEPARTMENT			
							SCALE: AS SHOWN DATE: AUG. 16, 1971			
							DRAWN BY: J.M.	FIELD BOOK NO. # 210	DRAWING NO. W-326	REV.
		No.	REVISION	DATE	INITIAL					