

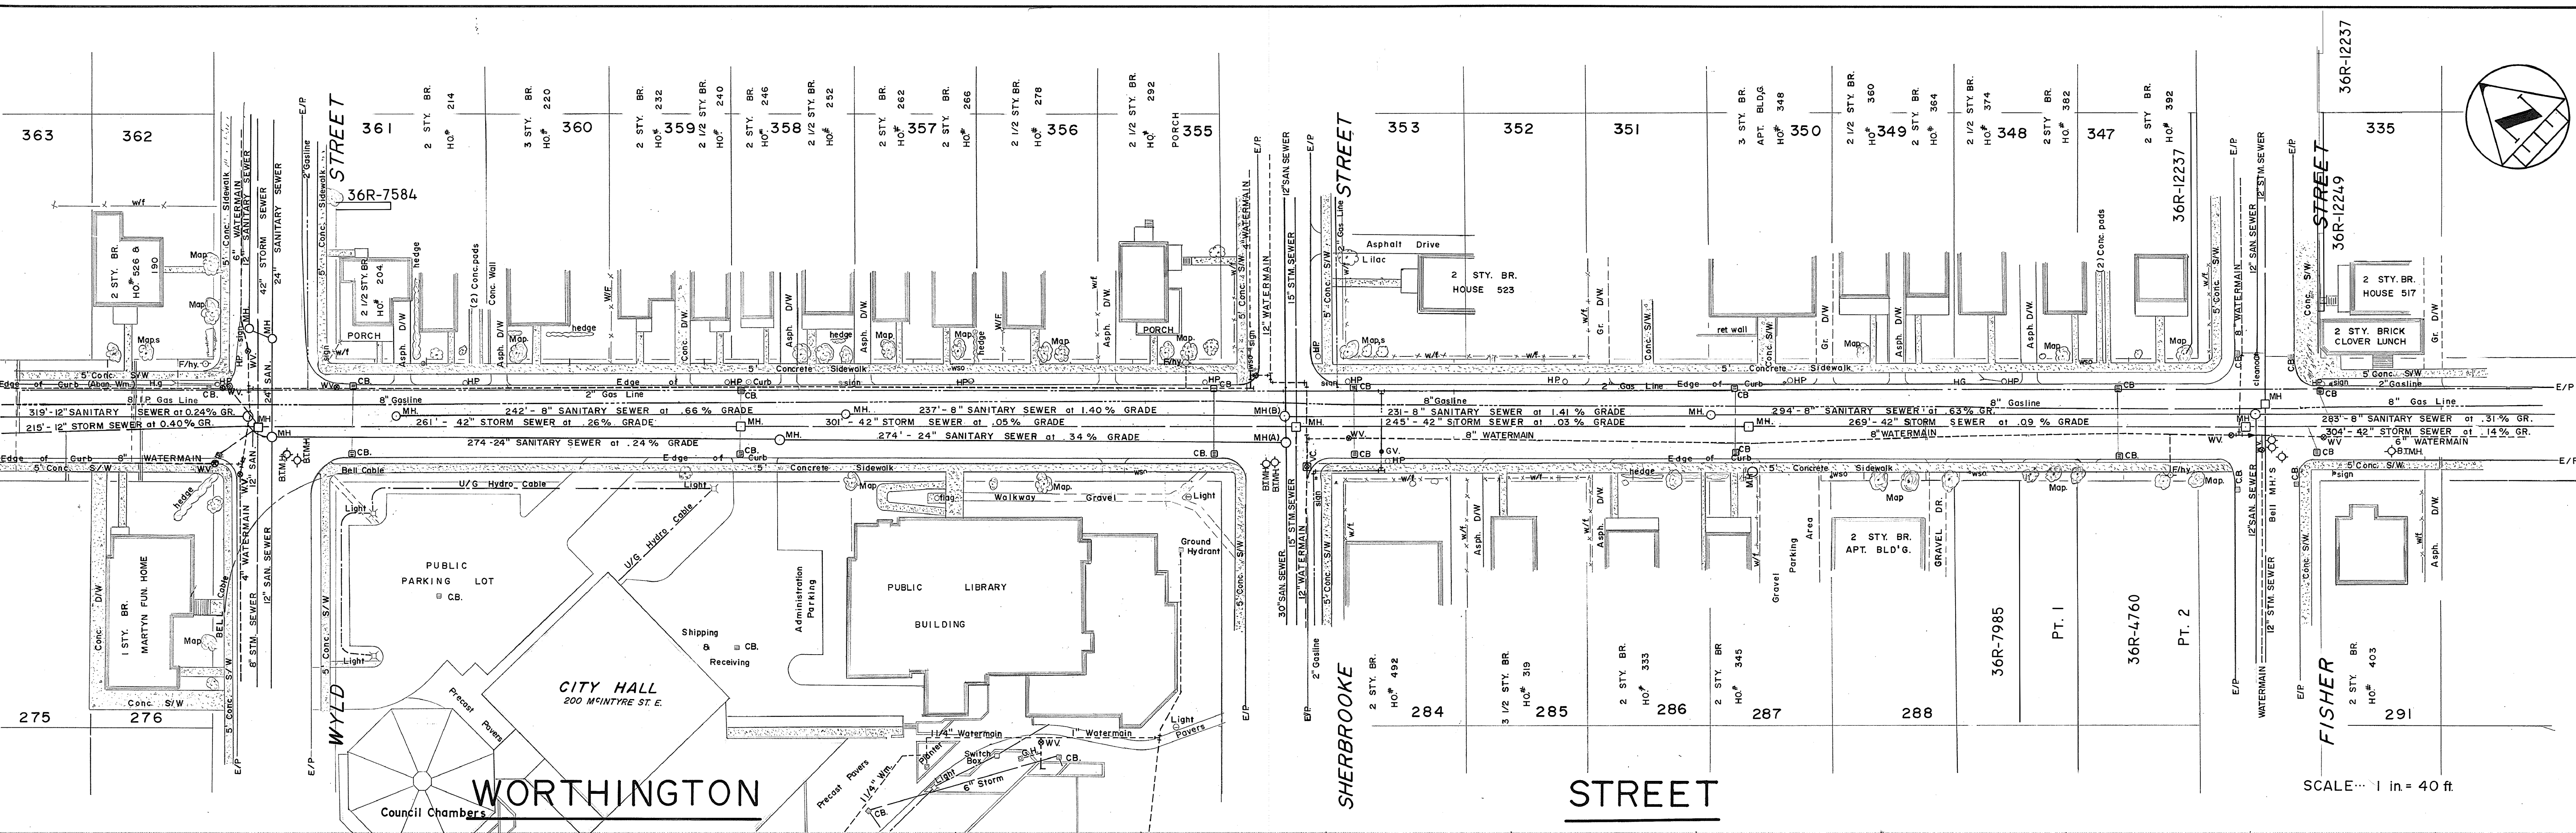


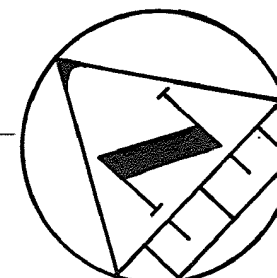

SCALE 1 in. = 40 ft.

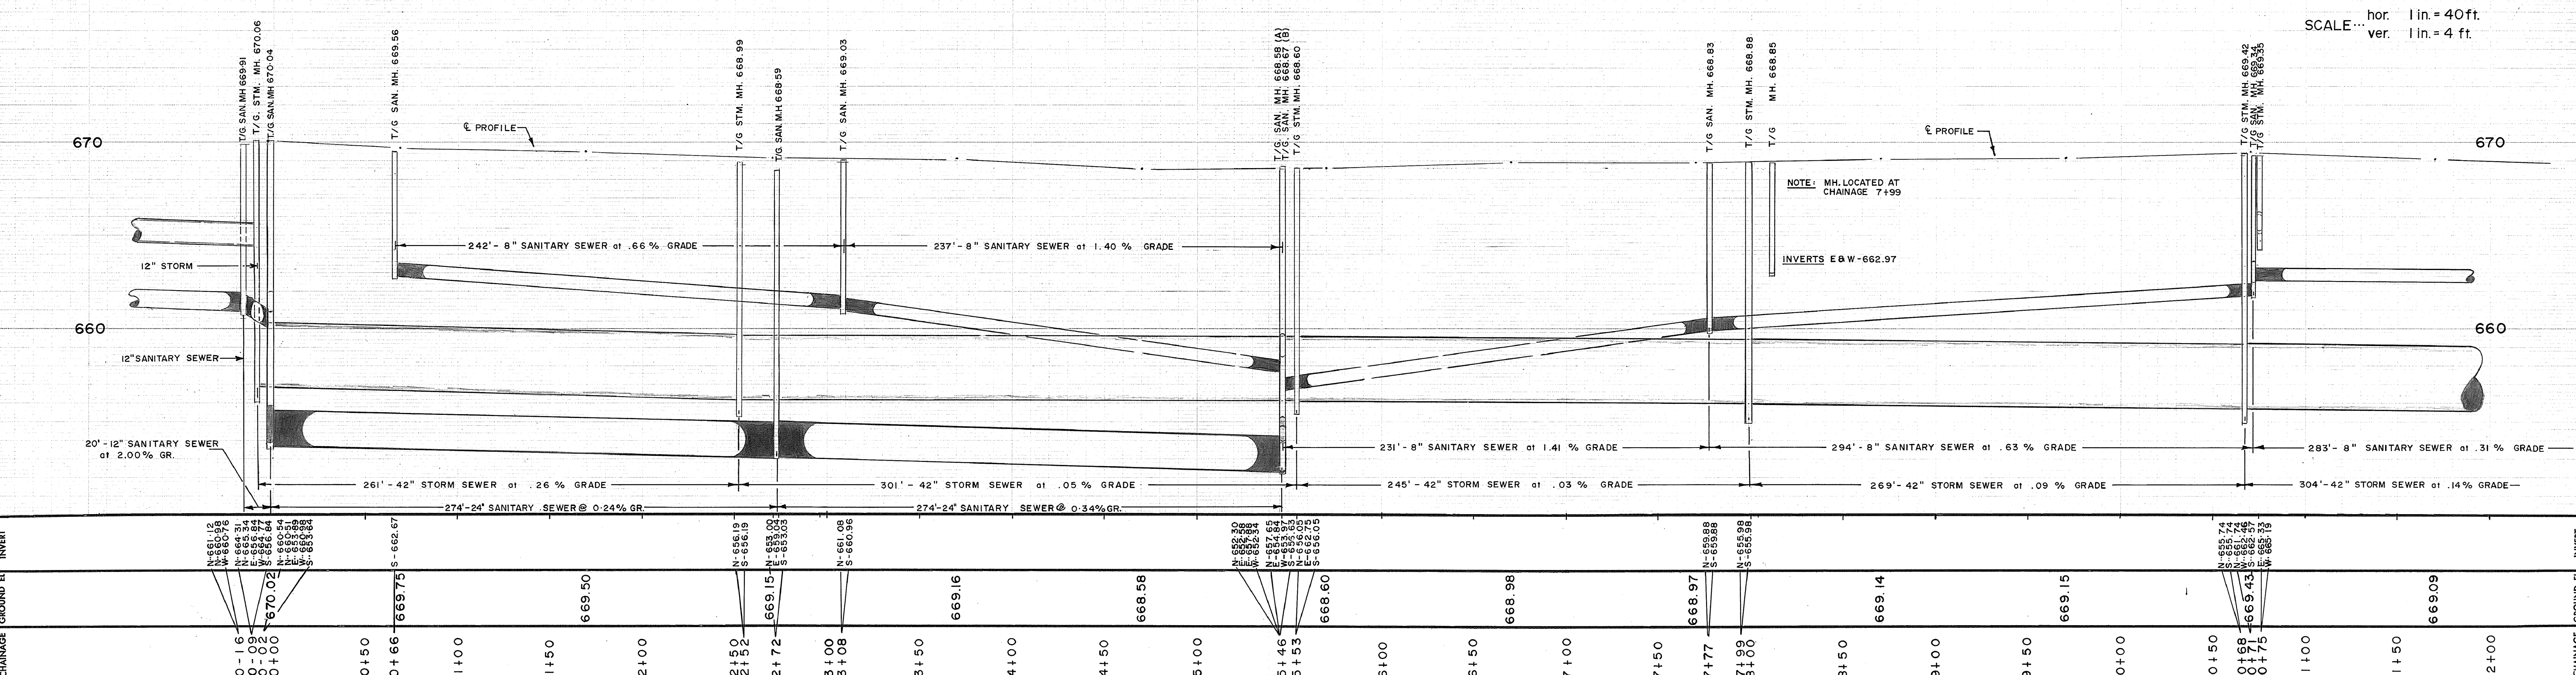

SCALE hor. 1 in. = 40 ft.
ver. 1 in. = 4 ft.

NOTES:

DISCLAIMER

The information contained on this drawing may be based upon data provided by others and may not have been verified by either as-constructed drawings or an Ontario Land Surveyor. The City of North Bay cannot accept responsibility for any errors or omissions on any information shown herein. Field verification, land surveys or excavation (with City approval) may be required to determine actual location of any and all utilities or property lines.

CITY OF NORTH BAY

ENGINEERING DEPARTMENT

SCALE: AS SHOWN

DATE: JULY, 1973

DRAWN BY: *WLB*

FIELD BOOK No. 186, 228

CDP. BY: 232

DRAWING No. W-354

REV.

No.	REVISION	DATE	INITIAL
1.	NEW DRAWING	30/7/73	<i>WLB</i>
2.	16" Wm. To 8" Wm. FISHER & WORTHINGTON ST'S	AUG. 74	<i>WLB</i>
3.	SERVICE CONNECTIONS	APR /75	<i>WLB</i>
4.	ADDED 12" Wm. & 4" Wm. @ SHERBROOKE & WORTHINGTON	OCT. 75	A.P.
5.	AS CONSTRUCTED STM., SAN., & WATERMAIN	APR. 76	Jdm.
6.	REVISED NW CORNER FISHER & WORTHINGTON	MAY 82	J.S.

APPROVED

REG.D. PLAN No. 10, & 21.

WORTHINGTON STREET

WYLD STREET TO FISHER STREET