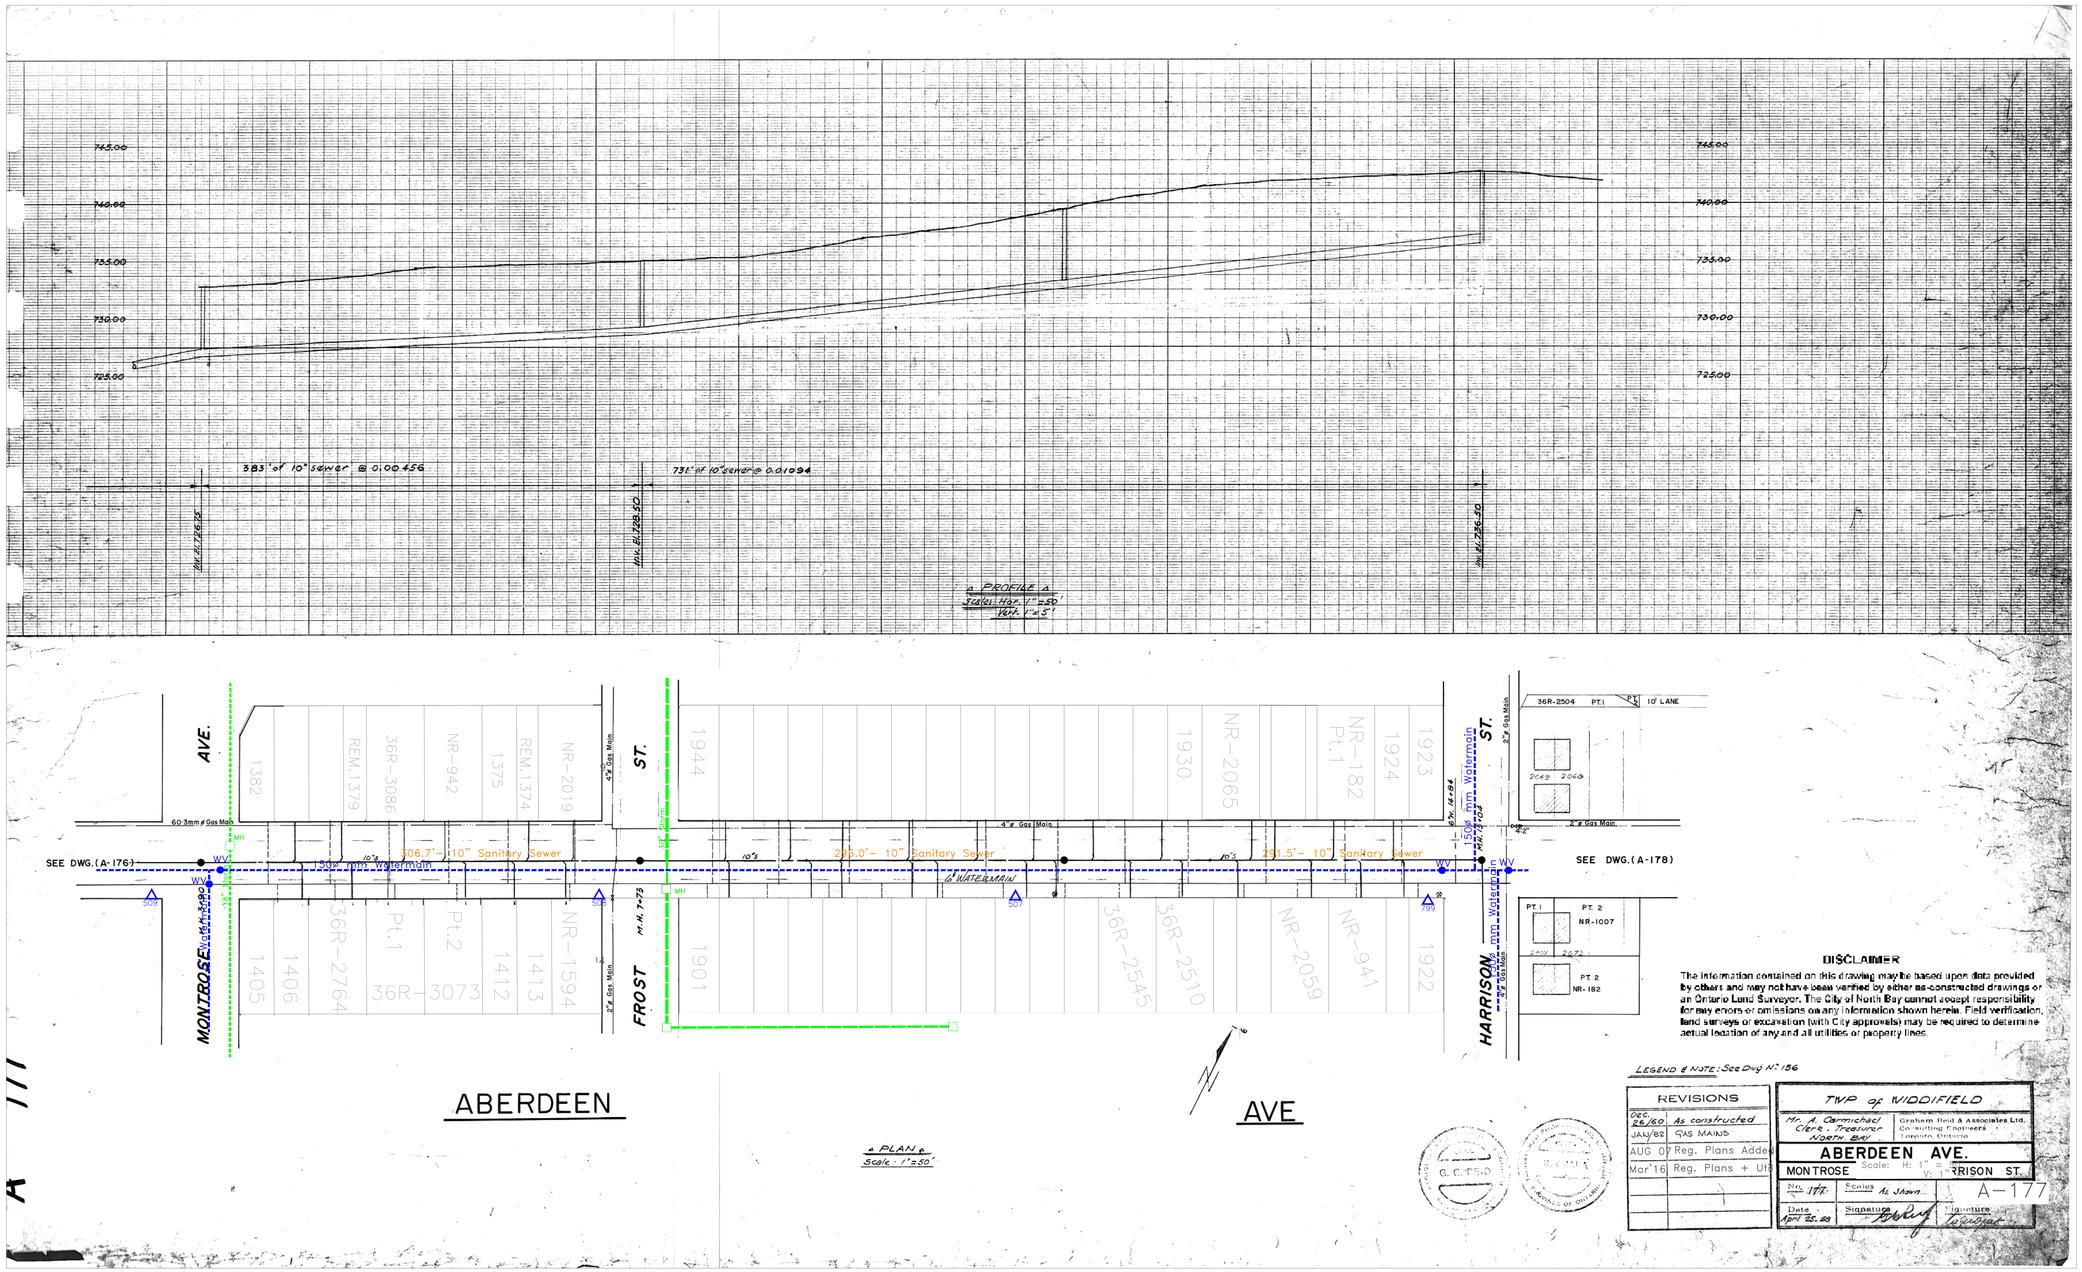

DISCLAIMER

The information contained on this drawing may be based upon data provided by others and may not have been verified by either as-constructed drawings or an Ontario Land Surveyor. The City of North Bay cannot accept responsibility for any errors or omissions on any information shown herein. Field verification, land surveys or excavation (with City approvals) may be required to determine actual location of any and all utilities or property lines.

LEGEND & NOTE: See Dwg No. 156

REVISIONS	
Dec. 26/60	As constructed
JAN/82	GAS MAINS
AUG 07	Reg. Plans Added
Mar'16	Reg. Plans + Utl

TWP of WIDDIFIELD

Mr. A. Carmichael
Clerk - Treasurer
North Bay

Graham Reid & Associates Ltd.
Consulting Engineers
Toronto, Ontario

ABERDEEN AVE.

MONTROSE — Scale: H: 1" = 50' V: 1" = 5' — HARRISON ST.

No. 177 — Scales As Shown — A-177

Date April 25, 89 — Signature — Signature