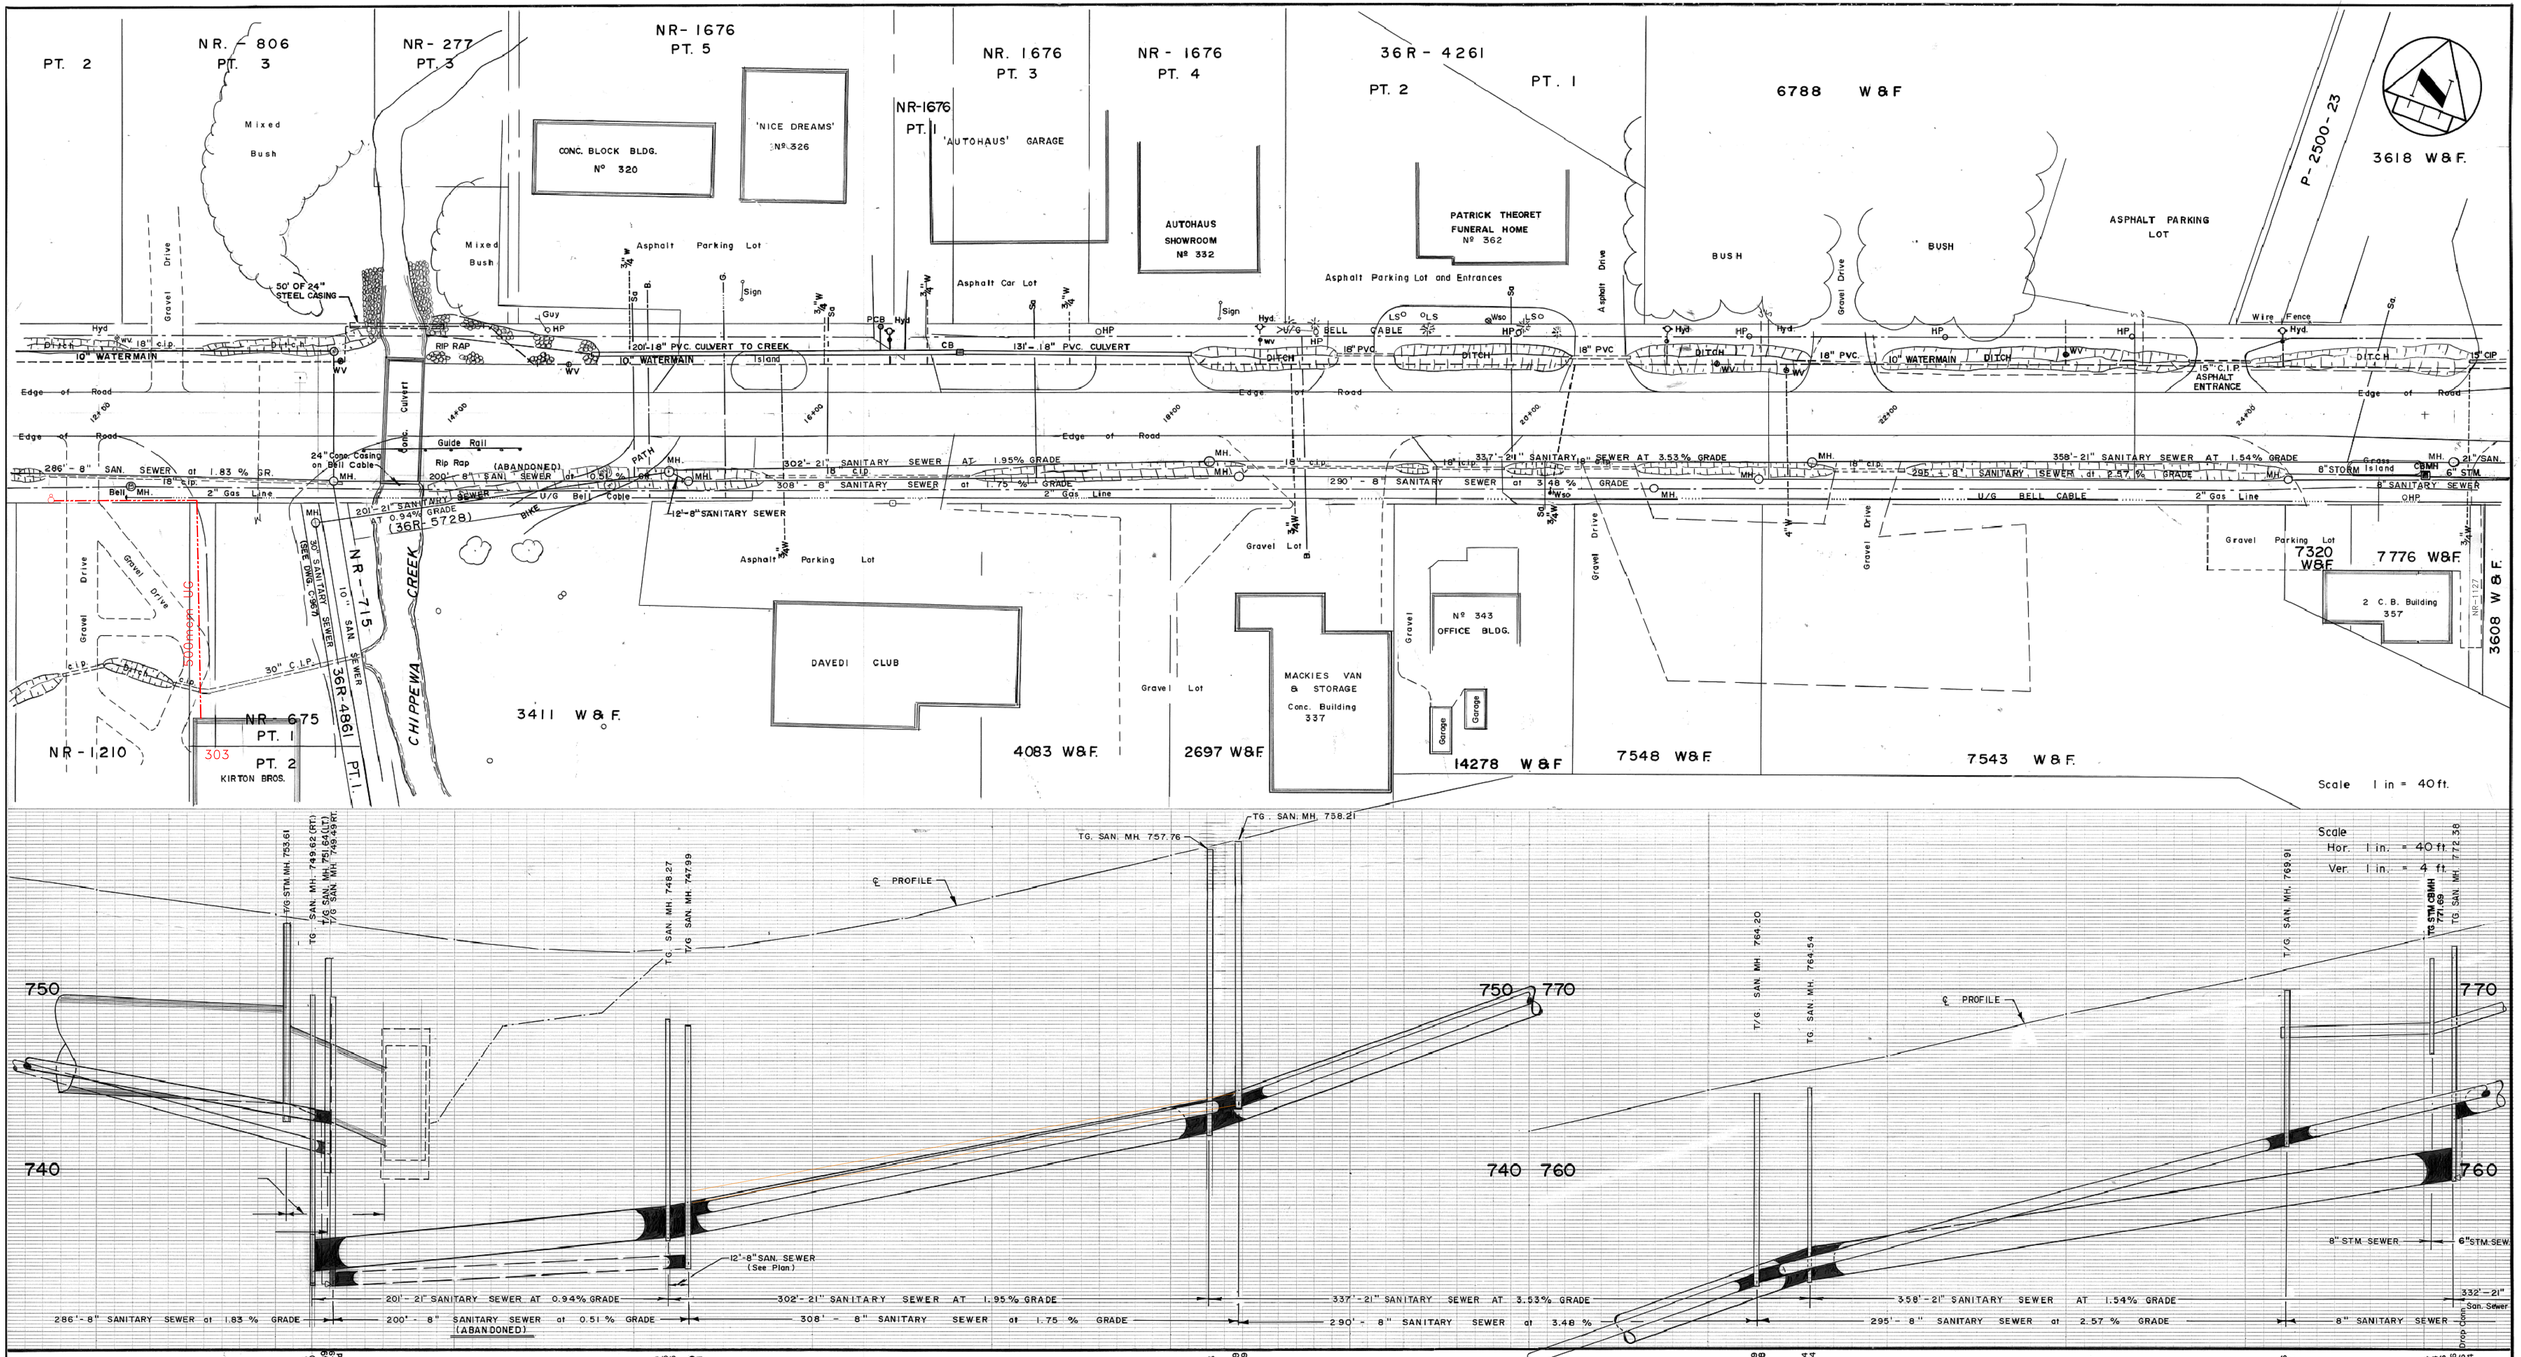

CHAINAGE	GROUND EL.	INVERT
12+00	755.5	
13+00	754.1	
13+23		S- 733.76 E- 734.10
13+33		S- 733.49 W- 733.49 E- Plugged
14+00	752.7	
15+00	752.1	
15+19		W- 736.19 E- 736.35
15+31		E- 736.15 NW- 737.99 W- Plugged
16+00	753.0	
17+00	755.1	
18+00	757.4	
18+21		W- 742.01 E- 742.06
18+38		W- 743.39 E- 743.49
19+00	759.8	
20+00	762.1	
21+00	764.4	
21+28		W- 753.59 E- 753.78
21+58		W- 753.94 E- 753.94
22+00	766.3	
23+00	768.6	
24+00	770.6	
24+23		W- 761.36 E- 761.41
25+00	772.8	W- 767.54
25+03		S- 767.44
25+17		W- 767.36 E- 759.56 E- 762.94

DISCLAIMER

The information contained on this drawing may be based upon data provided by others and may not have been verified by either as-constructed drawings or an Ontario Land Surveyor. The City of North Bay cannot accept responsibility for any errors or omissions on any information shown herein. Field verification, land surveys or excavation (with City approvals) may be required to determine actual location of any and all utilities or property lines.

NORTH BAY ONTARIO CANADA Just North Enough to be PERFECT

No.	REVISION	DATE	INITIAL
1.	Update Detail at Creek	JUNE 80	R.F.B.
2.	Location of 2" Gas Line.	FEB. 81	A.P.
3.	AS CONST'D. SAN. SEWER APR. 81 BK. 260	AUG. 81	R.F.B.
4.	AS CONST'D. ℄ PROFILE (MTC CONT. 66-219)	JUNE '94	P.L.C.
5	AS CONST'D WATERMAIN (CAD\ENG\AIR-OBR)	MARCH. 95	R.T.
6	CORRECT PROFILE GRADE ON 8" SANITARY SEWER	OCT. 2008	P.L.C.
7.	U.G. Hydro service	Mar. 2018	r.j.o.

APPROVED

AIRPORT ROAD

CHIPPEWA CREEK to 400' WEST of O'BRIEN ST.

CITY OF NORTH BAY

ENGINEERING DEPARTMENT

SCALE: AS SHOWN DATE: MAY. 1979

DRAWN BY: J.d.M. CK'D. BY:

FIELD BOOK No.

DRAWING No. A-252

REV.