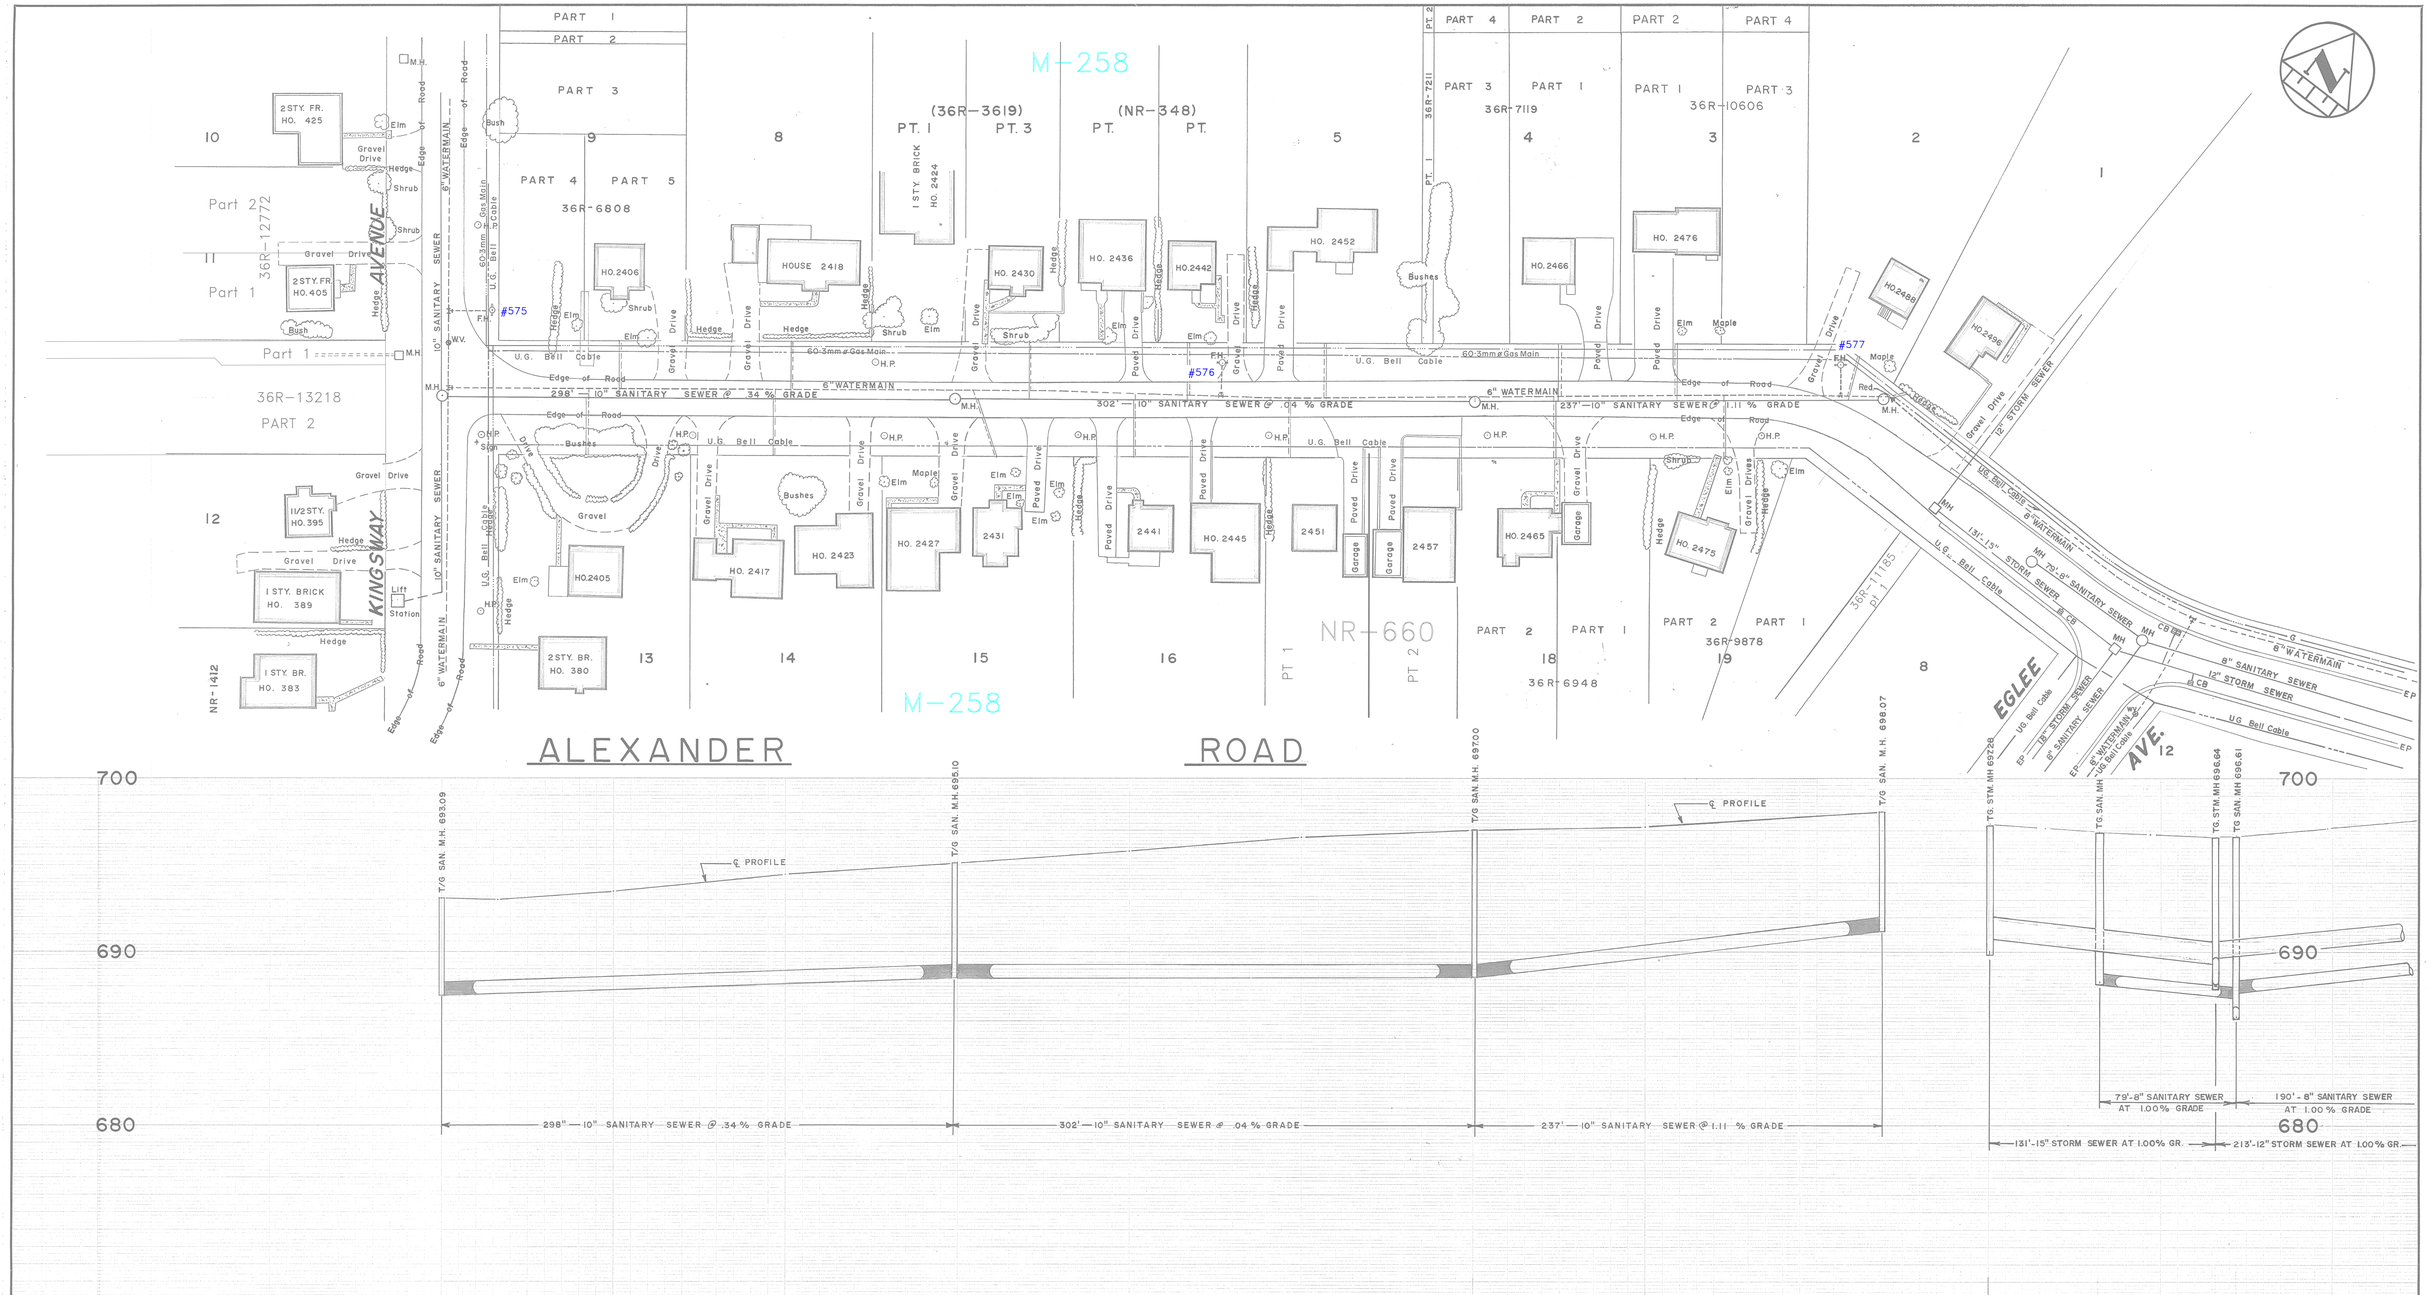

CHAINAGE	GROUND El.	INVERT
0+00	693.09	E-687.26 E-687.43
1+00	693.50	
2+00	694.40	
2+98	695.10	W-688.44 E-688.44
4+00	695.80	
5+00	696.60	
6+01	697.00	W-688.56 E-688.56
7+00	697.20	
8+00	697.80	
8+38	698.07	W-691.20
	697.28	N-691.36 E-690.70
	696.92	E-688.09
	696.64	W-689.38 S-687.31 E-689.63
	696.52	W-687.30 S-685.09 E-687.66

DWG. No.

NOTES:

DISCLAIMER

The information contained on this drawing may be based upon data provided by others and may not have been verified by either as-constructed drawings or an Ontario Land Surveyor. The City of North Bay cannot accept responsibility for any errors or omissions on any information shown herein. Field verification, land surveys or excavation (with City approvals) may be required to determine actual location of any and all utilities or property lines.

No.	REVISION	DATE	INITIAL
1.	NEW DRAWING (Detail from M.T.C. Topo.)	FEB./77	A.P.
2.	60.3mm GAS MAINS	JAN/82	B.D
3.	U.G. Bell Cable.	MAY 82	A.P.
4	AS CONST. EGLEE AVE. INTERSECTION SEE DWG. A-277	OCT 94	R.T
5.	Registered Plans Added.	Aug 07	Rich O
6.	Registered Plan 36R-12772 Added.	Nov. 09	G.W.C.
7.	Registered Plan 36R-13218 Added.	Feb. 2012	G.W.C.

APPROVED

NORTH BAY ONTARIO-CANADA
Just North Enough to be PERFECT

ALEXANDER ROAD
KINGSWAY AVE. TO STEVENS ST.
REG'D PLAN Nº. M-258.

CITY OF NORTH BAY
ENGINEERING DEPARTMENT

SCALE: HOR. 1" = 40' VERT. 1" = 4'
DATE: FEB. / 77.

DRAWN BY: A.P.
CK'D. BY:
FIELD BOOK No.
DRAWING No. A-276
REV.