


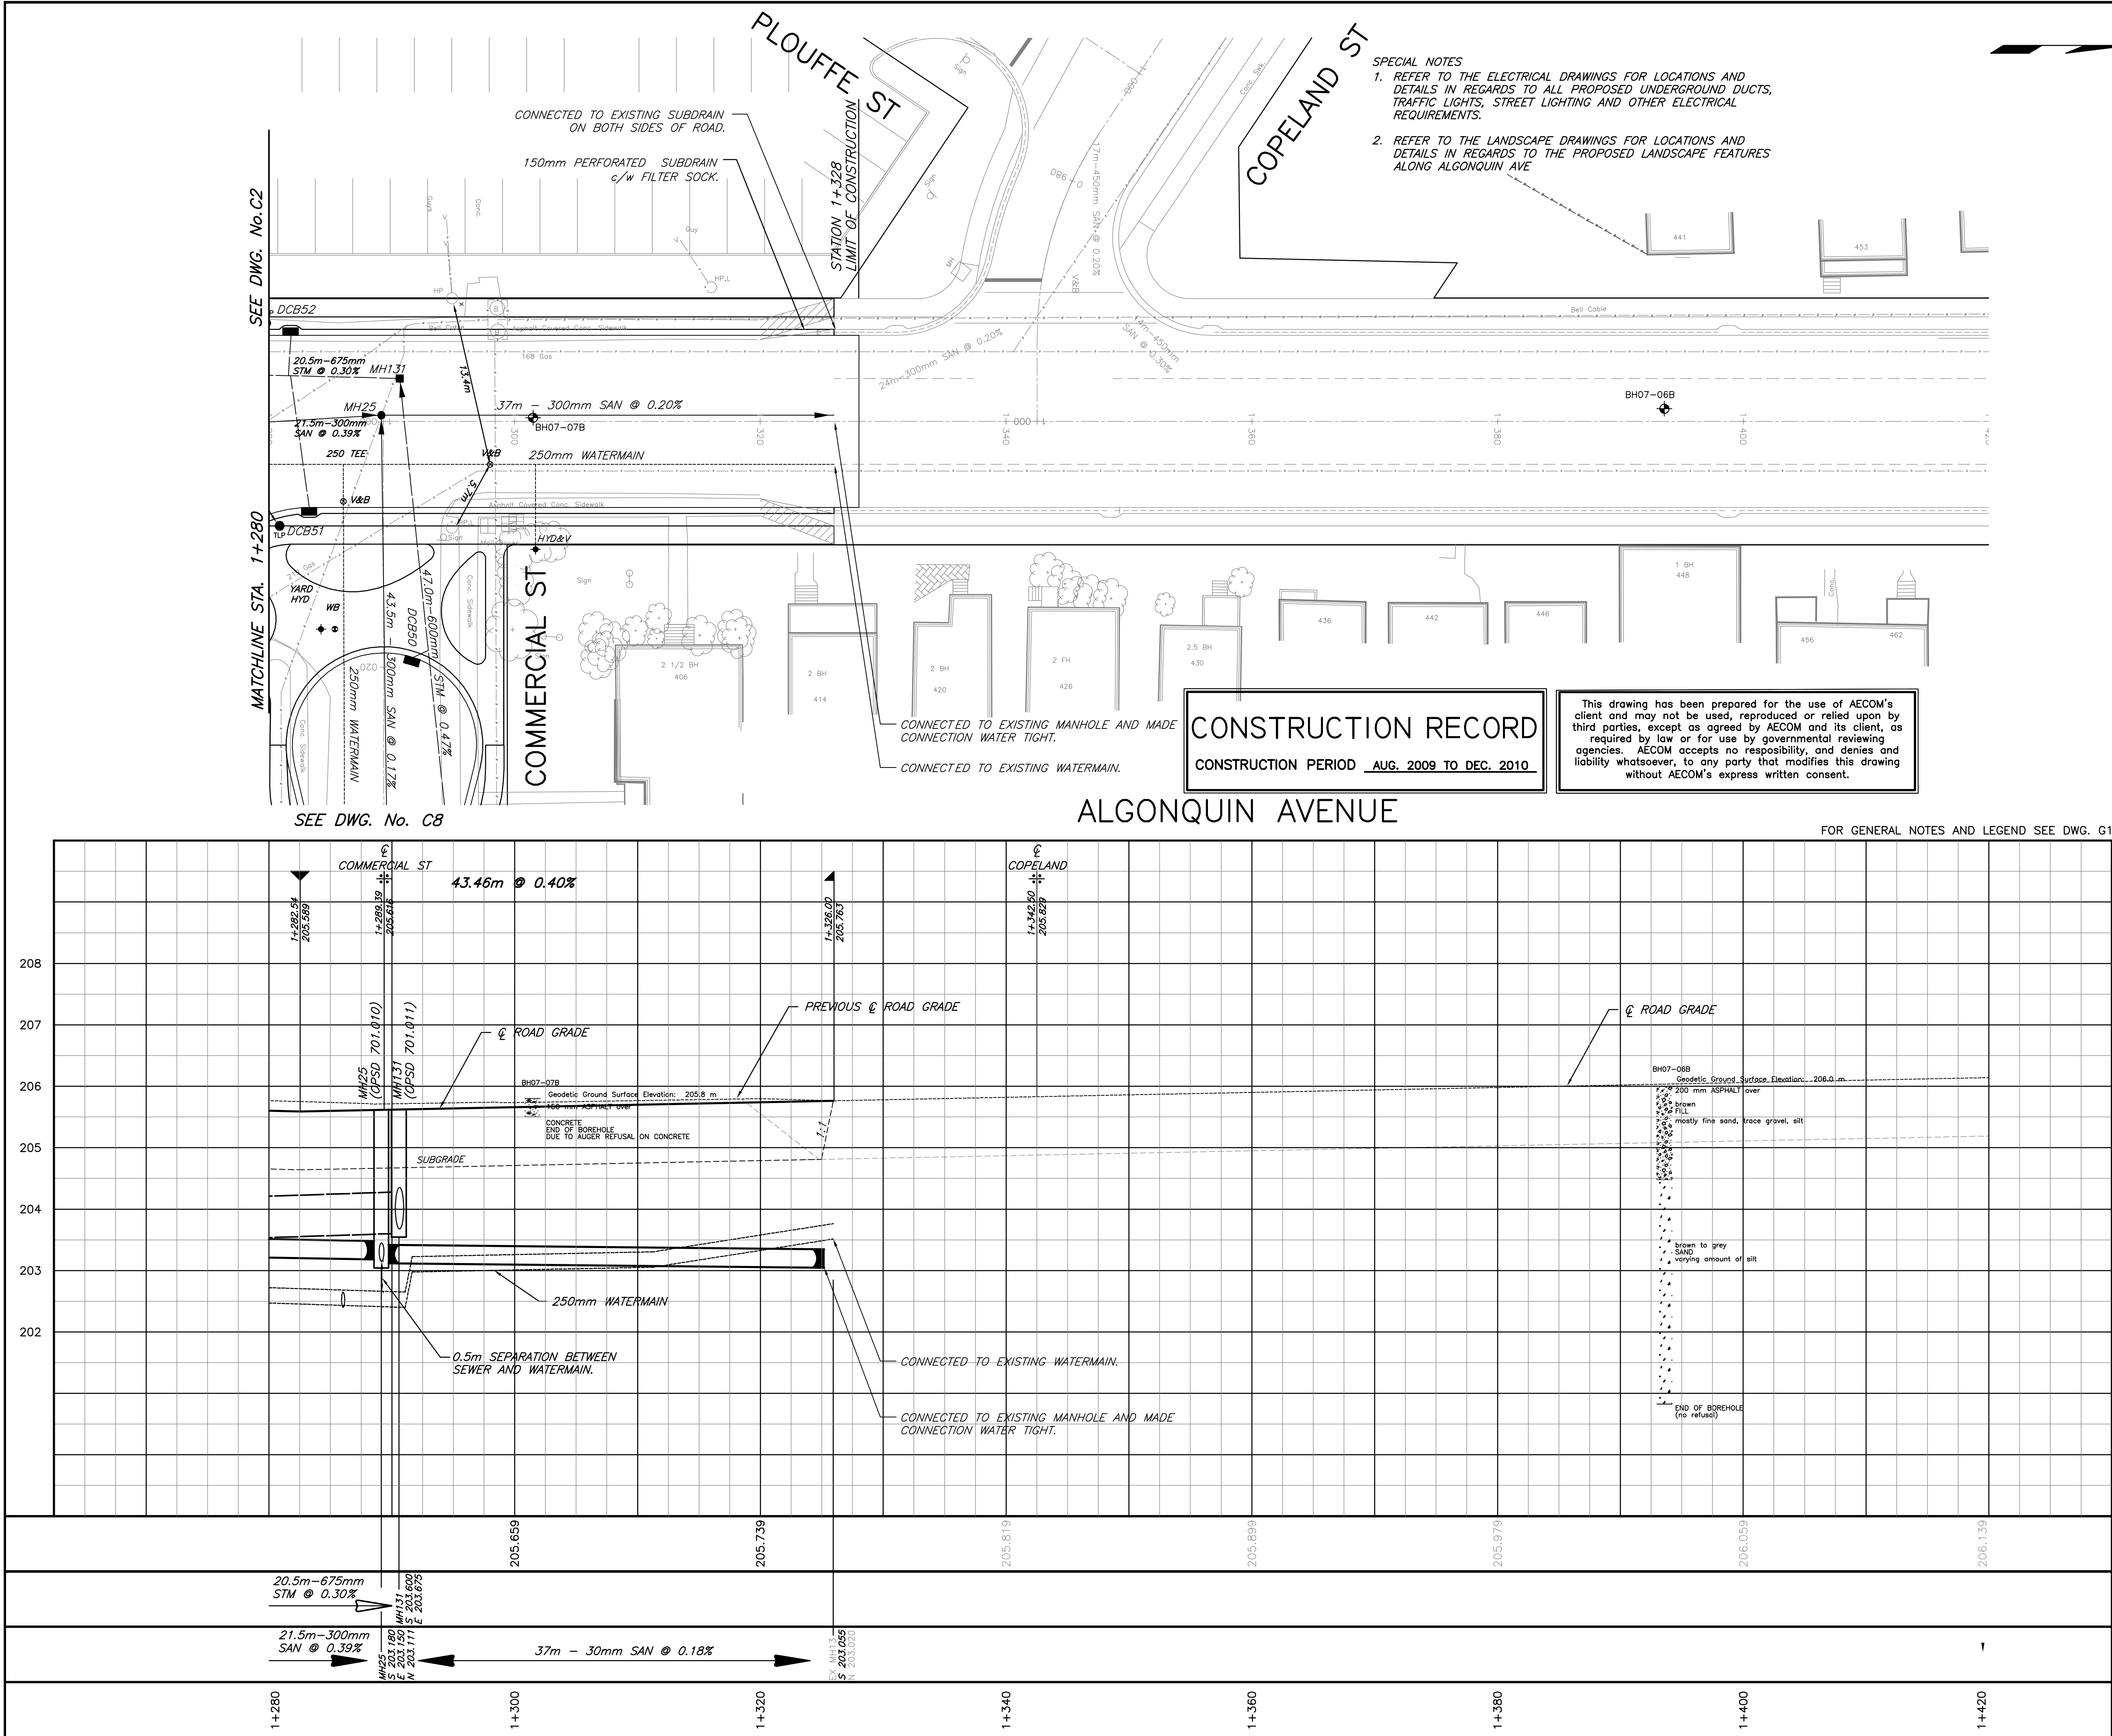

- SPECIAL NOTES
1. REFER TO THE ELECTRICAL DRAWINGS FOR LOCATIONS AND DETAILS IN REGARDS TO ALL PROPOSED UNDERGROUND DUCTS, TRAFFIC LIGHTS, STREET LIGHTING AND OTHER ELECTRICAL REQUIREMENTS.
 2. REFER TO THE LANDSCAPE DRAWINGS FOR LOCATIONS AND DETAILS IN REGARDS TO THE PROPOSED LANDSCAPE FEATURES ALONG ALGONQUIN AVE

CONSTRUCTION RECORD

CONSTRUCTION PERIOD AUG. 2009 TO DEC. 2010

This drawing has been prepared for the use of AECOM's client and may not be used, reproduced or relied upon by third parties, except as agreed by AECOM and its client, as required by law or for use by governmental reviewing agencies. AECOM accepts no responsibility, and denies and liability whatsoever, to any party that modifies this drawing without AECOM's express written consent.

designer G.Mc.	drawn by: G.Mc.		
checked by: B.M.	approved by: D.D.		
r e v i s i o n s			
no.	date	by	description
1	3 JUNE 2009	GM	ISSUED FOR PRELIMINARY REVIEW
2	19 JUNE 2009	GM	ISSUED FOR FINAL REVIEW
3	4 JULY 2009	GM	ISSUED FOR TENDER
4	31 MAR 2011	SD	CONSTRUCTION RECORD

The Corporation of the City of North Bay

Tender 2009-78

Algonquin Avenue and Area Road Reconstruction

ORIGINAL SIGNED BY:
D.R. DIETRICH
DATED JULY 02, 2009

CONSTRUCTION

ALGONQUIN AVE
STA. 1+270 TO STA. 1+420

scale H. 1:250 V. 1:50	
file reference 2862-A-11	drawing number A-77A
date MAR 2011	sheet number 21 of 52