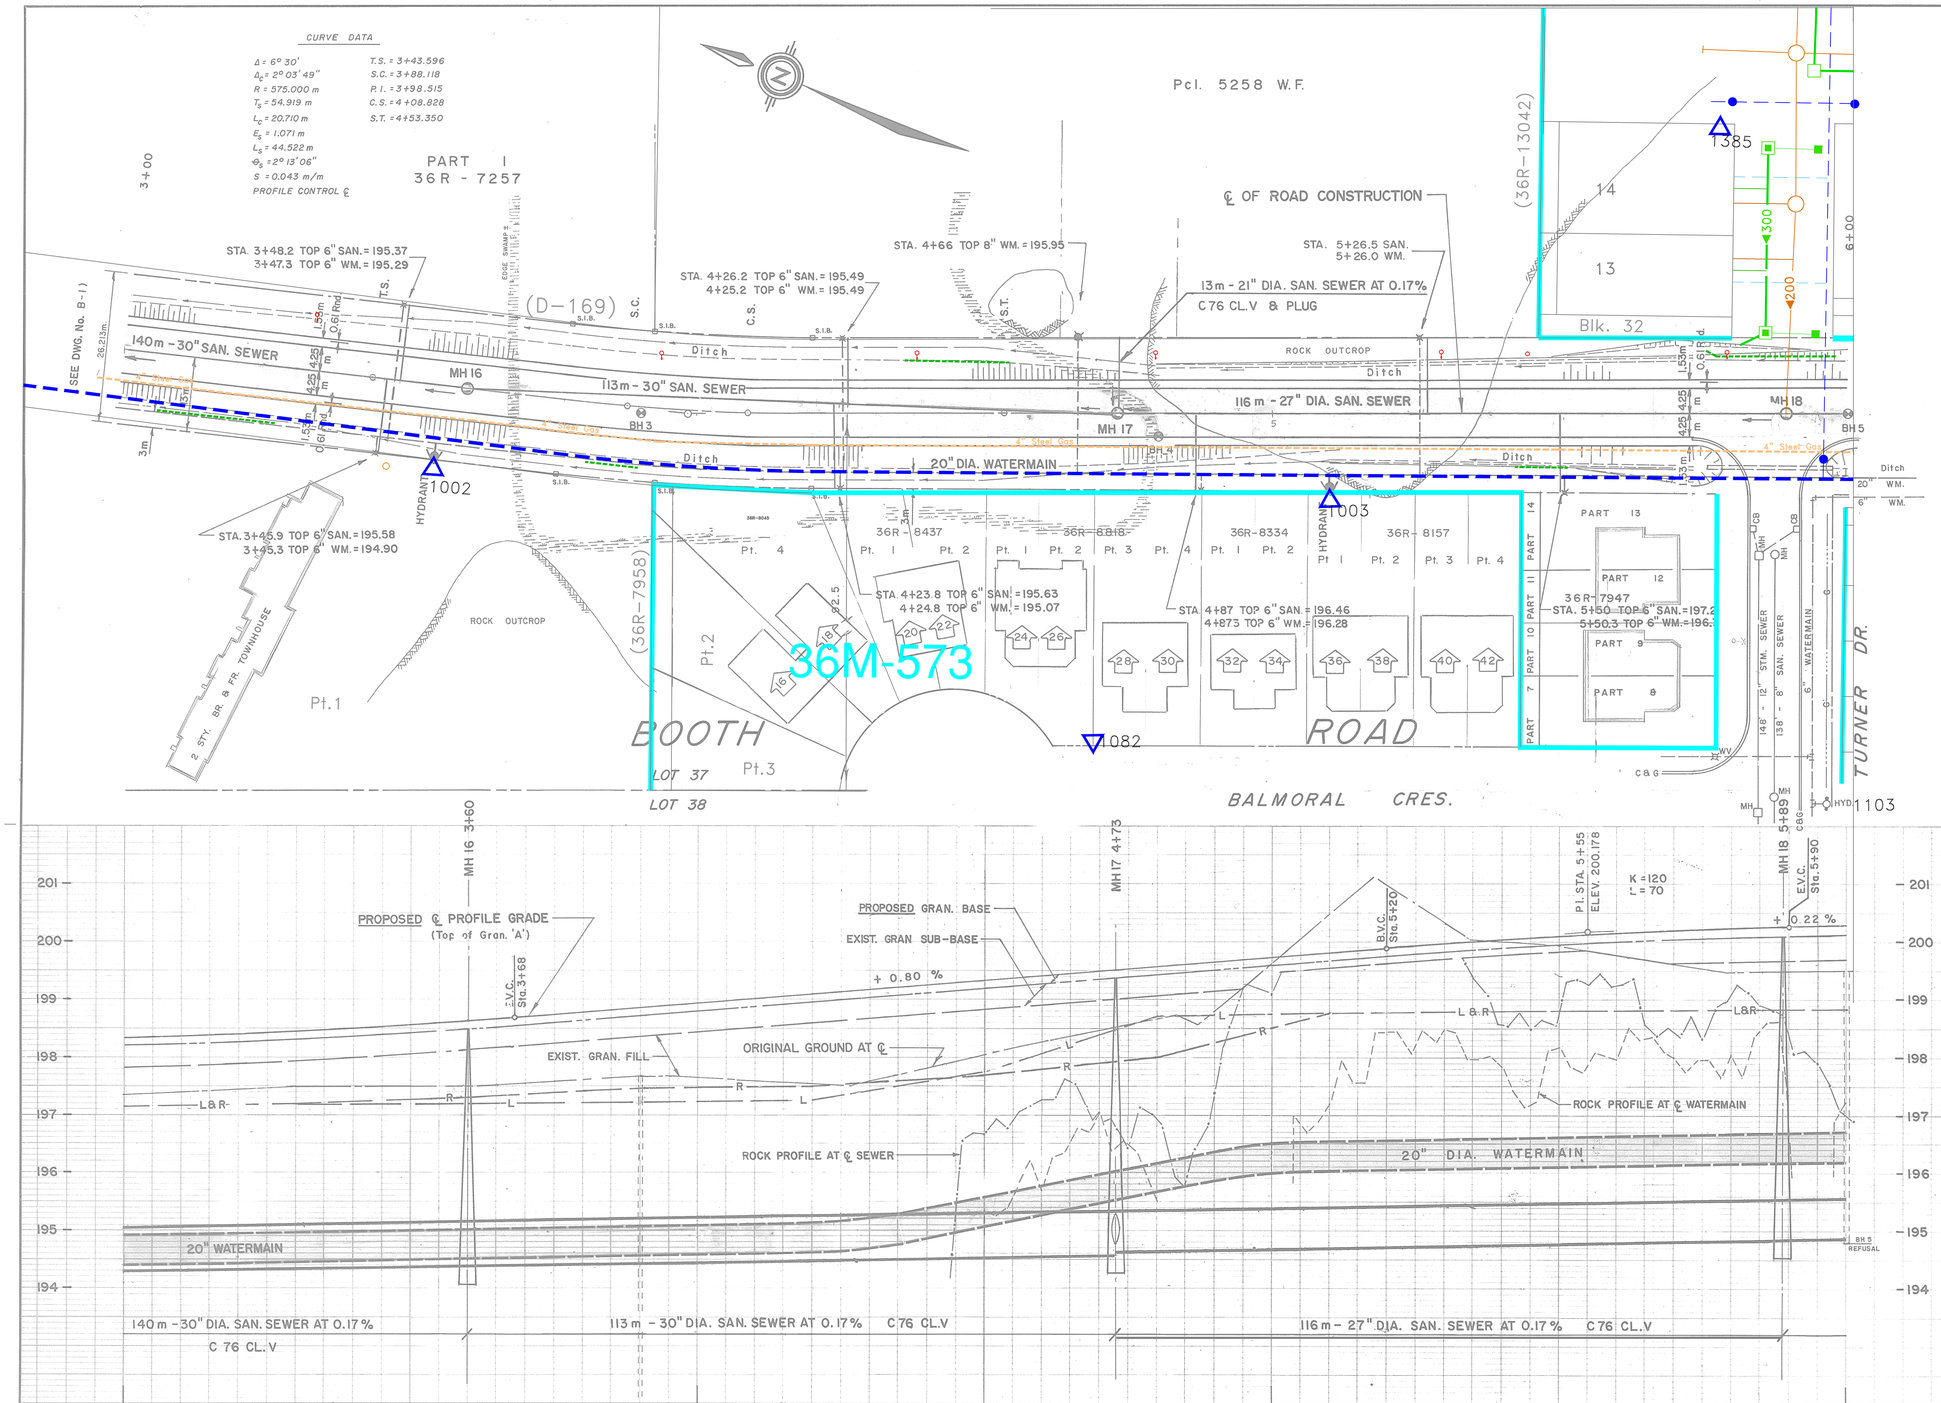

NOTES

1. SUBSOIL INVESTIGATION LOCATIONS ARE APPROXIMATE.
2. ALL UNDERGROUND UTILITIES ARE COMPLETE WITH THE EXCEPTION OF THE TOPS OF THE MANHOLES WHICH ARE TO BE ADJUSTED, UNDER THIS CONTRACT, TO SUIT THE FINAL PAVEMENT ELEVATIONS.
3. RIGHT OF WAY GRADING IS COMPLETE WITH THE EXCEPTION OF THE INSTALLATION OF THE GRANULAR BASE.

DISCLAIMER

The information contained on this drawing may be based upon data provided by others and may not have been verified by either as-constructed drawings or an Ontario Land Surveyor. The City of North Bay cannot accept responsibility for any errors or omissions on any information shown herein. Field verification, land surveys or excavation (with City approvals) may be required to determine actual location of any and all utilities or property lines.

ALL DIMENSIONS SHOWN ARE IN METRIC VALUES UNLESS NOTED OTHERWISE

REVISIONS

DATE	DETAILS	BY
22 SEPT. '80	MH LOCATIONS CHANGED; 21" SAN., 8" WM AND SERVICES ADDED	B. A.
	48 m OF 30" SAN. SEWER ADDED (DEDUCT 48 m OF 27")	
FEB. '82	REVISED TO CONTRACT No. 2	R.E.A.

RECOMMENDED BY | APPROVED BY

CITY OF NORTH BAY
DEPARTMENT OF REGIONAL ECONOMIC EXPANSION AND MINISTRY OF NORTHERN AFFAIRS

BOOTH ROAD
MARSHALL AVENUE TO BIRCH'S ROAD

STA. 3+00 TO STA. 6+00

℄ CHAINAGE	3+00	+25	+50	+68	+75	BH 3 END	4+00	+25	+50	+75	5+00	+20	+25	+50	+75	+90	6+00	℄ CHAINAGE
PROFILE GRADE TOP GRAN. 'A'	198.331	198.415	198.552	198.682	198.738		198.938	199.138	199.338	199.538	199.736	199.898	199.937	200.101	200.213	200.255	200.277	PROFILE GRADE TOP GRAN. 'A'
DITCH RT.	197.15	197.20					197.45	197.50	197.70	198.00		198.77		198.80			198.83	DITCH RT.
DITCH LT.	197.15	197.20					197.25	197.27	197.75	198.70				198.80			198.83	DITCH LT.
SAN. INVERT			194.328							27" S - 194.635 30" N - 194.574 21" E - 194.758						194.832		SAN. INVERT
TOP WM.	194.90		195.09 (+50)				195.17	195.15 (4+25)	195.59 (+50)		196.50			196.59 (+50)			196.70	TOP WM.

NORTHLAND ENGINEERING LTD.
Consulting Engineers and Planners
NORTH BAY SUDBURY THUNDER BAY

DRAWN BY: D.P. COOPER	DATE: MAY 1980
CHECKED BY: D.R.	FIELD BOOK:
SCALE: HOR. 1 : 500 VERT. 1 : 50	CONTRACT Nº 2
OFFICE NORTH BAY	PROJECT Nº 1865
DRAWING Nº B-2	

B-2

TRANSLAR 500-4-78