



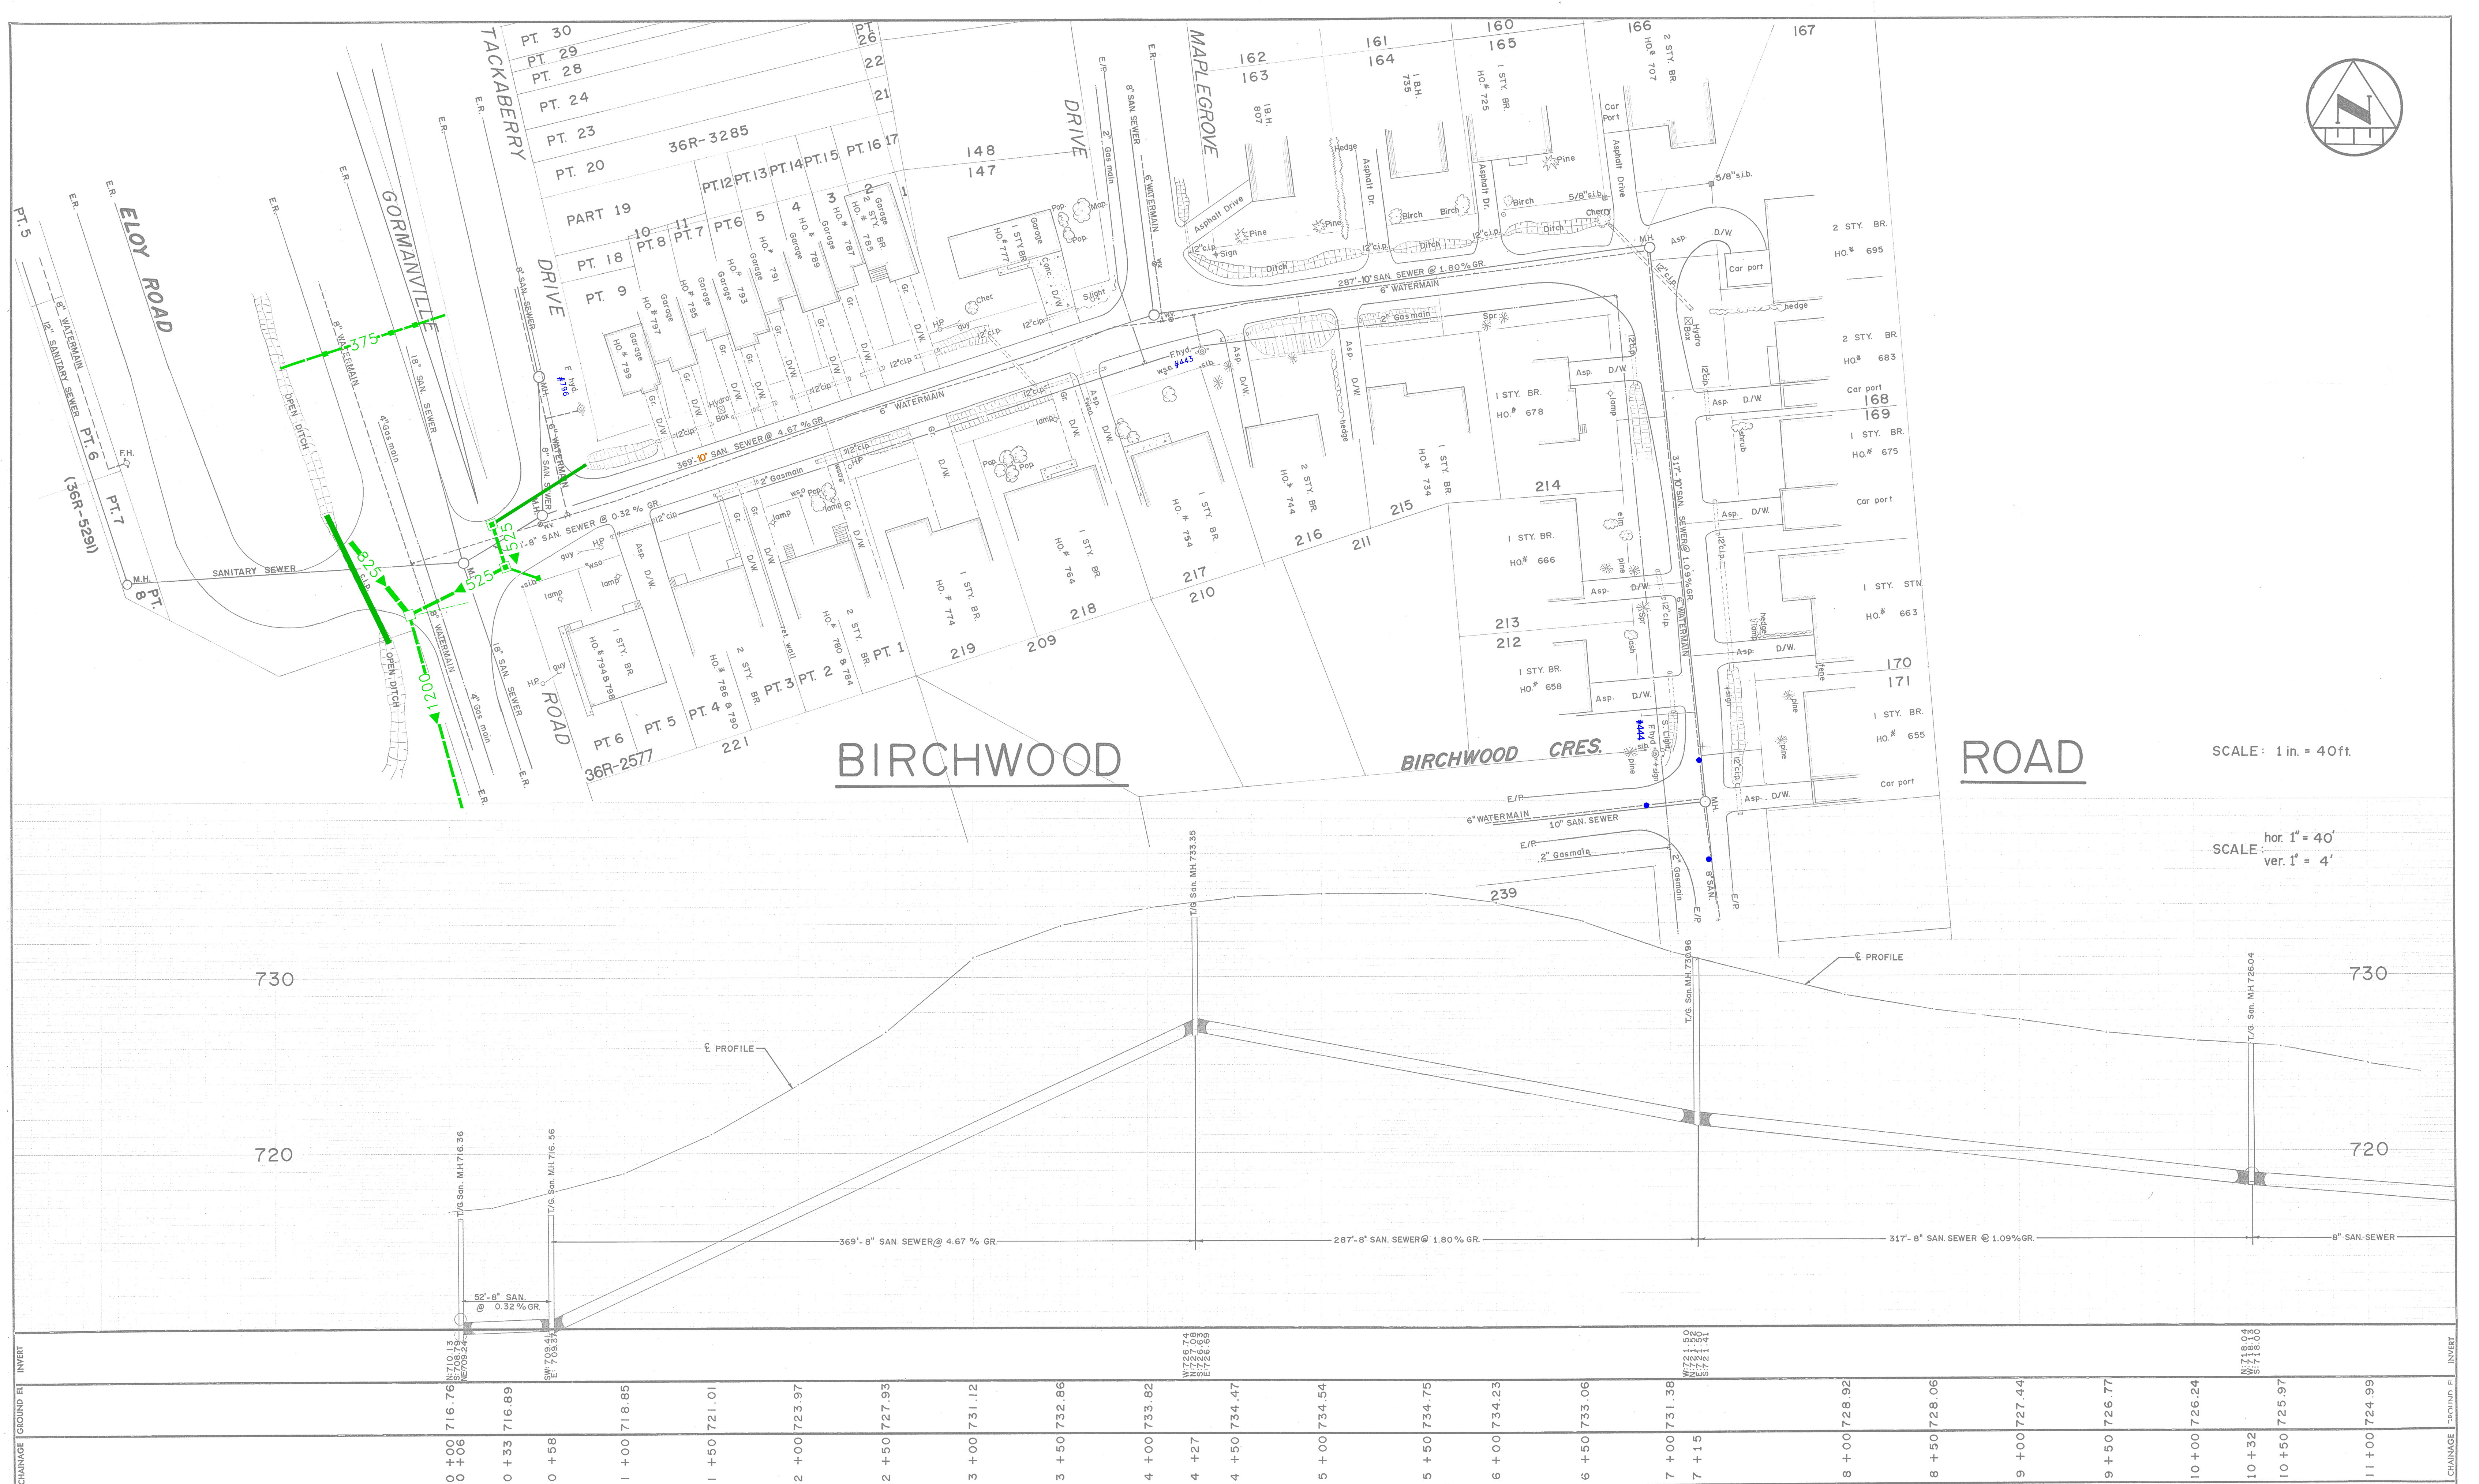

SCALE: 1 in. = 40ft.

SCALE: hor. 1" = 40'
ver. 1" = 4'

DWG No.	NOTES: DISCLAIMER The information contained on this drawing may be based upon data provided by others and may not have been verified by either as-constructed drawings or an Ontario Land Surveyor. The City of North Bay cannot accept responsibility for any errors or omissions on any information shown herein. Field verification, land surveys or excavation (with City approvals) may be required to determine actual location of any and all utilities or property lines.		1. NEW DRAWING		5/2/74	GWR	APPROVED	BIRCHWOOD ROAD		CITY OF NORTH BAY ENGINEERING DEPARTMENT	
			2. REVISED DETAIL & R		SEPT. 83	J.S.		GORMANVILLE ROAD TO STA. 10+00			
		No.	REVISION	DATE	INITIAL			SCALE: AS SHOWN		DATE: FEB, 1974	
								DRAWN BY: GWR		FIELD BOOK No.	
								CKD. BY:		233	
										B-276	
										REV.	

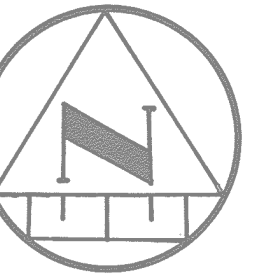