


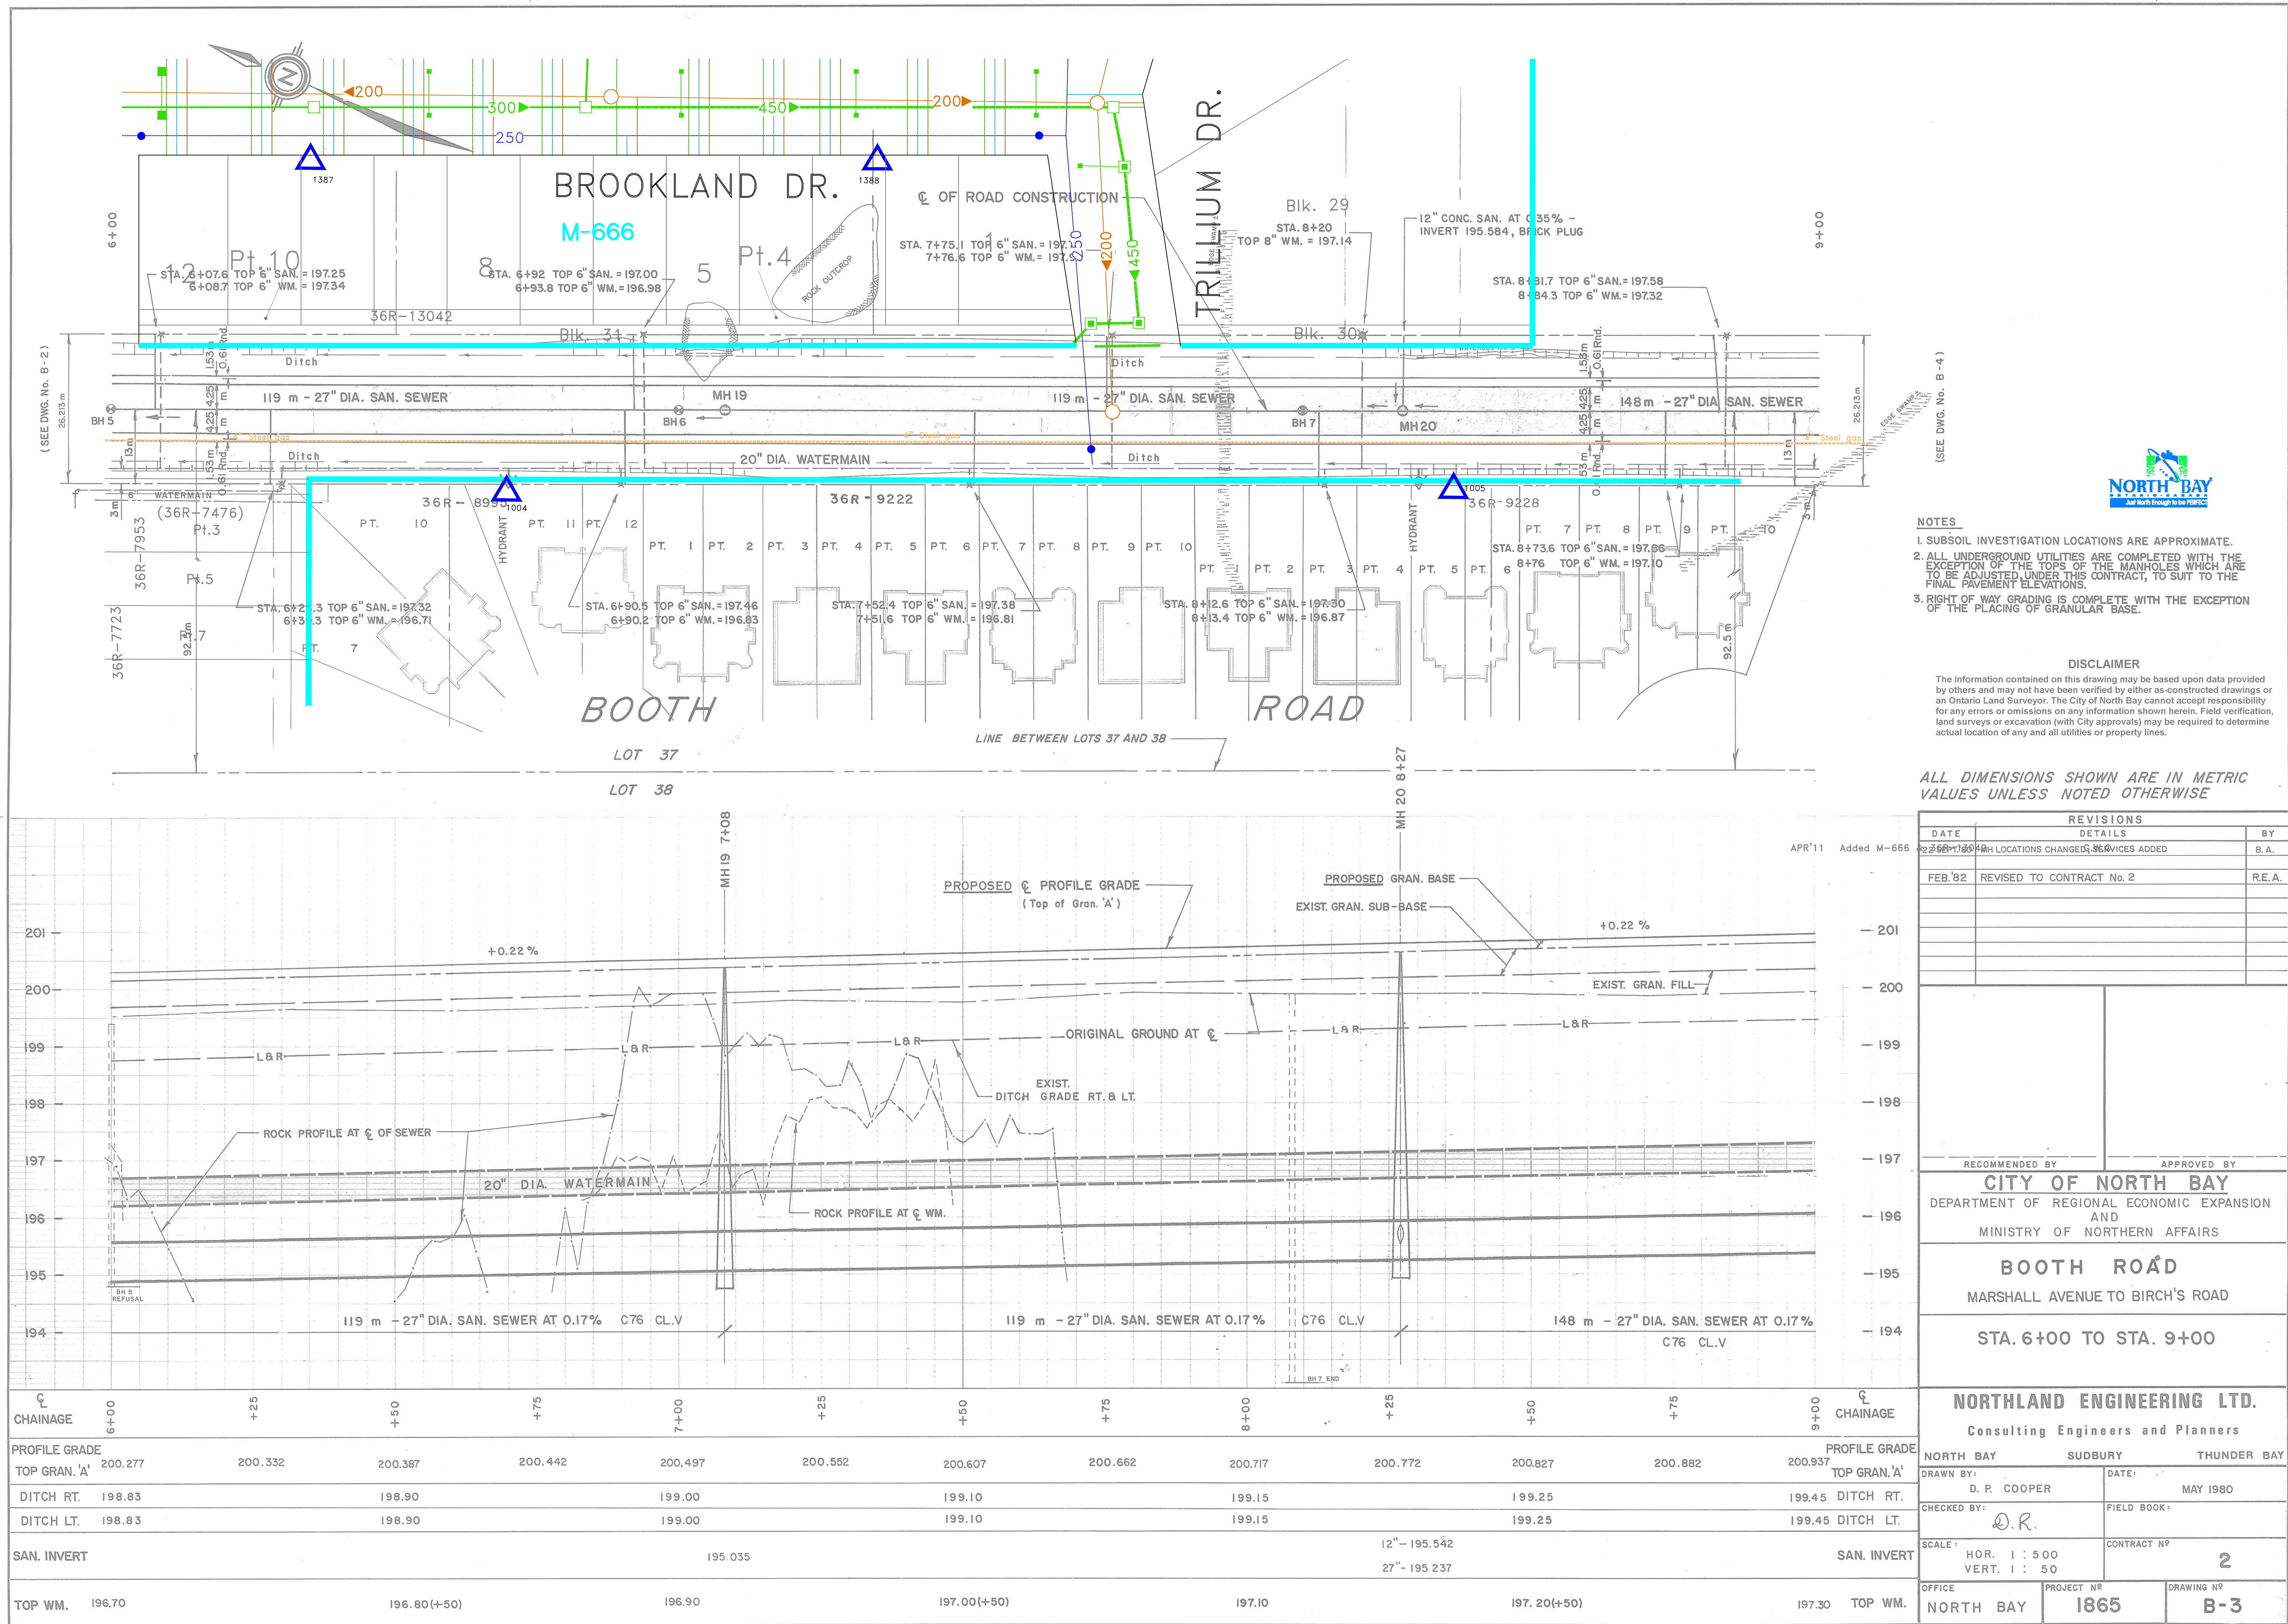

(SEE DWG. No. B-2)

(SEE DWG. No. B-4)



- NOTES**
- SUBSOIL INVESTIGATION LOCATIONS ARE APPROXIMATE.
 - ALL UNDERGROUND UTILITIES ARE COMPLETED WITH THE EXCEPTION OF THE TOPS OF THE MANHOLES WHICH ARE TO BE ADJUSTED UNDER THIS CONTRACT, TO SUIT TO THE FINAL PAVEMENT ELEVATIONS.
 - RIGHT OF WAY GRADING IS COMPLETE WITH THE EXCEPTION OF THE PLACING OF GRANULAR BASE.

DISCLAIMER

The information contained on this drawing may be based upon data provided by others and may not have been verified by either as-constructed drawings or an Ontario Land Surveyor. The City of North Bay cannot accept responsibility for any errors or omissions on any information shown herein. Field verification, land surveys or excavation (with City approvals) may be required to determine actual location of any and all utilities or property lines.

ALL DIMENSIONS SHOWN ARE IN METRIC VALUES UNLESS NOTED OTHERWISE

REVISIONS		
DATE	DETAILS	BY
APR '11	Added M-666	B.A.
RECOMMENDED BY		
APPROVED BY		
CITY OF NORTH BAY		
DEPARTMENT OF REGIONAL ECONOMIC EXPANSION AND MINISTRY OF NORTHERN AFFAIRS		
BOOTH ROAD		
MARSHALL AVENUE TO BIRCH'S ROAD		
STA. 6+00 TO STA. 9+00		
NORTHLAND ENGINEERING LTD.		
Consulting Engineers and Planners		
NORTH BAY SUDBURY THUNDER BAY		
DRAWN BY: D. P. COOPER		DATE: MAY 1980
CHECKED BY: D.R.		FIELD BOOK: 2
SCALE: HOR. 1 : 500 VERT. 1 : 50		CONTRACT NO. 2
OFFICE: NORTH BAY		PROJECT NO. 1865
		DRAWING NO. B-3