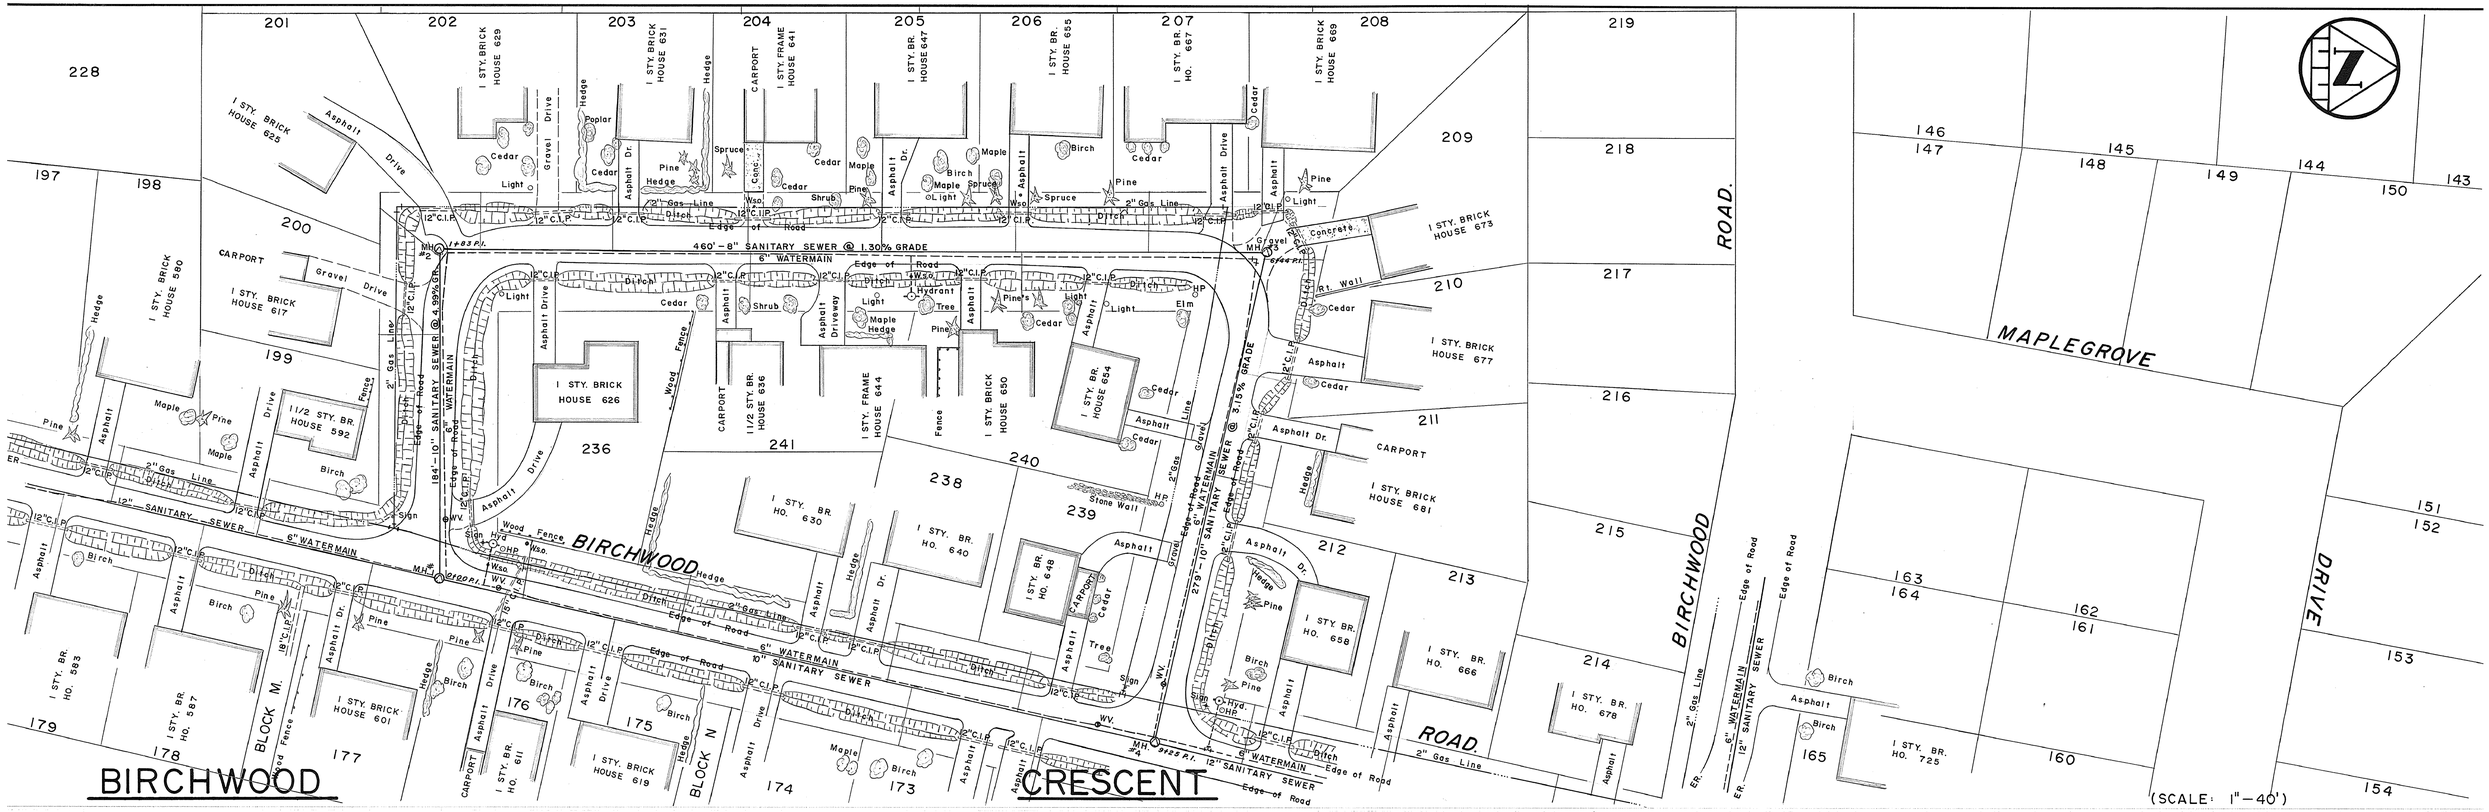

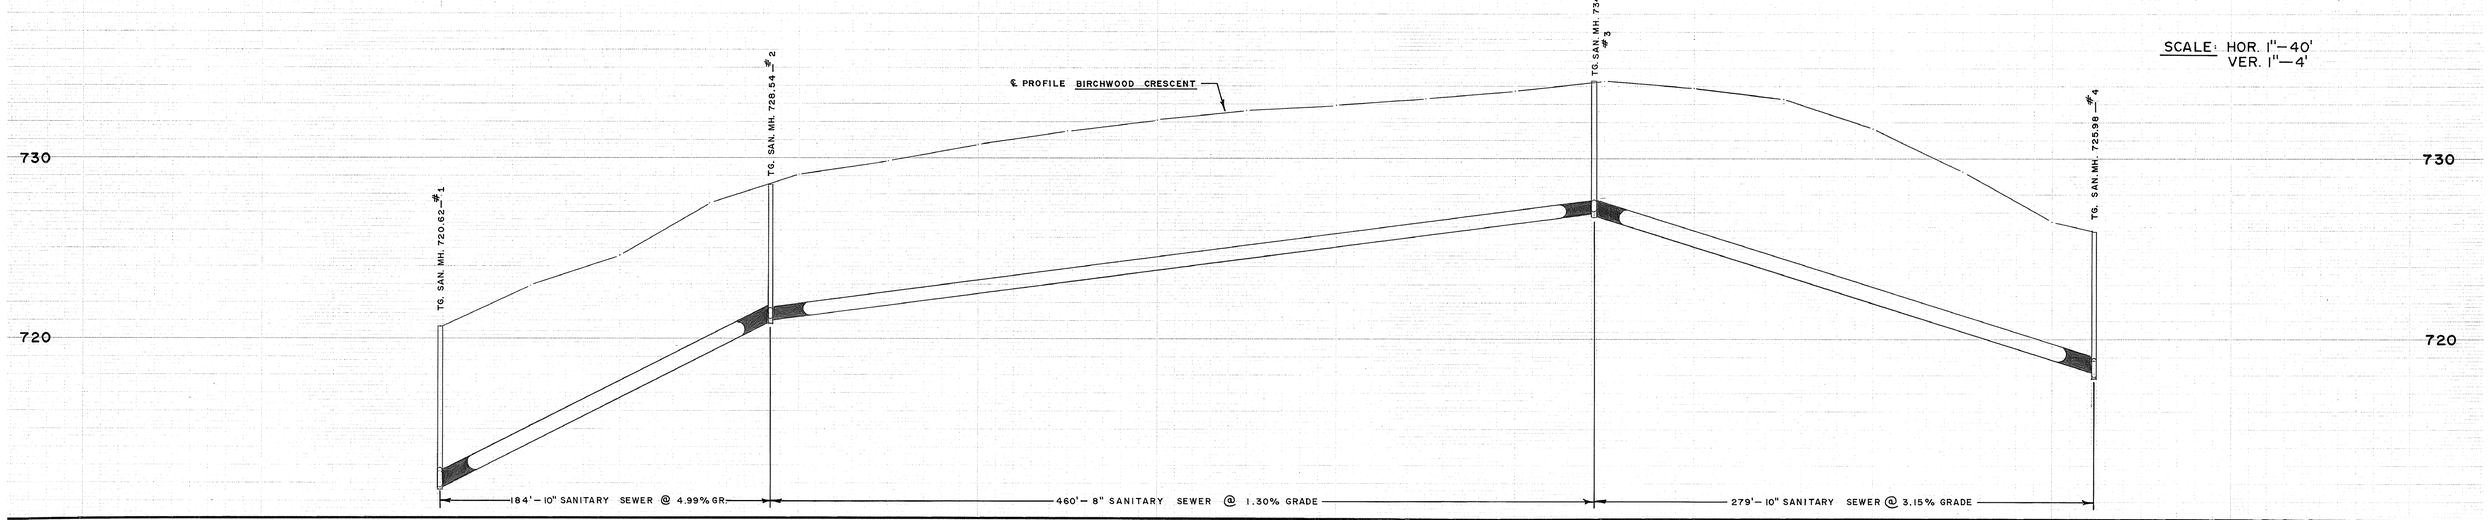

0+00	0+50	1+00	1+50	1+84	2+00	2+50	3+00	3+50	4+00	4+50	5+00	5+50	6+00	6+44	6+50	7+00	7+50	8+00	8+50	9+00	9+23
N-711.78 S-711.70 W-711.74				E-720.83 W-721.08 N-720.99										S-726.97 N-727.29 W-727.05 E-726.85						W-719.07 S-719.98	
720.62	722.96	724.60	727.44	729.08	729.81	729.81	730.78	731.48	732.09	732.65	732.97	733.29	733.78	734.29		733.94	733.29	731.64	729.27	726.52	

NOTES:

DISCLAIMER

The information contained on this drawing may be based upon data provided by others and may not have been verified by either as-constructed drawings or an Ontario Land Surveyor. The City of North Bay cannot accept responsibility for any errors or omissions on any information shown herein. Field verification, land surveys or excavation (with City approvals) may be required to determine actual location of any and all utilities or property lines.

NORTH BAY ONTARIO-CANADA

No.	REVISION	DATE	INITIAL
1.	NEW DRAWING	MAY. 74	R.F.B.

APPROVED

BIRCHWOOD CRESCENT

BIRCHWOOD ROAD to BIRCHWOOD ROAD.

REG'D. PLAN NO.- 115

CITY OF NORTH BAY

ENGINEERING DEPARTMENT

SCALE: AS SHOWN DATE: MAY. 74

DRAWN BY: CK'D. BY:

FIELD BOOK No. 235

DRAWING No. B-301