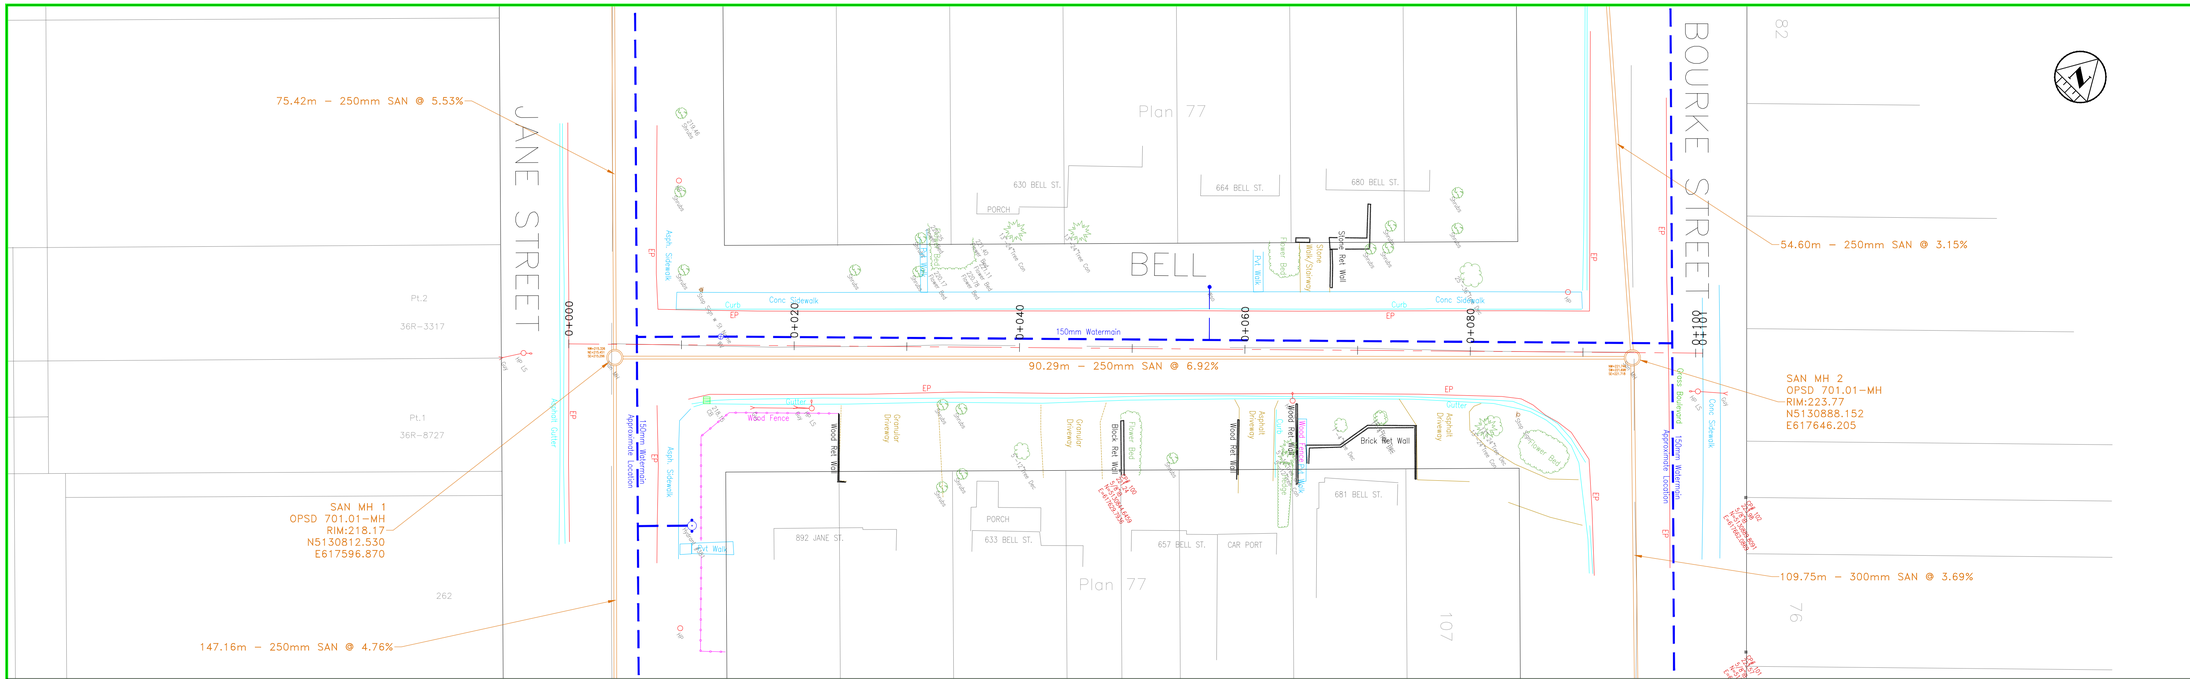

KEY PLAN

LEGEND

REVISIONS

no.	date	by	description
1.	5 August 2015		As-Built

Disclaimer

The information contained on this drawing may be based upon data provided by others and may not have been verified by either as-constructed drawings or an Ontario Land Surveyor. The City of North Bay cannot accept responsibility for any errors or omissions on any information shown herein. Field verification, land surveys or excavation (with City approvals) may be required to determine actual location of any and all utilities or property lines.

NORTH BAY ONTARIO CANADA
Just North Enough to be PERFECT

From Jane St. To McIntyre St.

AS-BUILT

BELL_STREET

STA. 0+000 to 0+100.63

designer	drawn by: G.W.C.
checked by:	approved by:

scale
H.1:250
V.1:50

date 8/05/2015

drawing number B-780