


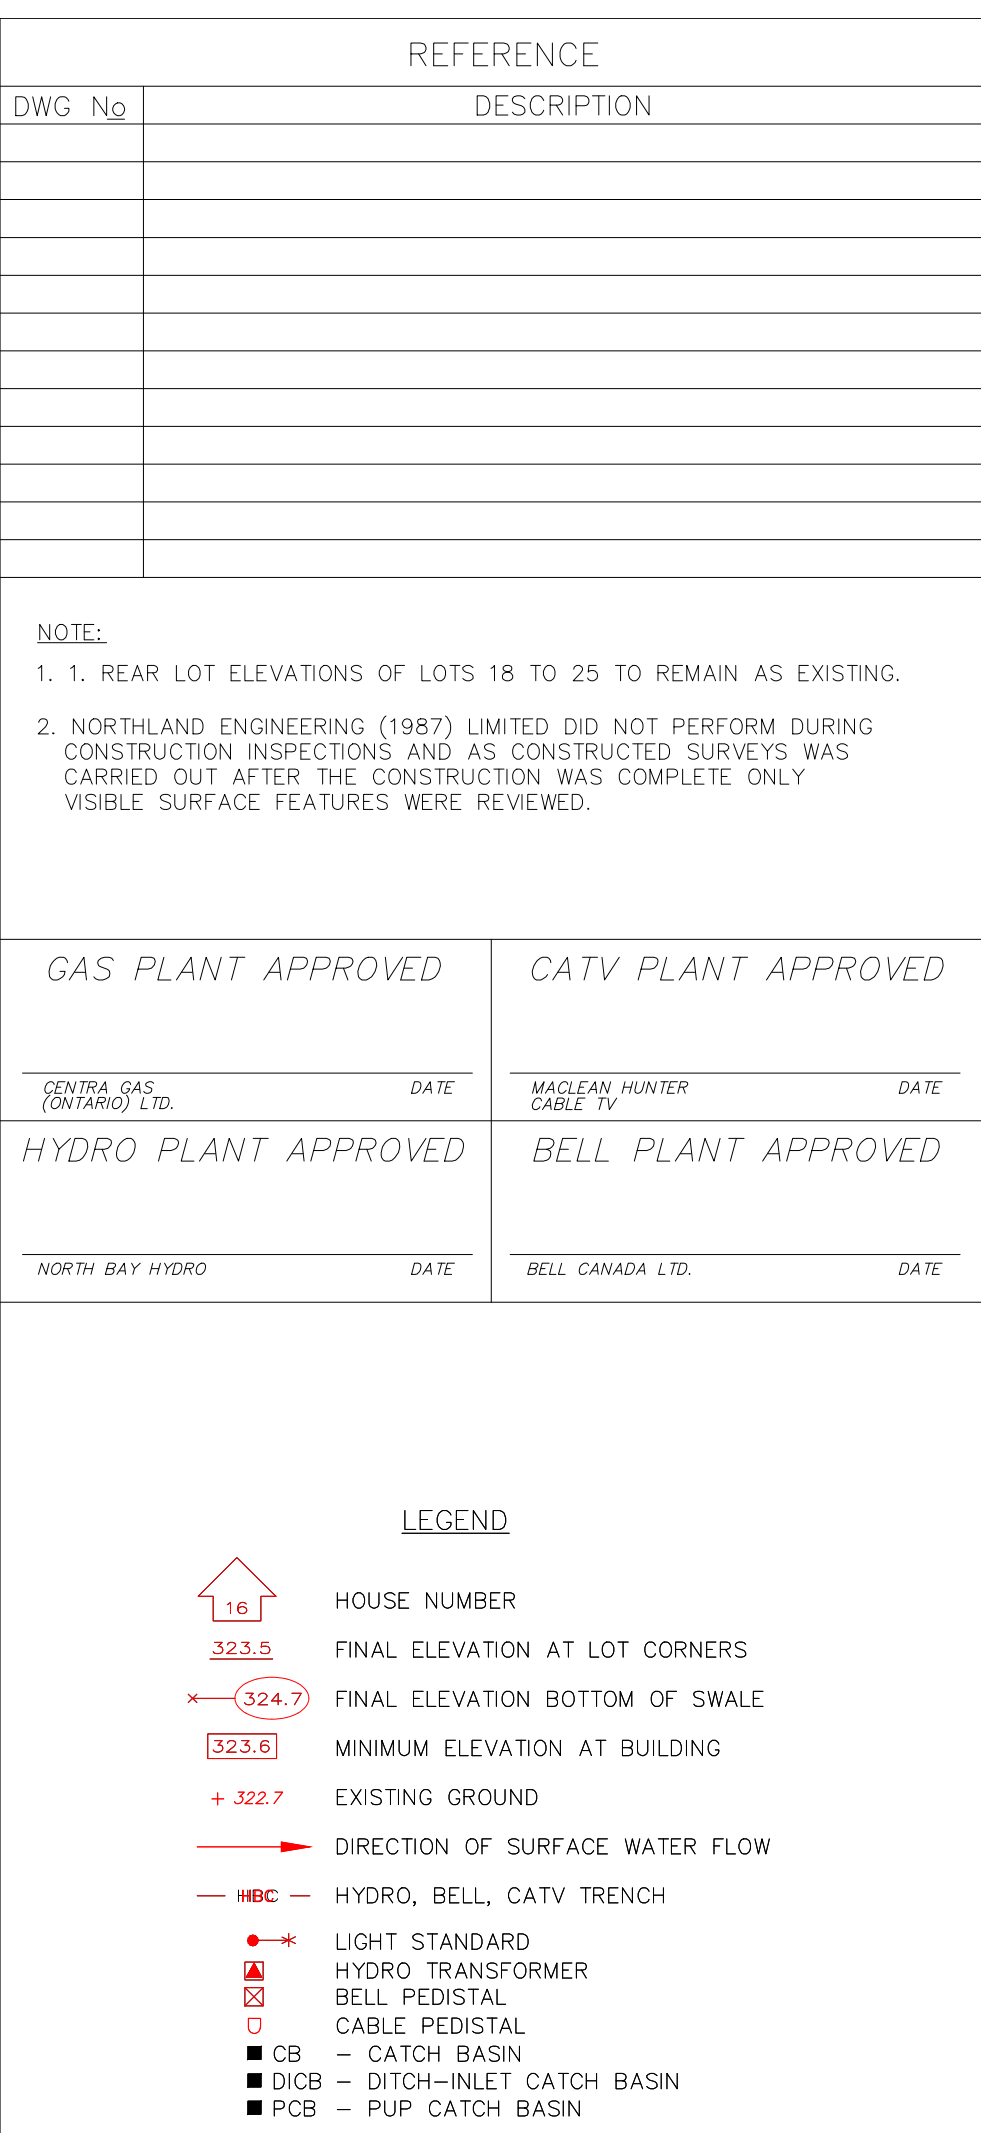

northland engineering (1987) limited Consulting Engineers and Planners			
NORTH BAY		SUDBURY	
DRAWN BY: T.H.P. CHECKED BY: M.B.B./B.F.D. FIELD BOOK		DATE: MARCH 1992 SCALE: HORIZ. 1 : 500 VERT. 1 : 50	
OFFICE NORTH BAY	PROJECT No 3556	DRAWING No C-1126	REV.