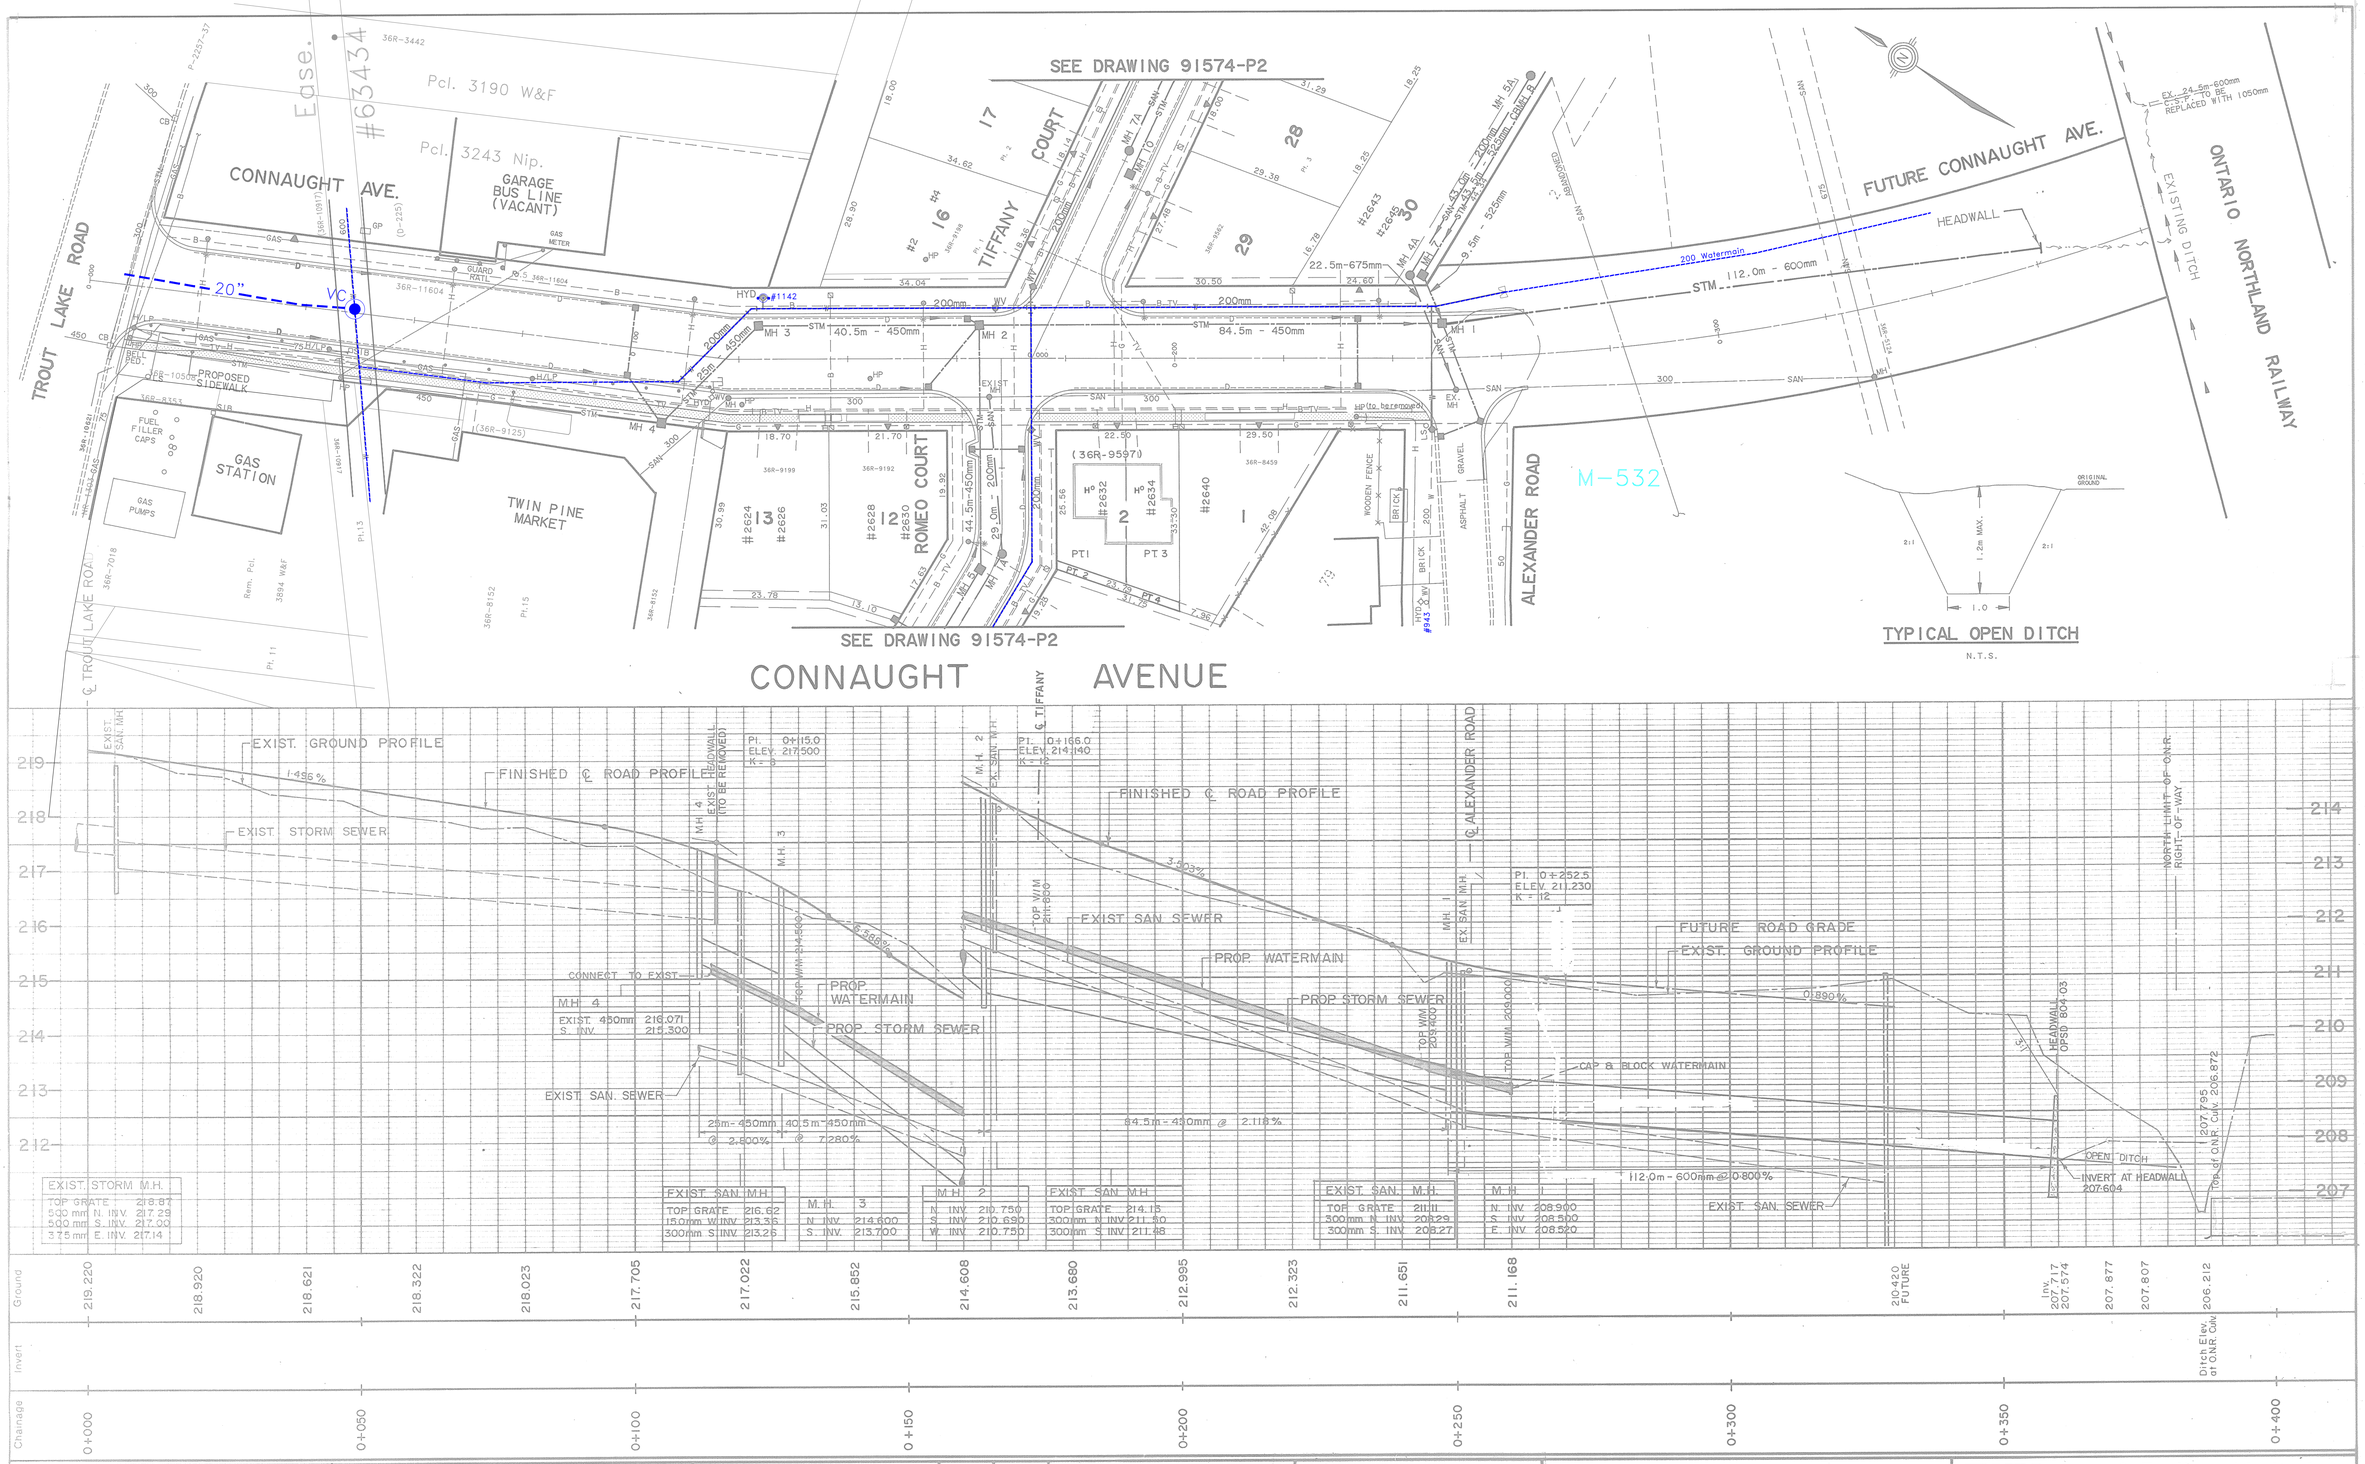

Notes:

DISCLAIMER

The information contained on this drawing may be based upon data provided by others and may not have been verified by either as-constructed drawings or an Ontario Land Surveyor. The City of North Bay cannot accept responsibility for any errors or omissions on any information shown herein. Field verification, land surveys or excavation (with City approvals) may be required to determine actual location of any and all utilities or property lines.

No.	Revision	Date	Initial

Approved — LICENSED PROFESSIONAL ENGINEER G. K. STRACHAN PROVINCE OF ONTARIO

HYDRO PLANT APPROVED — NORTH BAY HYDRO — DATE Nov 21/91

GAS PLANT APPROVED — CENTRA GAS CO. — DATE Nov 19/91

BELL PLANT APPROVED — BELL TELEPHONE CO. — DATE 91-12-06

CITY OF NORTH BAY

TROUT LAKE ROAD SUBDIVISION

CONNAUGHT AVE.

℄ TROUT LAKE ROAD to O.N.R. EASEMENT

Proctor & Redfern Limited
Consulting Engineers & Architect
Toronto — North Bay

Scale	Drawn by / Ckd. by	Date	Dwg. No.	Rev.
HOR: 1:500 VER: 1:50	DRB/AVD RAB	SEPT. 1991	C-1151	0

C-1151