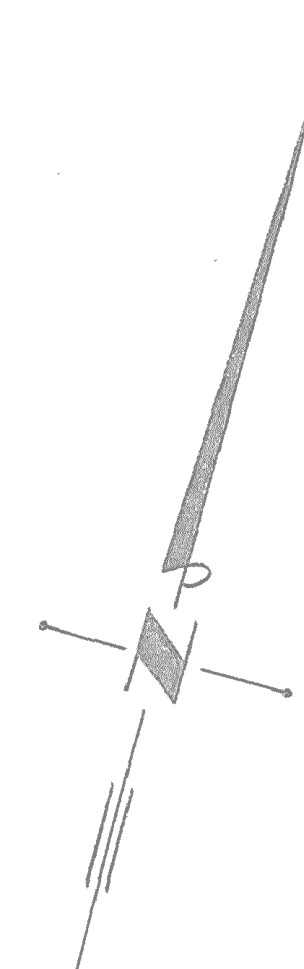
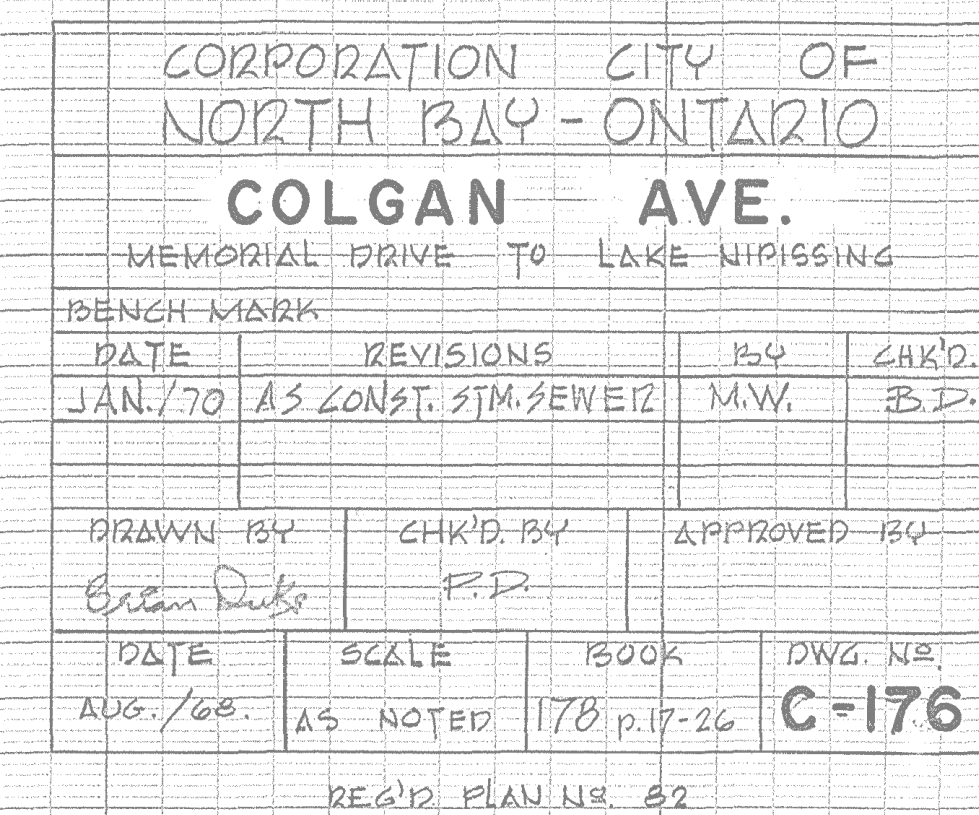
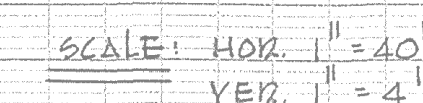





KEUFFEL &amp; ESSER CO.

TRADE STANDARD MARK  
REG. U.S. PAT. OFF.  
PROFILE PLATE A 4 X 2  
100% RAG PAPER  
MADE IN U.S.A.