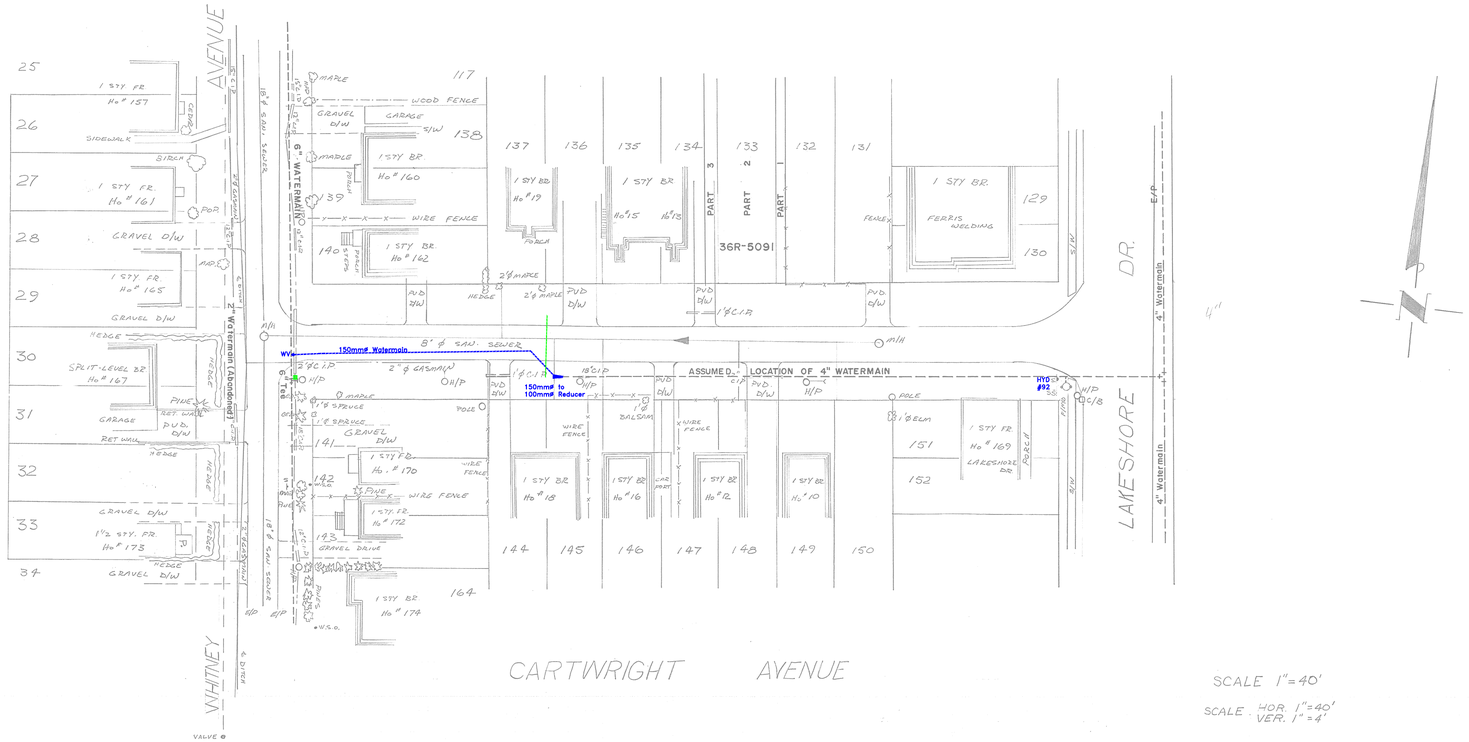

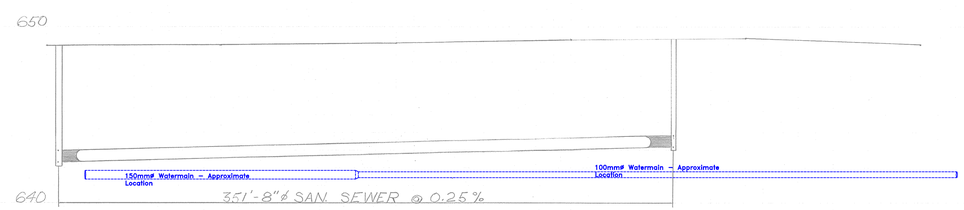

CHAINAGE	GROUND EL	INVERT
0+07.0	M.H.	642.29 E. INV.
0+17		
0+29		
0+35		
0+53	M.H.	643.15 W. INV.
0+49		
0+59		

NOTES:

DISCLAIMER

The information contained on this drawing may be based upon data provided by others and may not have been verified by either as-constructed drawings or an Ontario Land Surveyor. The City of North Bay cannot accept responsibility for any errors or omissions on any information shown herein. Field verification, land surveys or excavation (with City approvals) may be required to determine actual location of any and all utilities or property lines.

NORTH BAY
Just North Enough to be Perfect

No.	REVISION	DATE	INITIAL
1.	Updated Waterlooping	August 2015	G.W.C.

APPROVED

CARTWRIGHT AVE.

WHITNEY AVENUE TO LAKESHORE DRIVE

REG-D. PLAN NO. 100

CITY OF NORTH BAY
ENGINEERING DEPARTMENT

SCALE: AS SHOWN ABOVE DATE: JUNE/70

DRAWN BY: J.D.
CK'D. BY:
FIELD BOOK No. 192
DRAWING No. C-201
REV.

DWG. No.