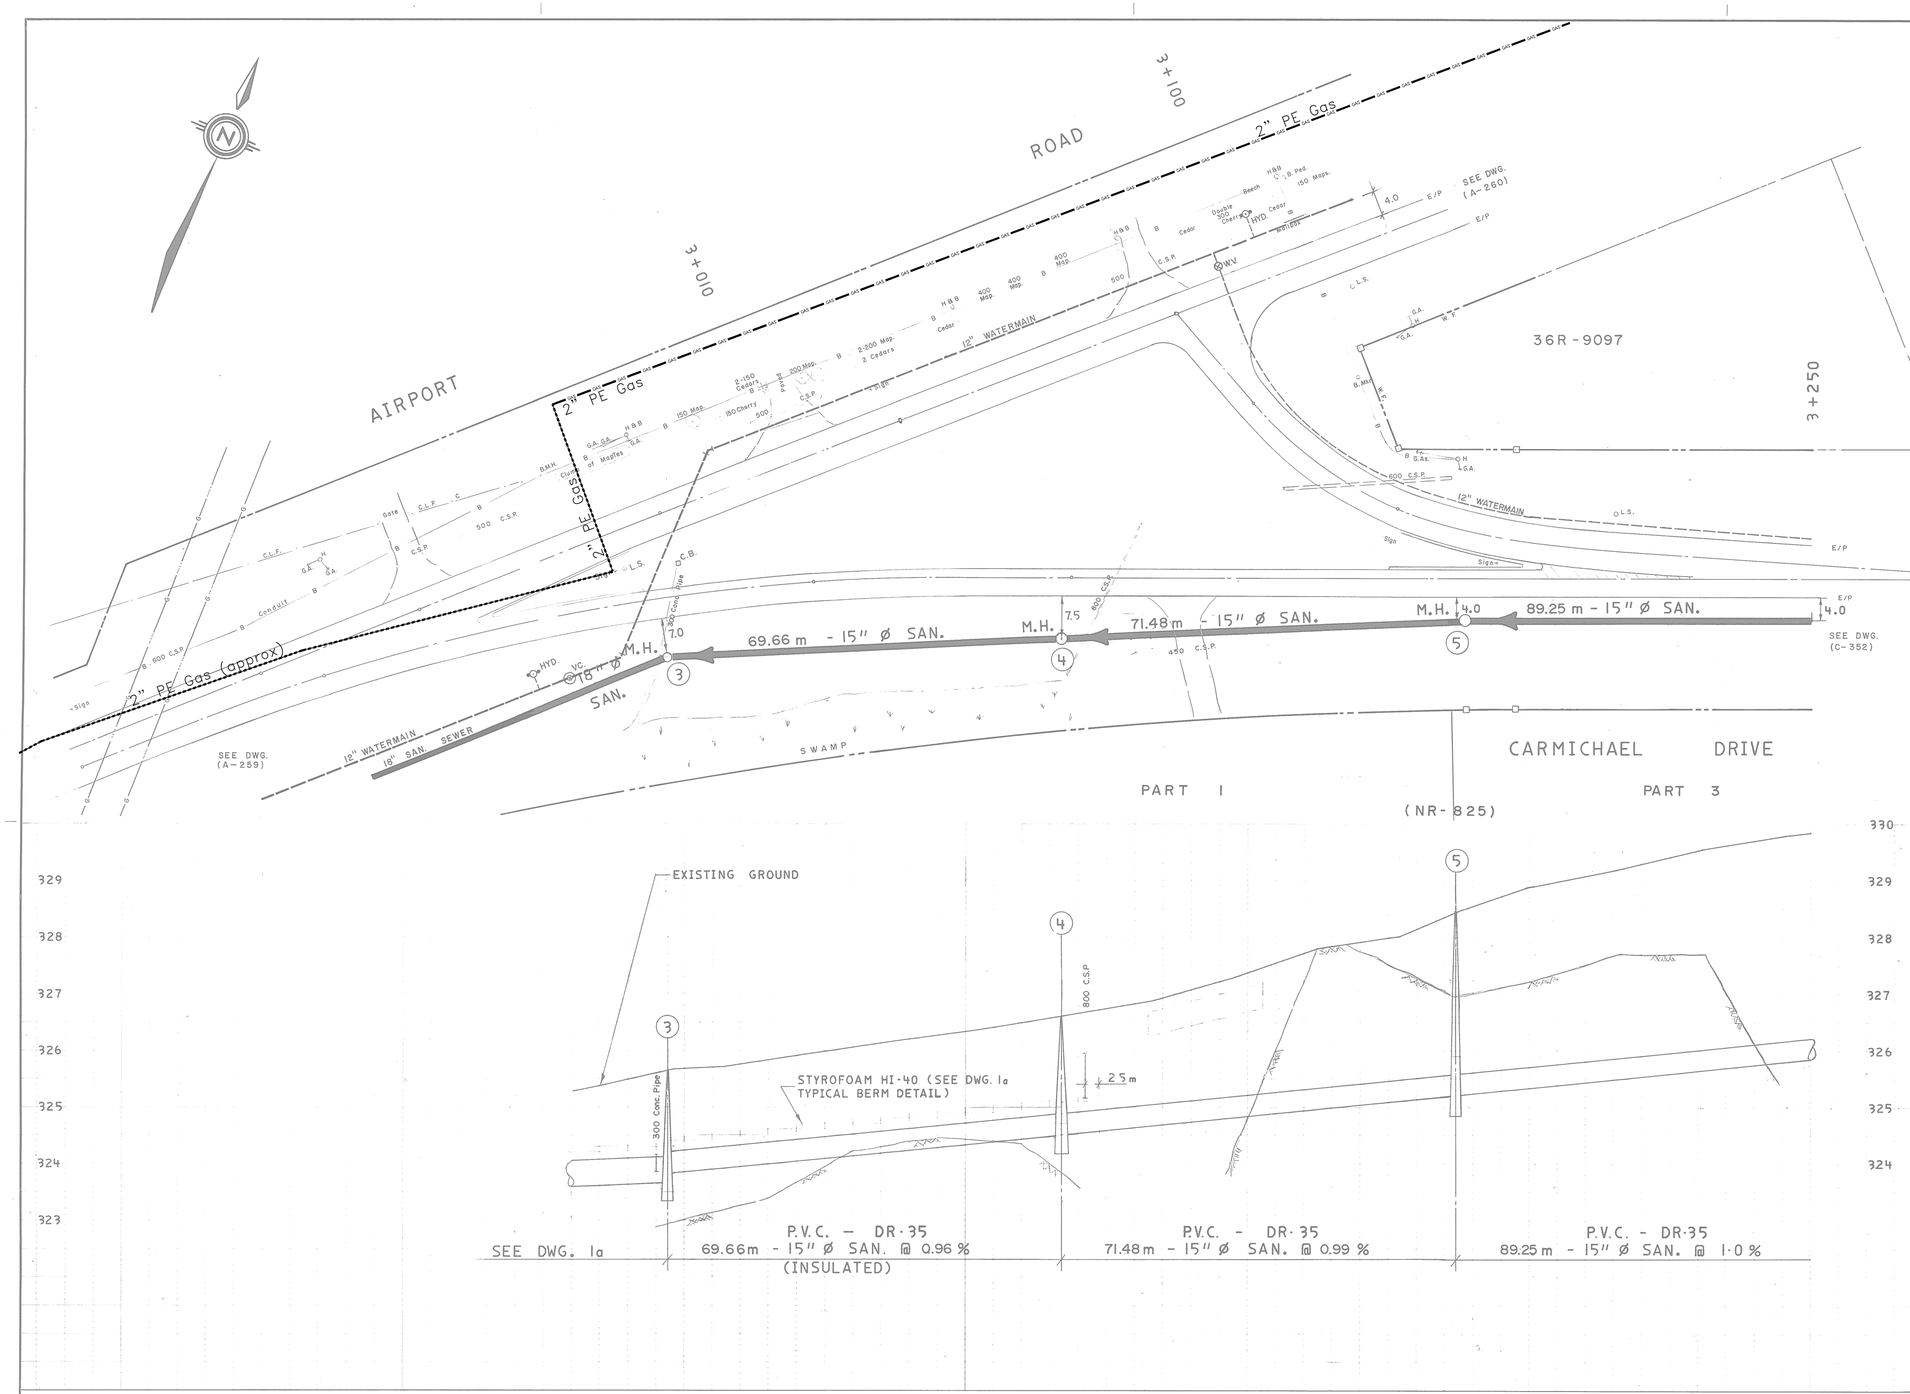

NOTE :
ROCK LINE SHOWN ON ALL DRAWINGS ARE RESULTS OF AIRTRACK DRILLING AT 15m INTERVALS. WHERE ROCK WAS ENCOUNTERED, DRILLING CONTINUED AN ADDITIONAL 0.6m DEEP AND ASSUMED THEN TO BE BEDROCK. JULY 31, 1984

DISCLAIMER

The information contained on this drawing may be based upon data provided by others and may not have been verified by either as-constructed drawings or an Ontario Land Surveyor. The City of North Bay cannot accept responsibility for any errors or omissions on any information shown herein. Field verification, land surveys or excavation (with City approvals) may be required to determine actual location of any and all utilities or property lines.

REVISIONS		
DATE	DETAILS	BY
MAR. '87	AS CONST. SAN. SEW. Cont. 125-84 BK. 275	P.L.C.

RECOMMENDED BY | APPROVED BY

CITY OF NORTH BAY

CARMICHAEL DRIVE TRUNK SEWER

PLAN AND PROFILE
STA. 2+950 TO STA. 3+250

CHAINAGE	2+950	3+000	3+047	3+050	3+100	3+117	3+187	3+200	3+250
FINISHED TOP OF GRATE ELEVATION			325.969			326.679	328.736		
SEWER PIPE INVERT @ MH.			S 323.699 N 323.849			S 324.519 N 324.519	S 325.226 N 325.236		

NORTHLAND ENGINEERING LTD.
Consulting Engineers and Planners
NORTH BAY SUDBURY TIMMINS

DRAWN BY: P.L. CHANDLER	DATE: JUNE, 1984
CHECKED BY: D.A. RICHARDS	FIELD BOOK:
SCALE: 1:500 HOR. 1:50 VERT.	CONTRACT Nº

OFFICE	PROJECT Nº	DRAWING Nº
N. BAY	2779	C-351

TRANSLAR 500-4-78