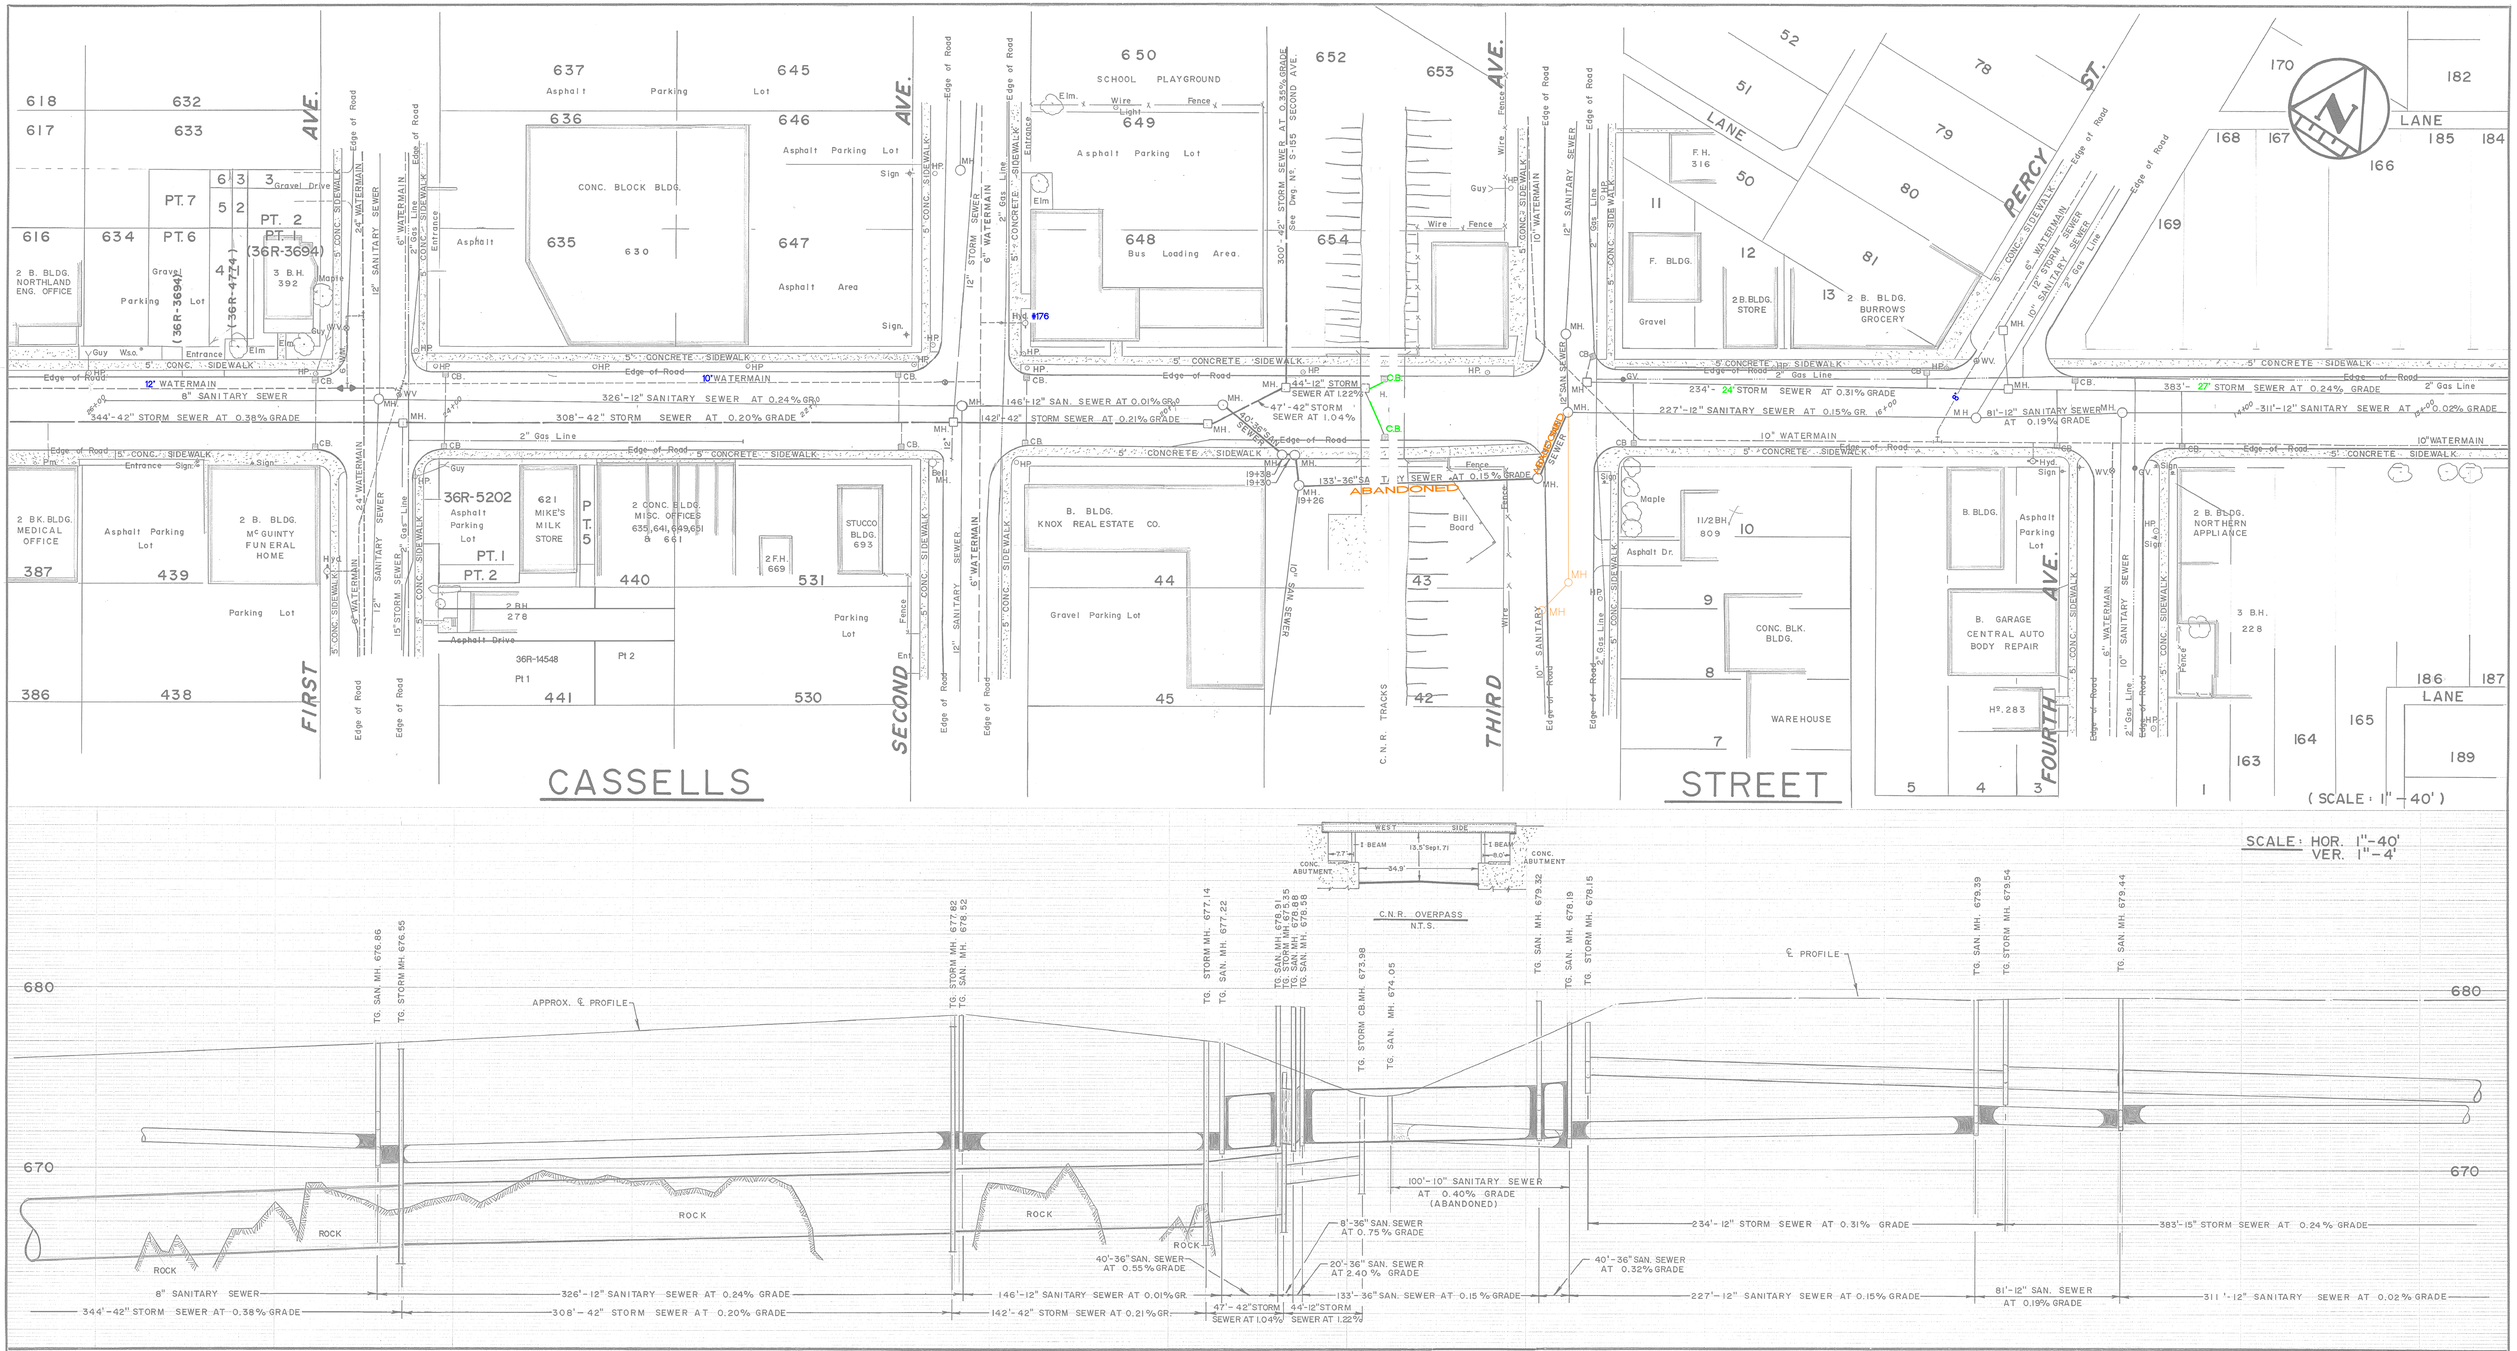

NOTES:

DISCLAIMER

The information contained on this drawing may be based upon data provided by others and may not have been verified by either as-constructed drawings or an Ontario Land Surveyor. The City of North Bay cannot accept responsibility for any errors or omissions on any information shown herein. Field verification, land surveys or excavation (with City approvals) may be required to determine actual location of any and all utilities or property lines.

NORTH BAY — Just North Enough to be PERFECT

No.	REVISION	DATE	INITIAL
1.	AS CONST'D. STORM SEWER (42") 1963 Bk. 119	MAR. 80	R.F.B.
2.	NEW ℄ & CURB. 3rd. to 7th. 1979 Bk. 253 (BK 255)	MAR. 80	R.F.B.
3.	REVISED INVERTS. SAN. MH. 19+26 to 19+38	JUNE 80	R.F.B.
4.	Sanitary, Water, Storm Changes.	July 2008	r.j.o.

APPROVED

CASSELLS STREET

FIRST AVENUE TO FIFTH AVENUE

CITY OF NORTH BAY

ENGINEERING DEPARTMENT

SCALE: AS SHOWN

DATE: MAR. 80

DRAWN BY: Rick B.

CK'D. BY:

FIELD BOOK No.

DRAWING No. C-527

REV.