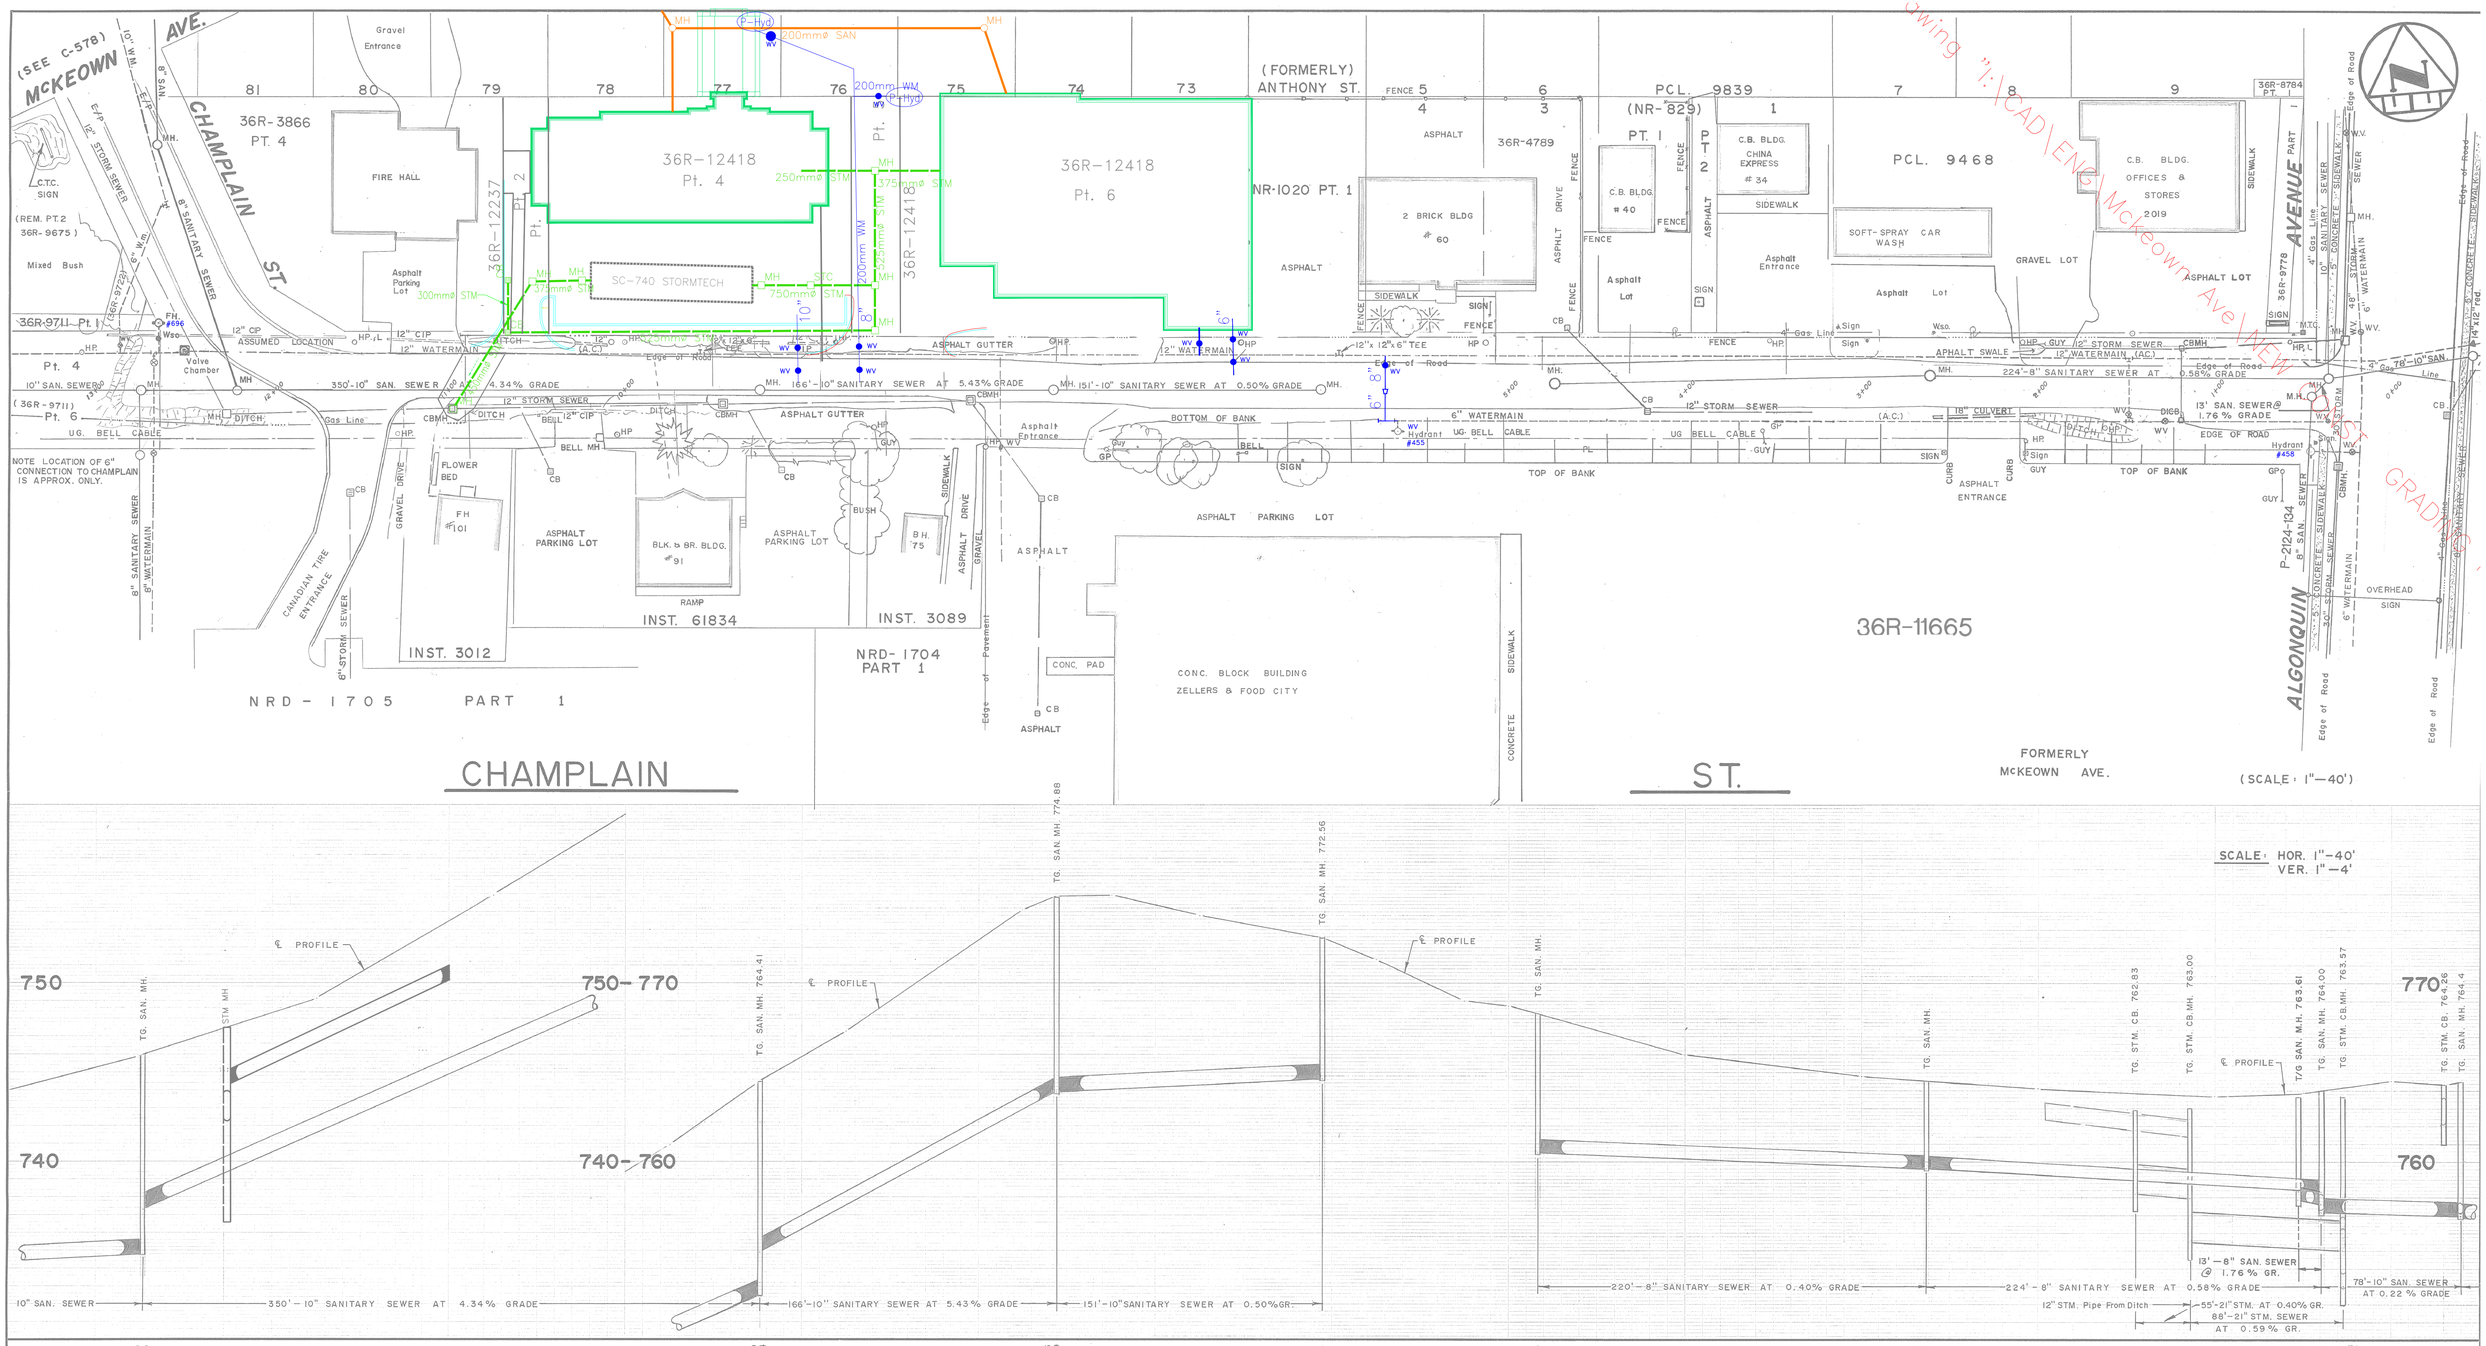

CHAINAGE	GROUND EL	INVERT
13+50		
13+00		
12+75	745.9	W-734.79
12+73		E-737.29
12+00		
11+75	749.1	
11+00		
10+75	754.9	
10+00		
9+75	760.9	
9+23		W-759.49 E-762.99
9+00		
8+75	767.3	
8+00		
7+75	774.1	
7+56		W-773.96 E-773.96
7+25	774.9	
7+00	773.8	
6+75		
6+05		W-764.64
6+00		
5+75	771.3	
5+25	769.0	
5+00	768.7	
4+83		E-760.50
4+00	766.0	
3+00	764.8	
2+63		W-759.62 E-759.62
2+00	764.10	
1+50	763.88	
1+45		
1+14		E-757.99 E-757.99
1+00	763.68	
0+50	763.84	N-757.88 S-758.36
0+49		W-759.31
0+39		W-757.65 SW-757.65
0+27		W-755.00 N-757.88
0+00	764.56	
0-31		E-762.10 W-756.99
0-39		W-756.91 E-756.91
CHAINAGE	GROUND EL	INVERT

NOTES:

DISCLAIMER

The information contained on this drawing may be based upon data provided by others and may not have been verified by either as-constructed drawings or an Ontario Land Surveyor. The City of North Bay cannot accept responsibility for any errors or omissions on any information shown herein. Field verification, land surveys or excavation (with City approvals) may be required to determine actual location of any and all utilities or property lines.

NORTH BAY — Just North Enough to be PERFECT

No.	REVISION	DATE	INITIAL
1.	NEW DWG., Detail Notes 1968, 70 & SAN. 1970		
	As Const'd. 12" WATERMAIN, NORTHLAND 1963	NOV. 77	R.F.B.
2.	UG. BELL CABLE	AUG. 78	j.d.m.
3.	UPDATE SAN. DETAIL @ ALGONQUIN AVE. see C-578	JAN. 84	J.S.
4.	AS CONST'D - McKEOWN AVE - CHAMPLAIN ST.	FEB. 92	R.T.
5.	REVISE VALVE LOCATIONS AT ALGONQUIN AVE. 10" LOCATION AT CHAMPLAIN ST.		
6	REVISE DETAIL CHAMPLAIN ST. AT CTC	APRIL 95	RT
7.	HILTON / SHOPPERS SERVICING	AUG. 09	A.P.
8.	Updated Water Services	Dec. 09	G.W.C.
9.	Removed Valve Chamber as per P/W	Feb. '11	G.W.C.
10.	Water Loop as per P/W	Oct. '11	G.W.C.

APPROVED

CHAMPLAIN ST.
ALGONQUIN AVE. TO McKEOWN AVE.
Reg'd. Plan Nº. M-162

CITY OF NORTH BAY
ENGINEERING DEPARTMENT

SCALE: AS SHOWN
DATE: NOV. 77.
DRAWN BY: Rick B.
CK'D. BY:
FIELD BOOK No. 176, 197,
DRAWING No. C-579
REV.