


NOTES:	DISCLAIMER The information contained on this drawing may be based upon data provided by others and may not have been verified by either as-constructed drawings or an Ontario Land Surveyor. The City of North Bay cannot accept responsibility for any errors or omissions on any information shown herein. Field verification, land surveys or excavation (with City approvals) may be required to determine actual location of any and all utilities or property lines.		1.	NEW DRAWING	APR. 76	R. F. B.	APPROVED	CASSLETS ST. to NINTH ST.	CANADORE 30" RELIEF SEWER STATION 38+00 TO STATION 51+00 CANADIAN PACIFIC RAIL EASEMENT.	CITY OF NORTH BAY ENGINEERING DEPARTMENT	SCALE: AS SHOWN	DATE: APRIL 1976	DRAWN BY: R. F. B.	FIELD BOOK No. 243 245	DRAWING No. C - 704	REV.
			2.	AS CONST'D. SAN. SEWER JULY 1976	OCT. 77	R. F. B.										
			3.	REVISION TO M.H. INVERT (OAK at NINTH)	JAN. 78	J. d. m.										
			4.	Revised SAN SEWER, STM SEWER & Add Property Lines	DEC. 84	Rick B.										
			5.	DALRON Sanitary and Storm Services	Oct 2006	Rick B.										
	No.	REVISION	DATE	INITIAL												

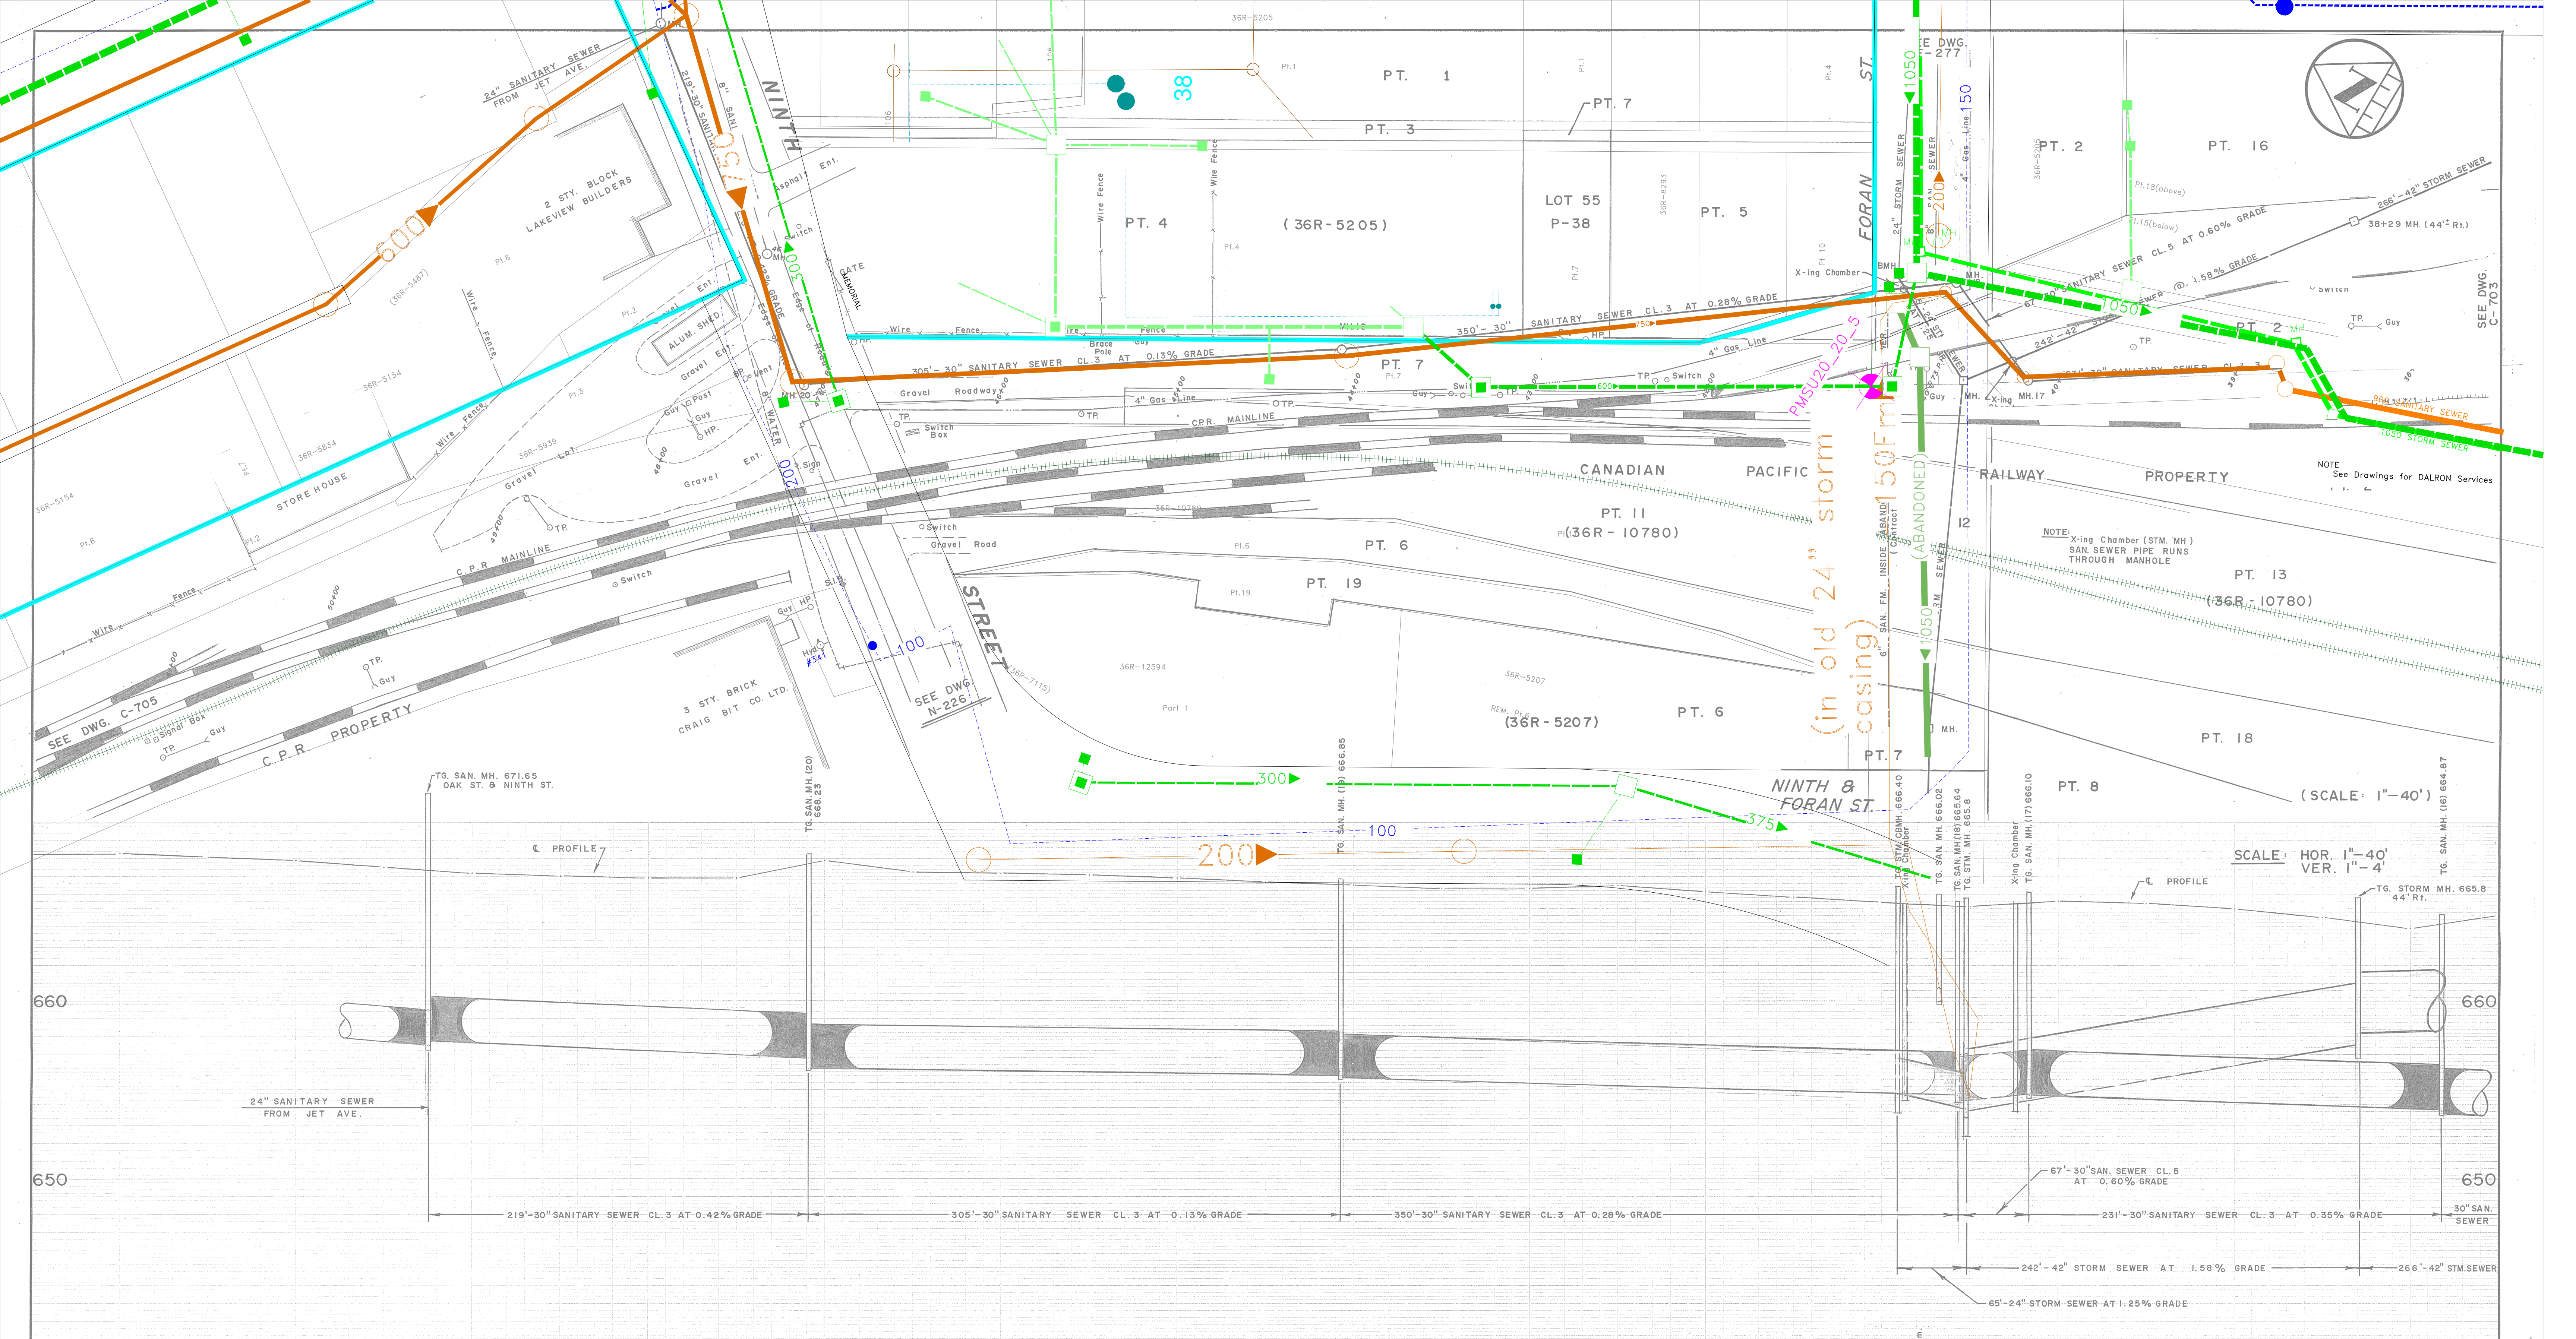