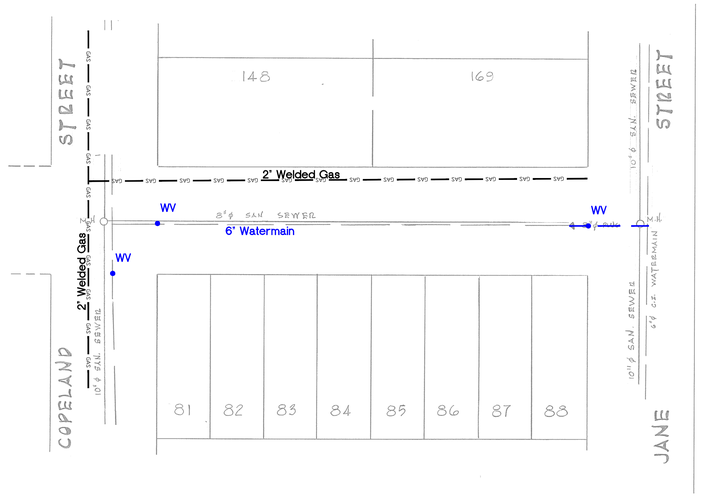

DASHNAY STREET

SCALE HOR: 1" = 40'
VER: 1" = 4'

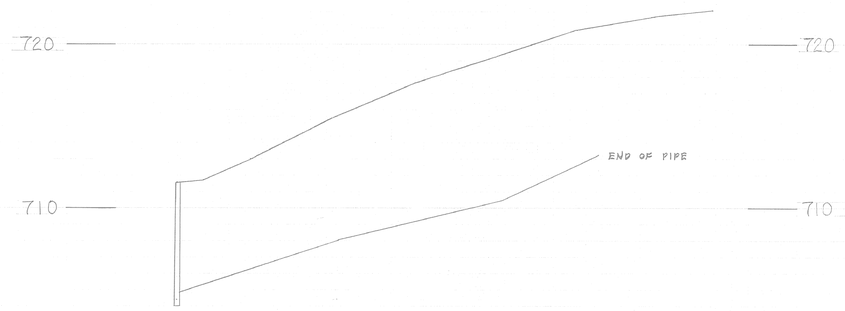

DASHNAY ST.
FORMERLY.
MATTAWA ST.

704.80

INVERT
GROUND EL
CHAINAGE

DWG. No.

NOTES:

DISCLAIMER

The information contained on this drawing may be based upon data provided by others and may not have been verified by either as-constructed drawings or an Ontario Land Surveyor. The City of North Bay cannot accept responsibility for any errors or omissions on any information shown herein. Field verification, land surveys or excavation (with City approvals) may be required to determine actual location of any and all utilities or property lines.

NORTH BAY
Just North Enough to be PERFECT

No.	REVISION	DATE	INITIAL
1.	Watermain looped and valves added.	Oct. 07	r.j.o.

APPROVED

DASHNAY ST

COPELAND STREET TO JANE STREET
REG'D PLAN'S No 15 & 87
LOT 22, CON C.

CITY OF NORTH BAY
ENGINEERING DEPARTMENT

SCALE: 1" = 40'
DATE: AUG. 25/70
DRAWN BY: J.D.
CK'D. BY:
FIELD BOOK No.
DRAWING No. D-101
REV.