


rovided
wings or
nability
rification,
stermine

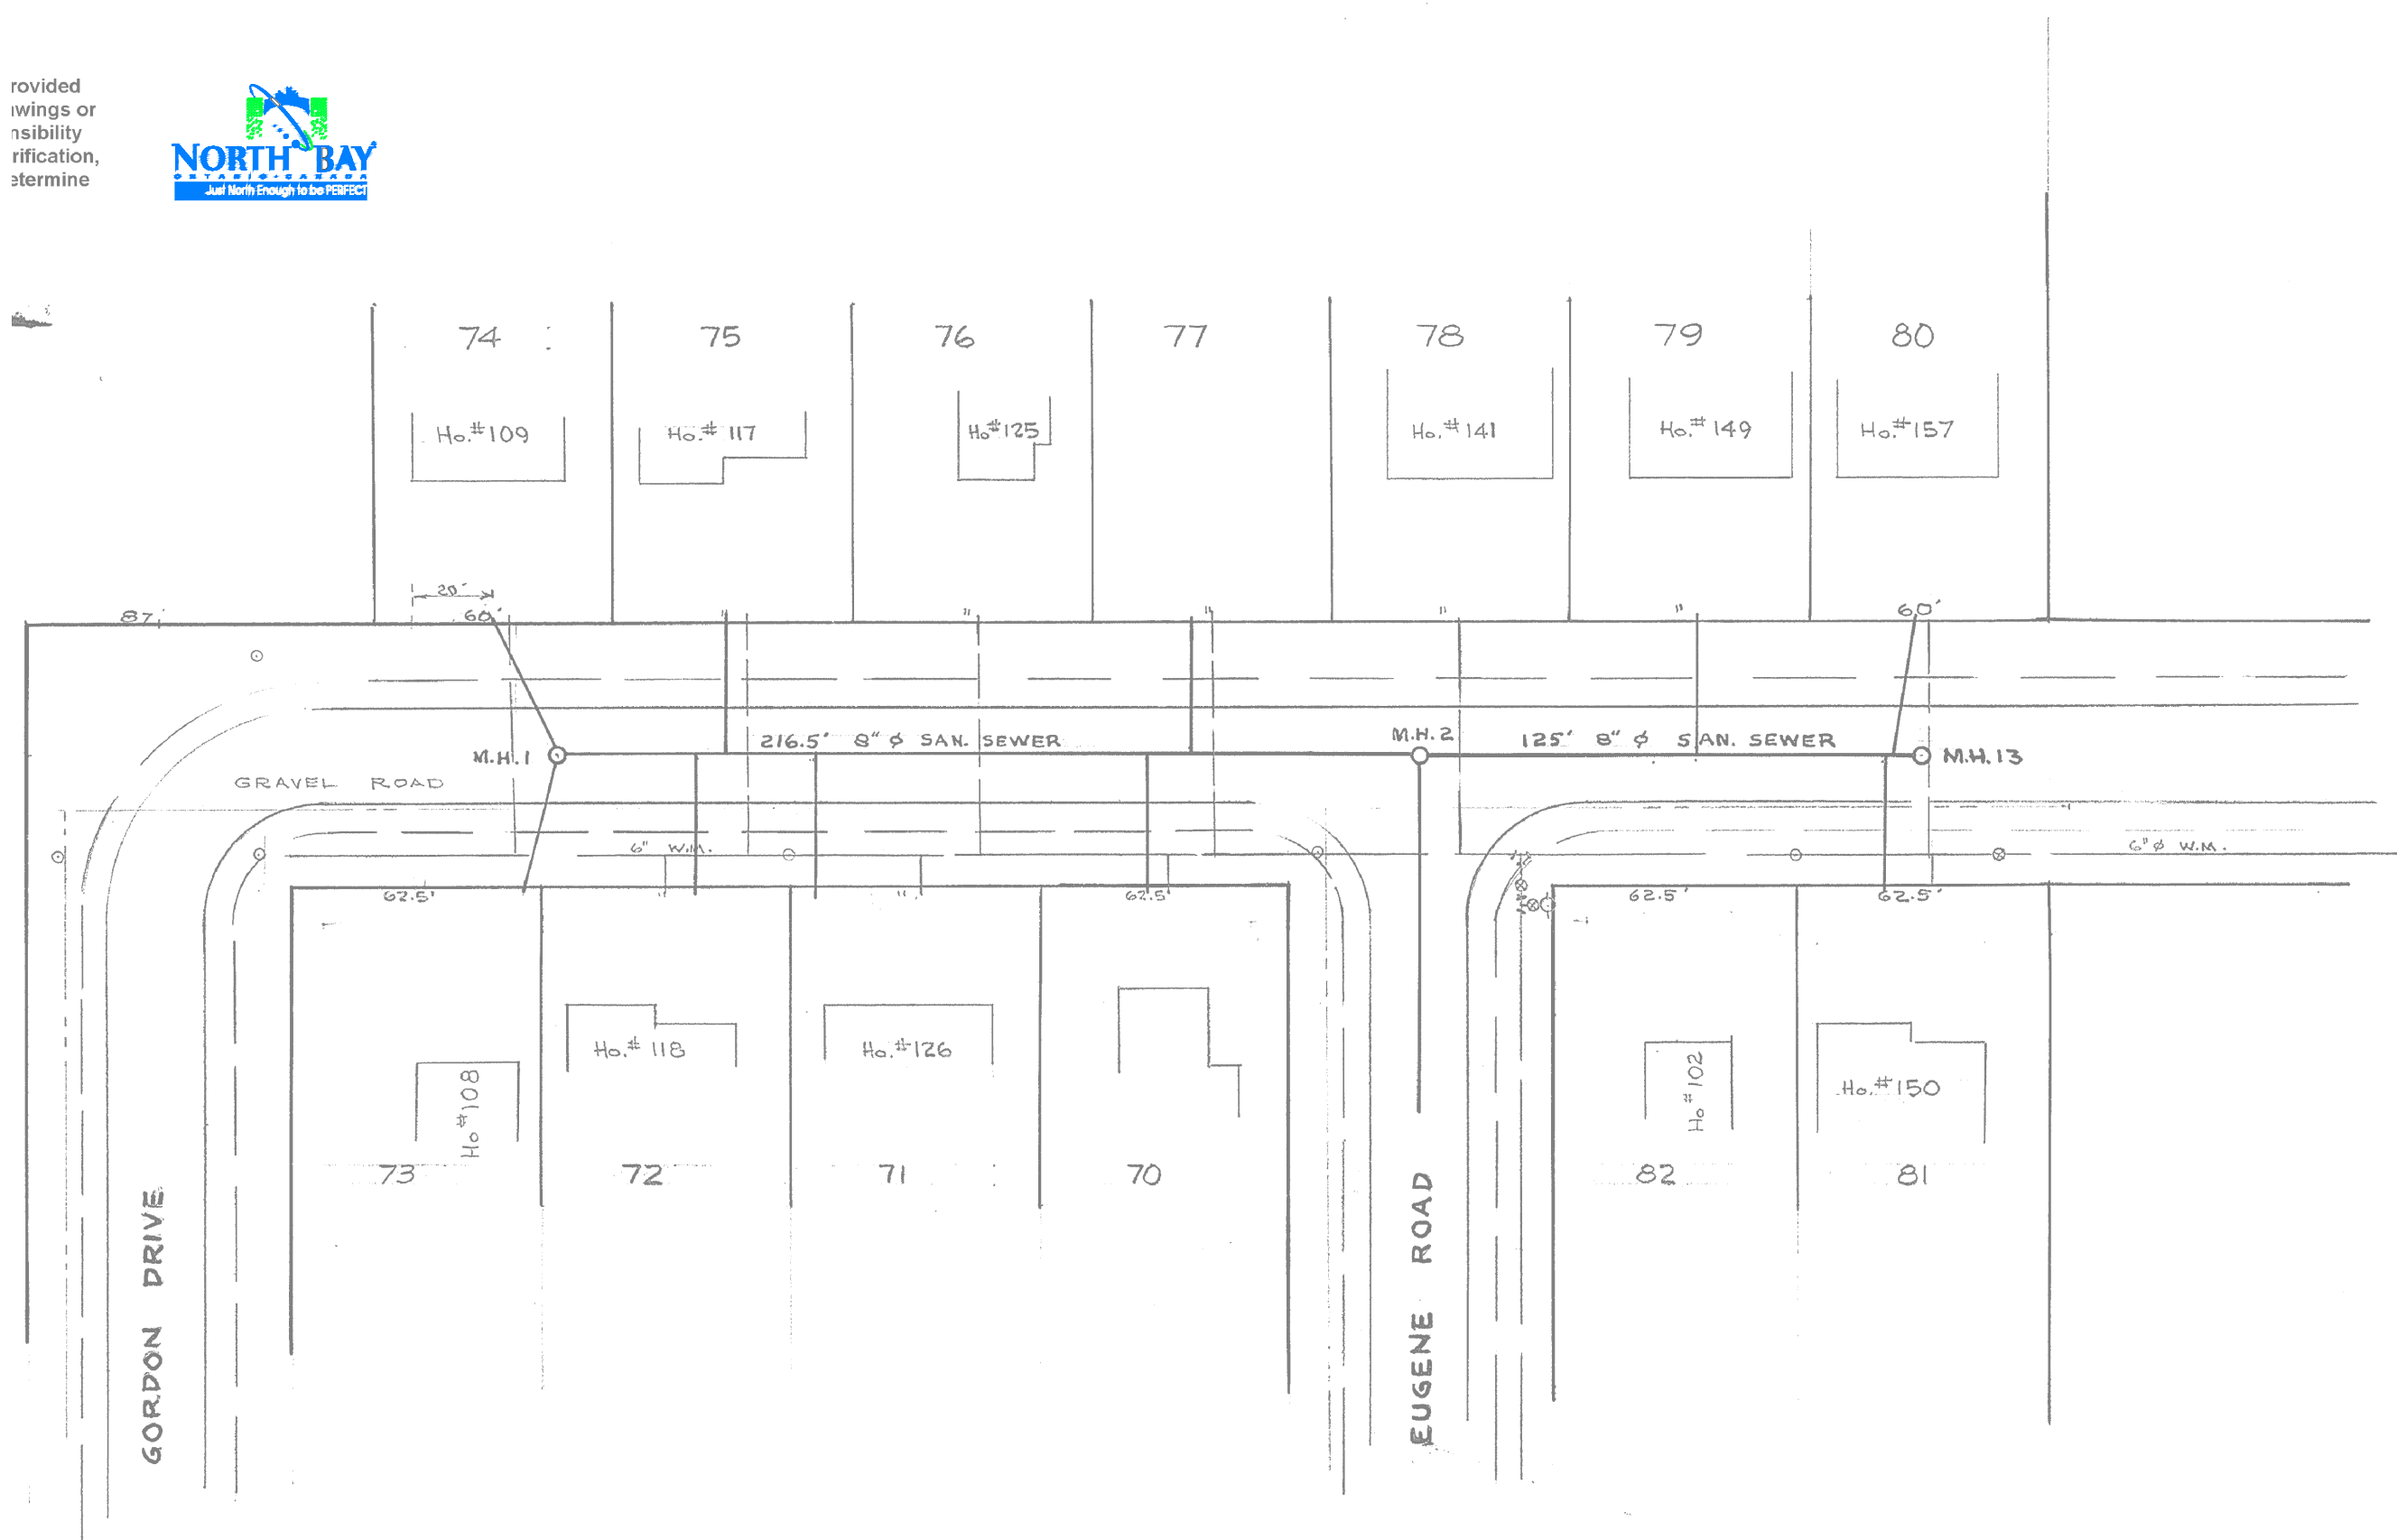


GRANITE STREET



DOROTHY STREET

STREET

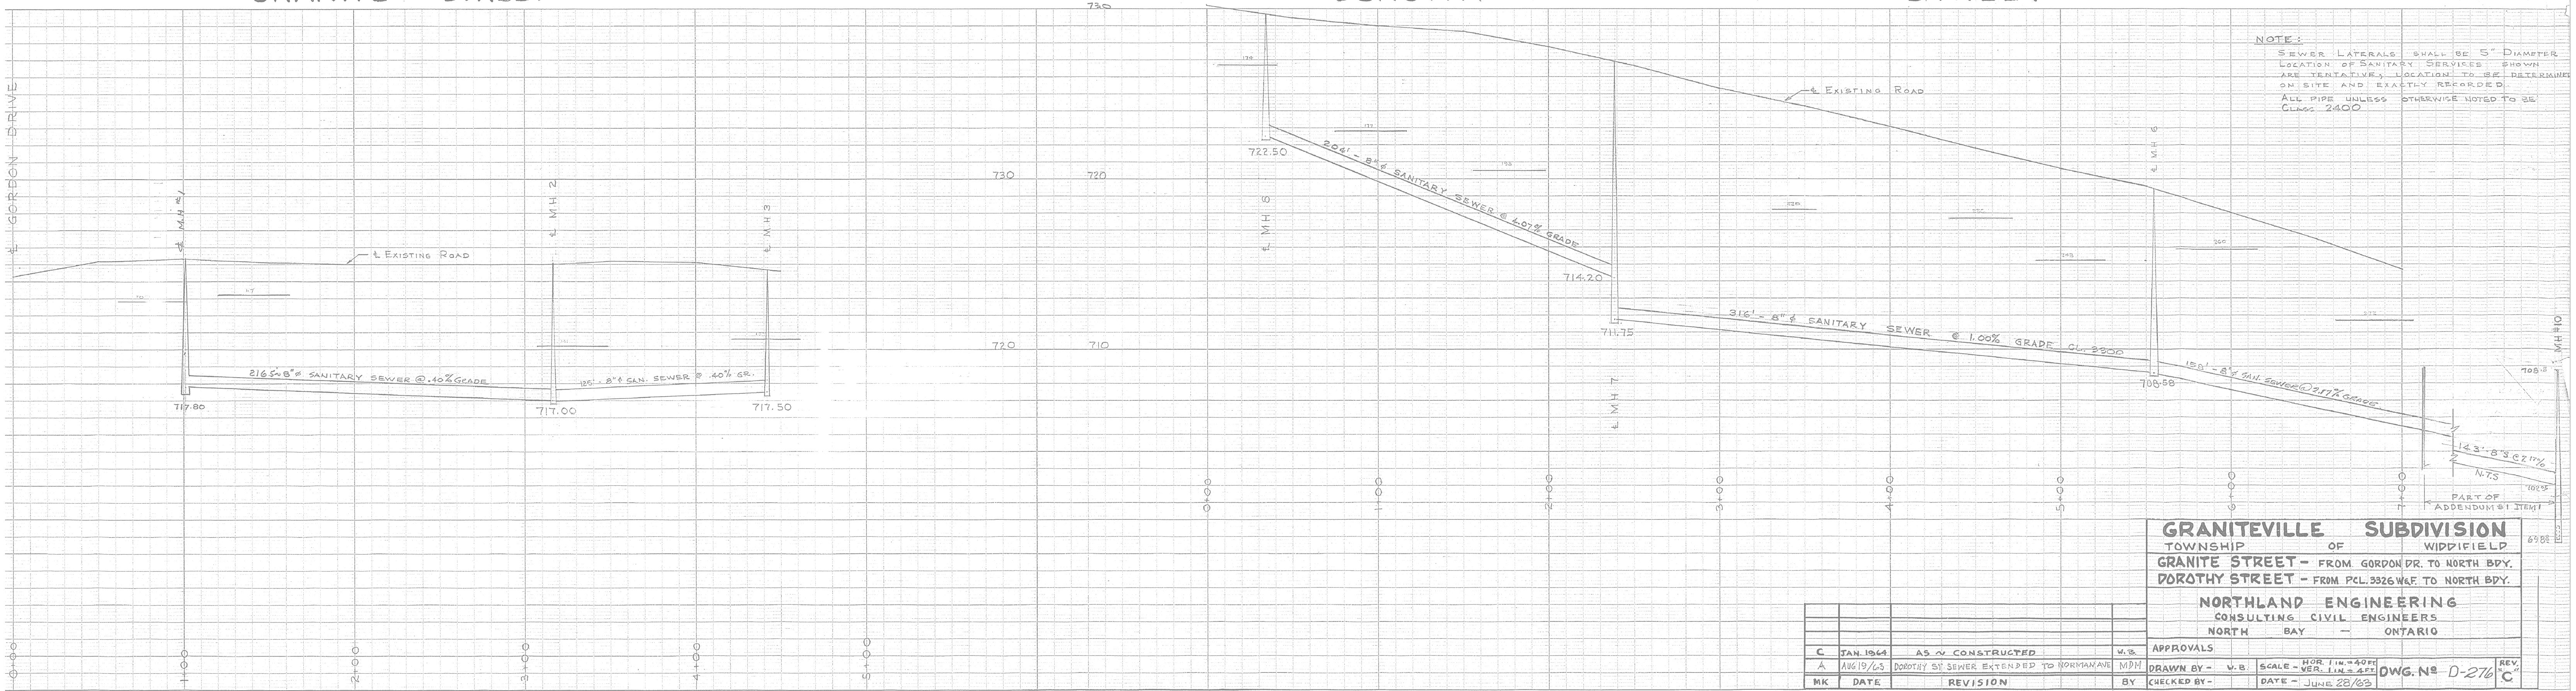

GRANITEVILLE SUBDIVISION
TOWNSHIP OF WIDDIFIELD
GRANITE STREET - FROM GORDON DR. TO NORTH BDY.
DOROTHY STREET - FROM PCL. 3326 W.F. TO NORTH BDY.

NORTHLAND ENGINEERING
CONSULTING CIVIL ENGINEERS
NORTH BAY - ONTARIO

NO.	DATE	REVISION	BY	CHECKED BY	DATE
C	JAN 1964	AS NOW CONSTRUCTED	V.B.		
A	AUG 19/63	DOROTHY ST. SEWER EXTENDED TO NORMAN AVE	MPH		
MK					

APPROVALS	SCALE - HOR. 1"=40'	DWG. NO. D-276	REV. C
DRAWN BY - V.B.	VER. 1"=4'		
DATE - JUNE 28/63			