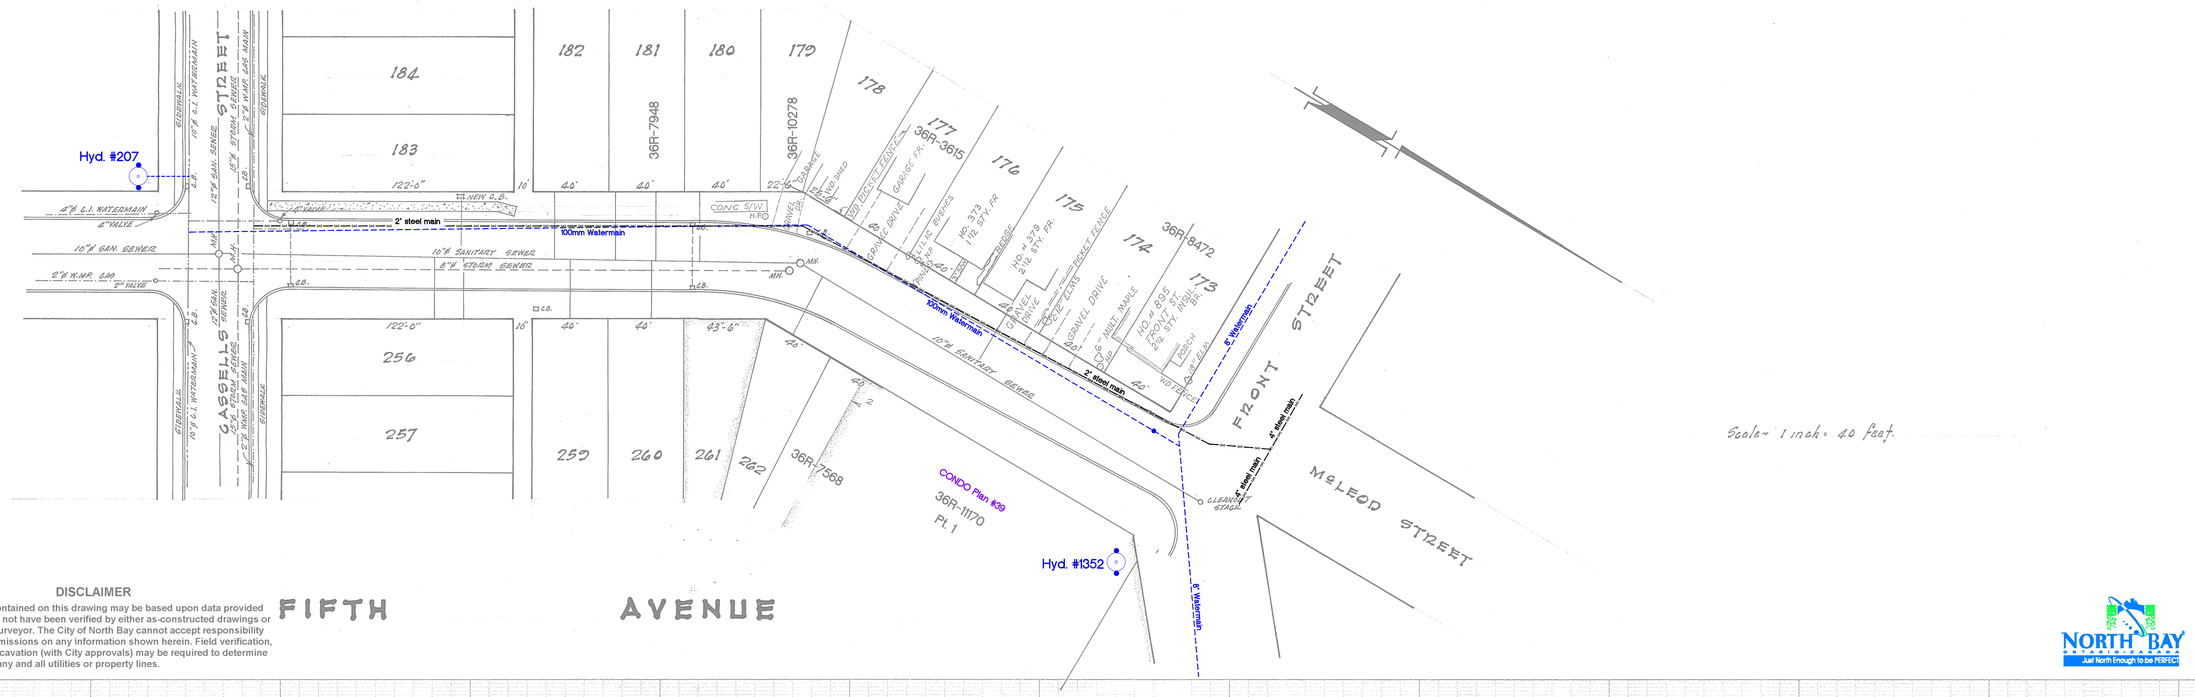

DISCLAIMER

The information contained on this drawing may be based upon data provided by others and may not have been verified by either as-constructed drawings or an Ontario Land Surveyor. The City of North Bay cannot accept responsibility for any errors or omissions on any information shown herein. Field verification, land surveys or excavation (with City approvals) may be required to determine actual location of any and all utilities or property lines.

NORTH BAY ONTARIO CANADA
Just North Enough to be PERFECT

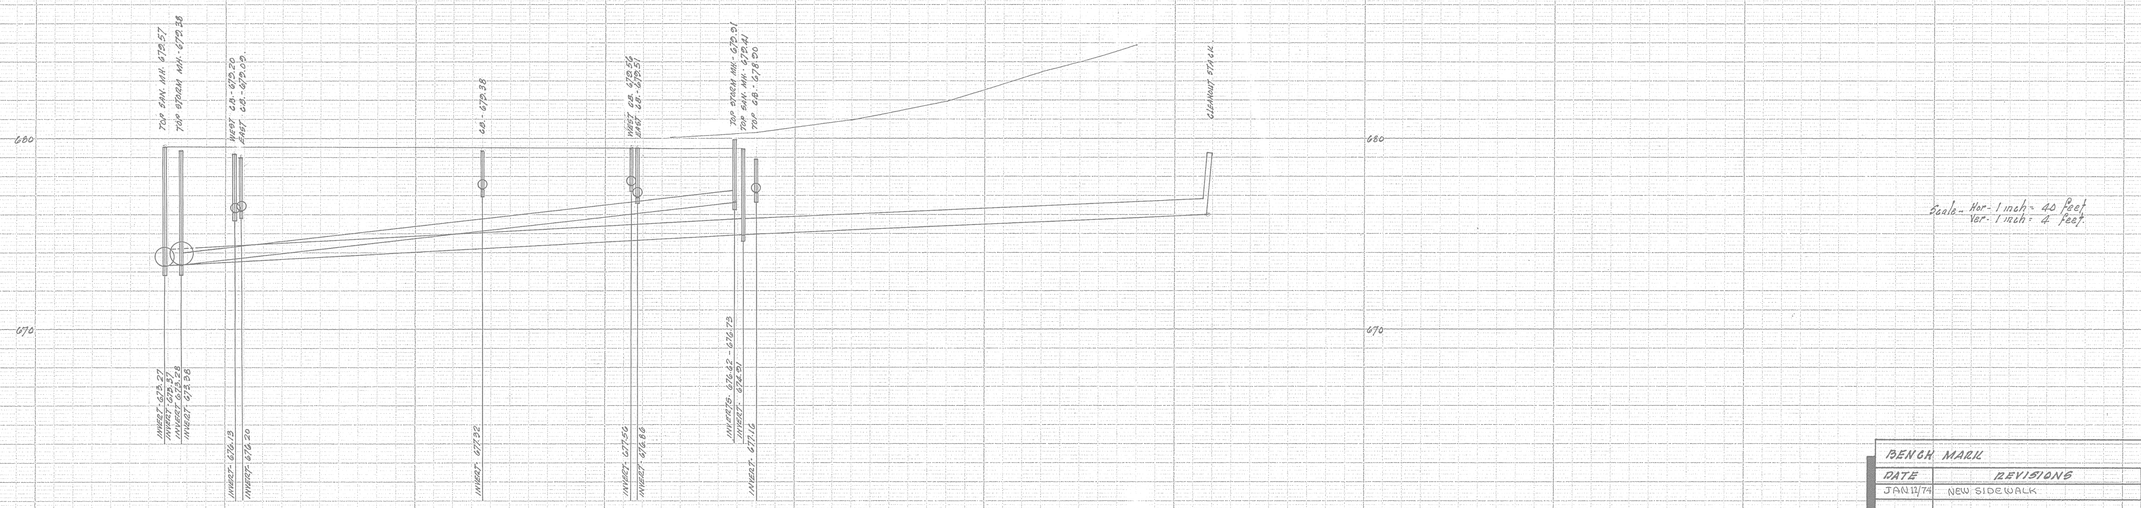

BENCH MARK			
DATE	REVISIONS	DWG. BY.	CHK'D. BY.
JAN 11/74	NEW SIDEWALK		

CORPORATION OF THE CITY OF NORTH BAY • ONTARIO

FIFTH AVENUE
FROM
CASSELLS ST. TO FRONT ST.

DWG. BY.	CHK'D. BY.	DATE	FIELD BOOK No.
B. SAUNDERS		AUG. 31/64	
SCALE AS SHOWN.	APPROVED BY. CITY ENGINEER.		DWG. No. F-101