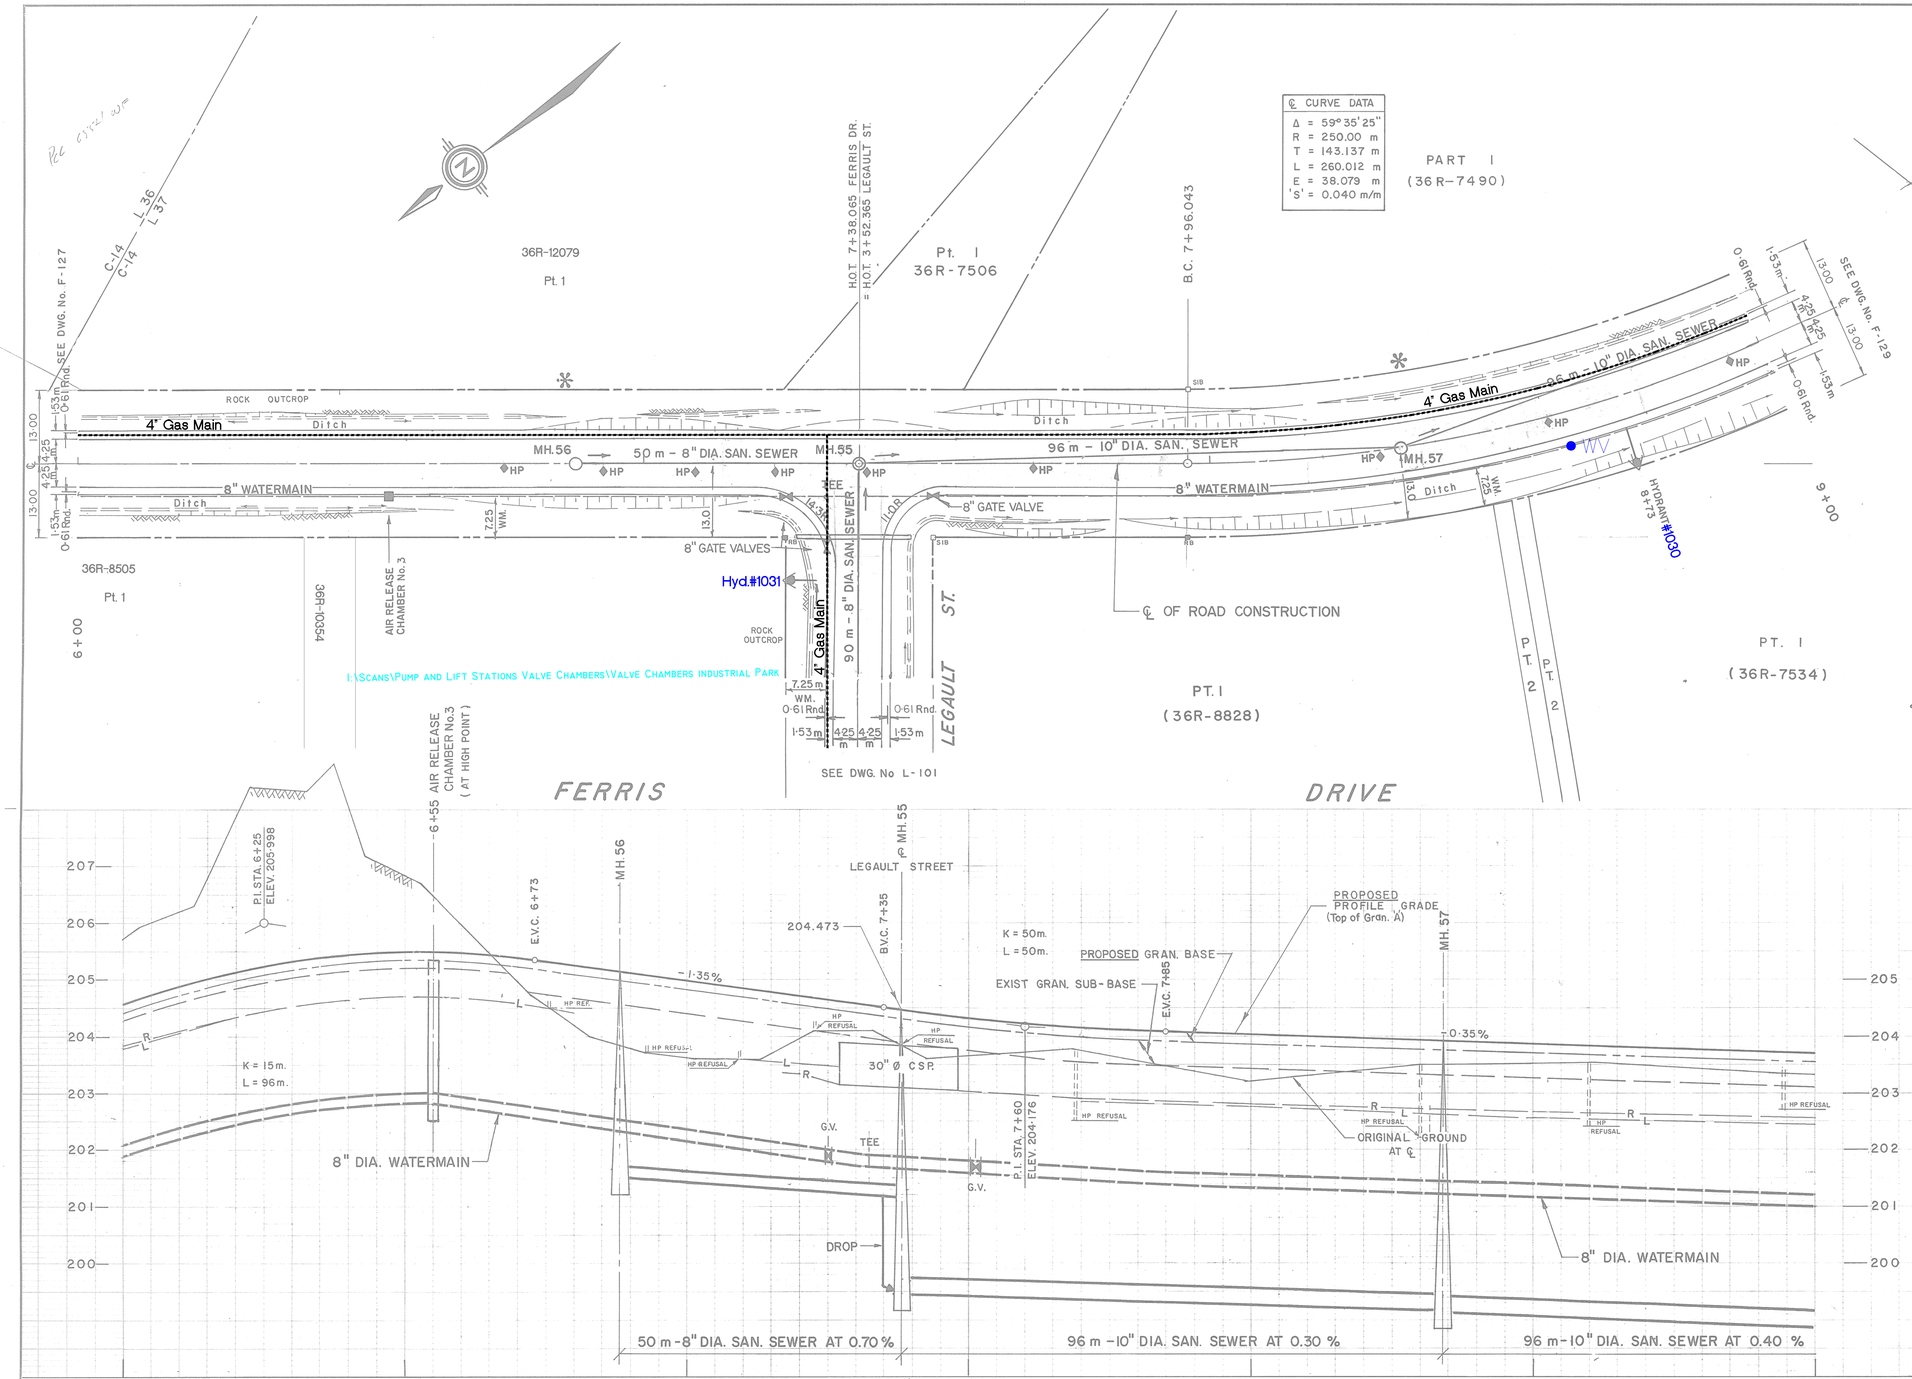

CHAINAGE	6+00	+25	+50	+55	+73 +75	+88	7+00	+25	+35	+38.062	+50	+75	+85	8+00	+25	+34	+50	+75	9+00	CHAINAGE
PROFILE GRADE ELEVATIONS	204.572	205.236	205.484		205.350 203.323		204.986		204.648	204.513	204.334		204.134	204.089	204.036	203.949	203.861	203.774	203.686	PROFILE GRADE ELEVATIONS
DITCH RT.	203.85		204.70						203.35	203.150	203.05		202.90		202.80		202.65		202.55	DITCH RT.
DITCH LT.	203.80		204.70		204.40		203.60		203.50				202.85		202.75		202.55		202.45	DITCH LT.
SAN. INVERTS						201.500				N201.150 W199.584 S199.474						199.186 199.156				SAN. INVERTS
TOP WM.	202.07			+55 203.00					+32.3 201.88				+85 201.59						201.19	TOP WM.

TRANSLAR 500-6-78

DISCLAIMER

The information contained on this drawing may be based upon data provided by others and may not have been verified by either as-constructed drawings or an Ontario Land Surveyor. The City of North Bay cannot accept responsibility for any errors or omissions on any information shown herein. Field verification, land surveys or excavation (with City approvals) may be required to determine actual location of any and all utilities or property lines.

NOTES

1. ROAD CONSTRUCTION
   - STA. 5+65 ± TO 6+70 ± — ROCK CUT
   - STA. 6+70 ± TO 10+15 ± — ROCK CUT AND FILL
2. ALL UNDERGROUND UTILITIES ARE COMPLETE WITH THE EXCEPTION OF THE TOPS OF THE MANHOLES WHICH ARE TO BE ADJUSTED, UNDER THIS CONTRACT, TO SUIT THE FINAL PAVEMENT ELEVATIONS.
3. RIGHT OF WAY GRADING IS COMPLETE WITH THE EXCEPTION OF THE INSTALLATION OF THE GRANULAR BASE.

✻ INDICATES 6" SANITARY AND 6" WATER SERVICES

ALL DIMENSIONS SHOWN ARE IN METRIC VALUES UNLESS NOTED OTHERWISE

REVISIONS

DATE	DETAILS	BY
FEB. '82.	REVISED TO CONTRACT No. 2	E.A.C.
Mar '11	Added WV as per P/W	G.W.C.

RECOMMENDED BY | APPROVED BY

CITY OF NORTH BAY
DEPARTMENT OF REGIONAL ECONOMIC EXPANSION AND MINISTRY OF NORTHERN AFFAIRS

INDUSTRIAL PARK

FERRIS DRIVE
STA. 6+00 TO STA. 9+00

NORTHLAND ENGINEERING LTD.
Consulting Engineers and Planners
NORTH BAY SUDBURY THUNDER BAY

DRAWN BY: D.P. COOPER & B.A.	DATE: NOV. 1980
CHECKED BY: D.R.	FIELD BOOK:
SCALE: HOR. 1 : 500 VERT. 1 : 50	CONTRACT Nº 2
OFFICE NORTH BAY	PROJECT Nº 1877
DRAWING Nº F-128	