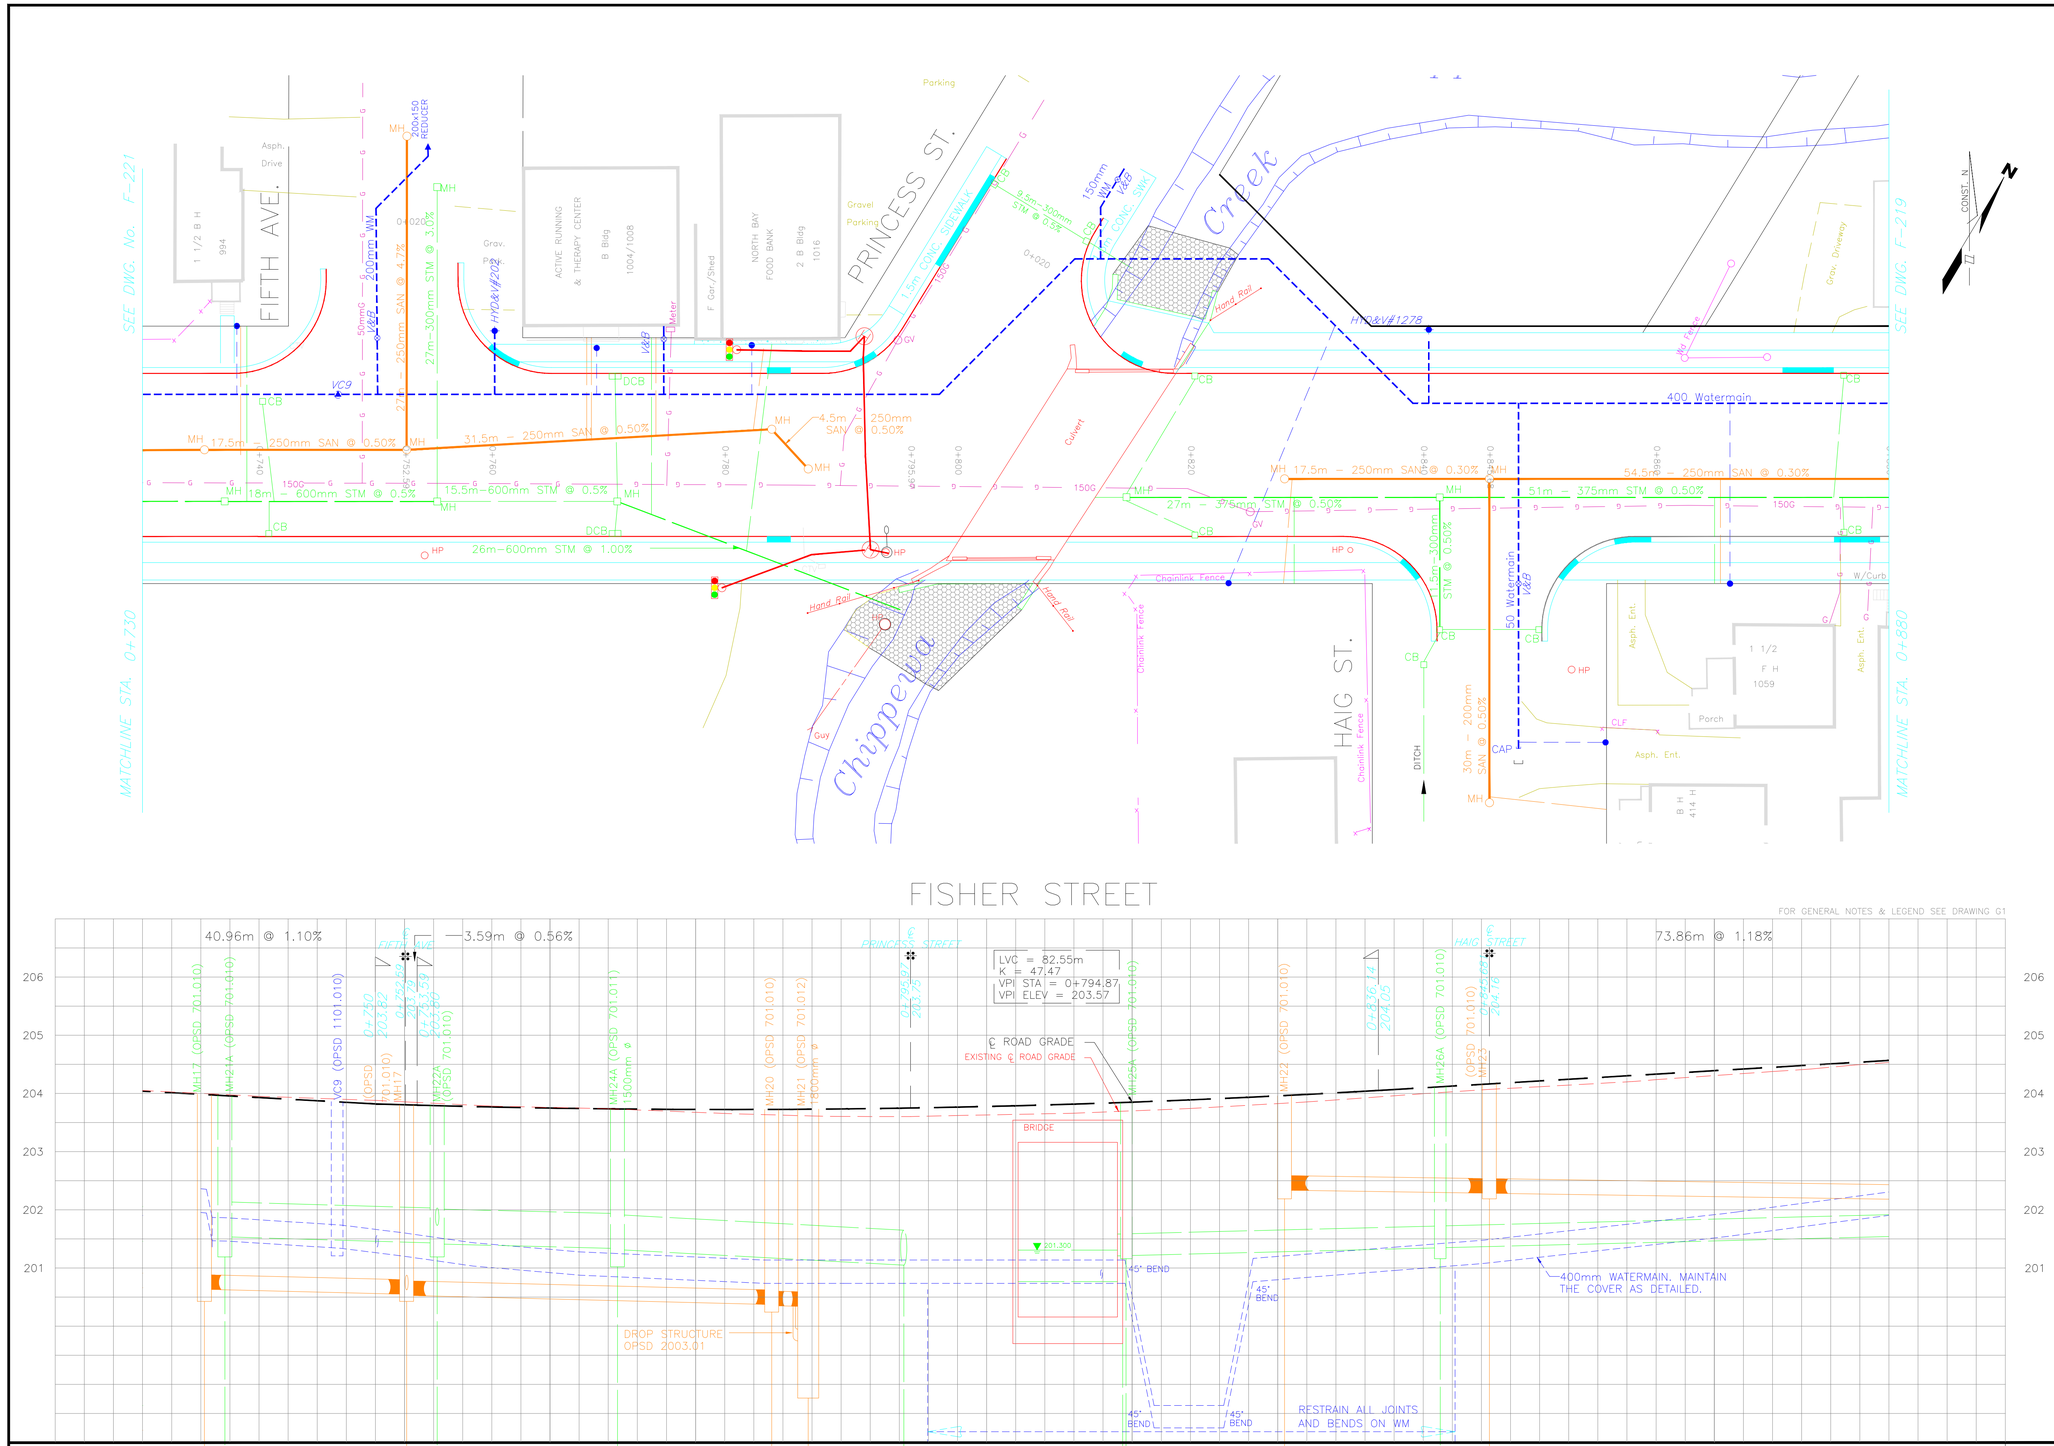

designer | drawn by:
checked by: | approved by:

r e v i s i o n s

no.	date	by	description
1	JUNE 2006	G.Mc.	ISSUED FOR TENDER
2.	DEC 2020	rjo	E-Hydro added (traffic(approx))

The Corporation of the City of North Bay

Tender 2006 – 101
Phase 3

Fisher Street Reconstruction
Main Street to Fifth Avenue

Disclaimer

The information contained on this drawing may be based upon data provided by others and may not have been verified by either as-constructed drawings or an Ontario Land Surveyor. The City of North Bay cannot accept responsibility for any errors or omissions on any information shown herein. Field verification, land surveys or excavation (with City approvals) may be required to determine actual location of any and all utilities or property lines.

FISHER STREET

FOR GENERAL NOTES & LEGEND SEE DRAWING G1

DISCIPLINE

FISHER STREET

STA_0+730_TO
STA_0+880

NORTH BAY ONTARIO · CANADA
Just North Enough to be PERFECT

KMK Consultants Limited

scale
H. 1:250
V. 1:50

file reference | sheet number
date | drawing number
F-220

LEFT-MARGIN-REF.-#:

I:\CAD\PP Drawing\F-220.dwg