


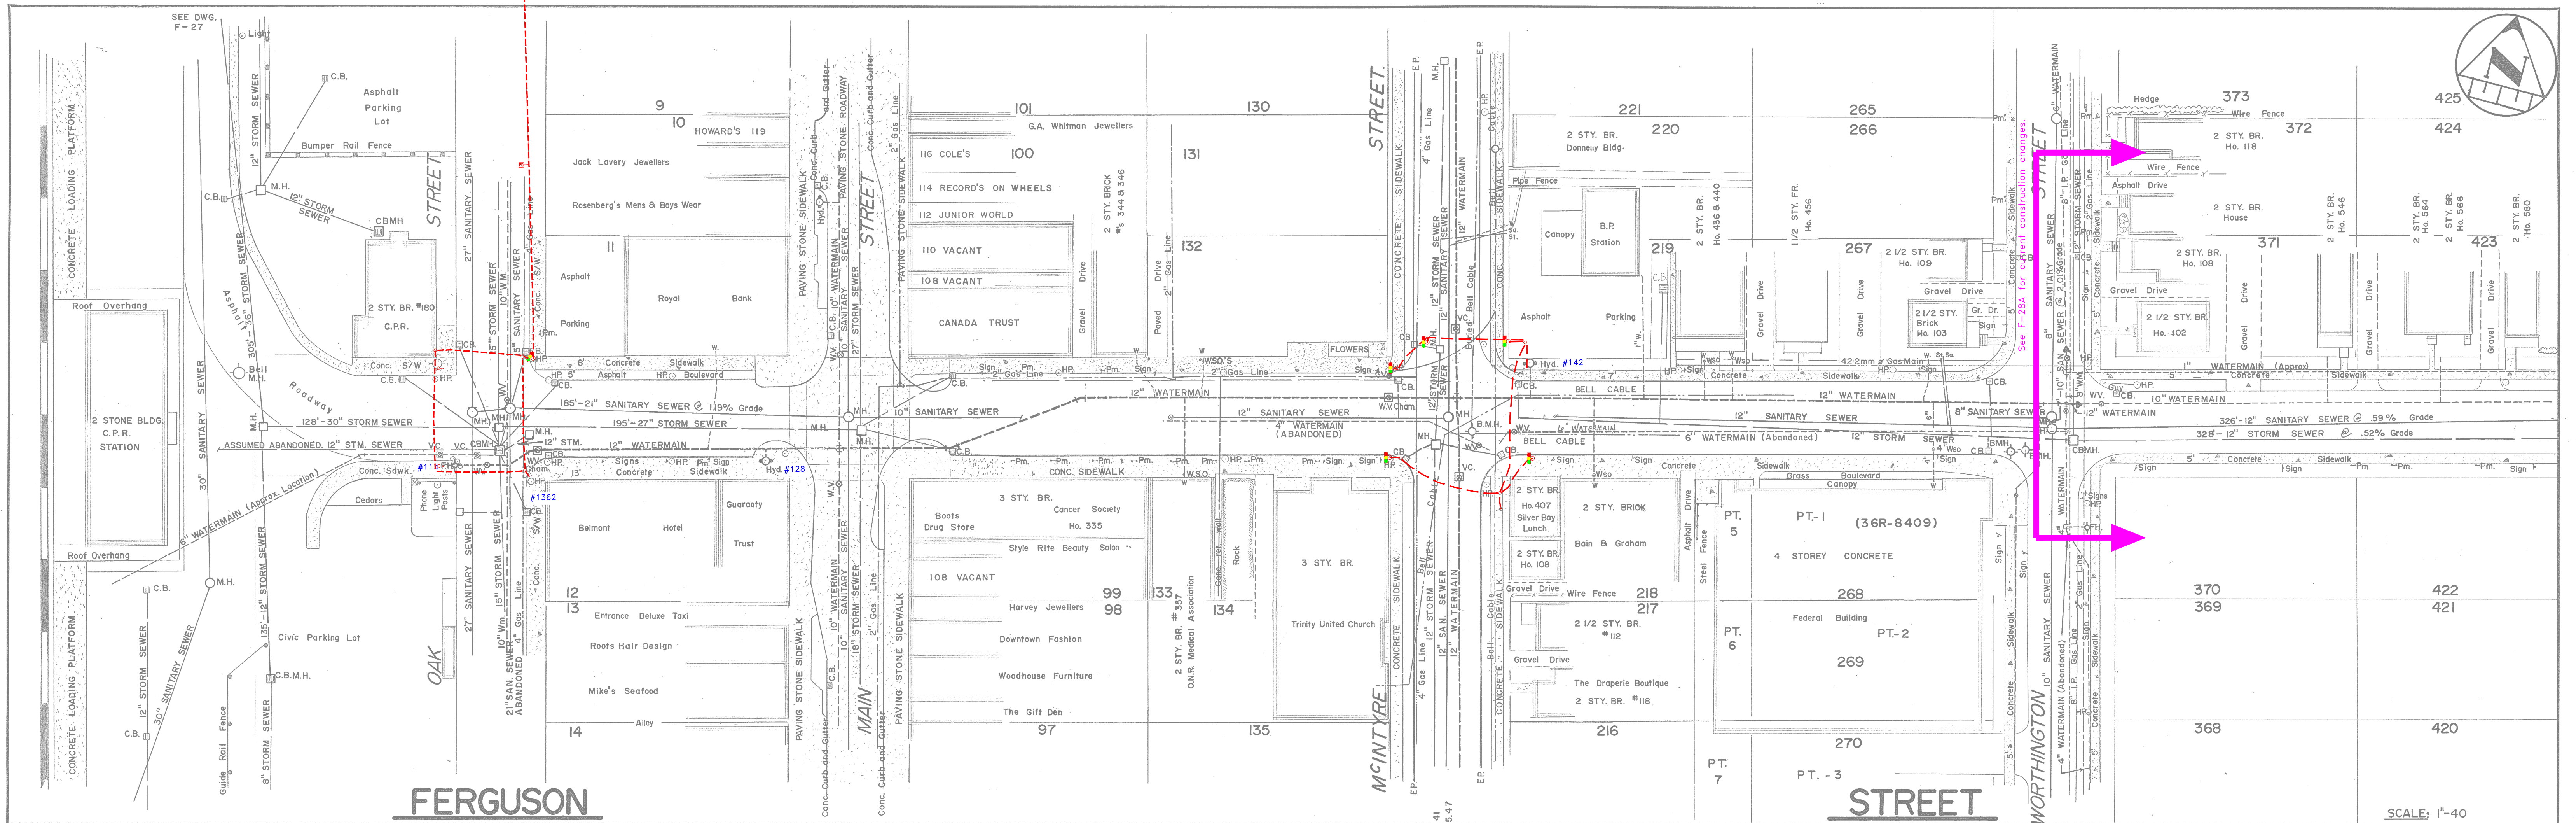

NOTES:		DISCLAIMER		The information contained on this drawing may be based upon data provided by others and may not have been verified by either as-constructed drawings or an Ontario Land Surveyor. The City of North Bay cannot accept responsibility for any errors or omissions on any information shown herein. Field verification, land surveys or excavation (with City approvals) may be required to determine actual location of any and all utilities or property lines.		NORTH BAY Just North Enough to be Perfect	
8. AS CONT'D. 12" Wm & Services From Insp. Diary (119-79)		9. Existing hydro (traffic) approx.		FEB. 87		Rick B.	
1. NEW DRAWING		AUG. 73		APPROVED		FERGUSON STREET	
2. AS CONST'D. 10" Wm (WORTH. TO FIST) 1973		OCT. 77		J.P.		C.P.R. STATION TO WORTHINGTON ST.	
3. BELL CABLE at INT. of MCINTYRE		MAR. 79		J.S.		REG'D PLAN NO: 10 & 21	
4. 12" WATERMAIN (Proposed) OAK to WORTHINGTON 09-79		MAY 82		J.S.		SCALE: AS SHOWN	
5. AS CONST. STORM SEWER (Oak to Main) Contract 119-79		MAY 82		J.S.		DATE: AUG. 73	
6. REVISE CURB DETAIL AT MAIN ST.		FEB. 84		J.S.		DRAWN BY: R.B.M.	
7. AS CONST. STM. SEWER (Main to C.P.R. Stn.) BK. 265		SEPT. 86		J.S.		FIELD BOOK No. 224	
No.		REVISION		DATE		DRAWING No. F-28	
						REY.	