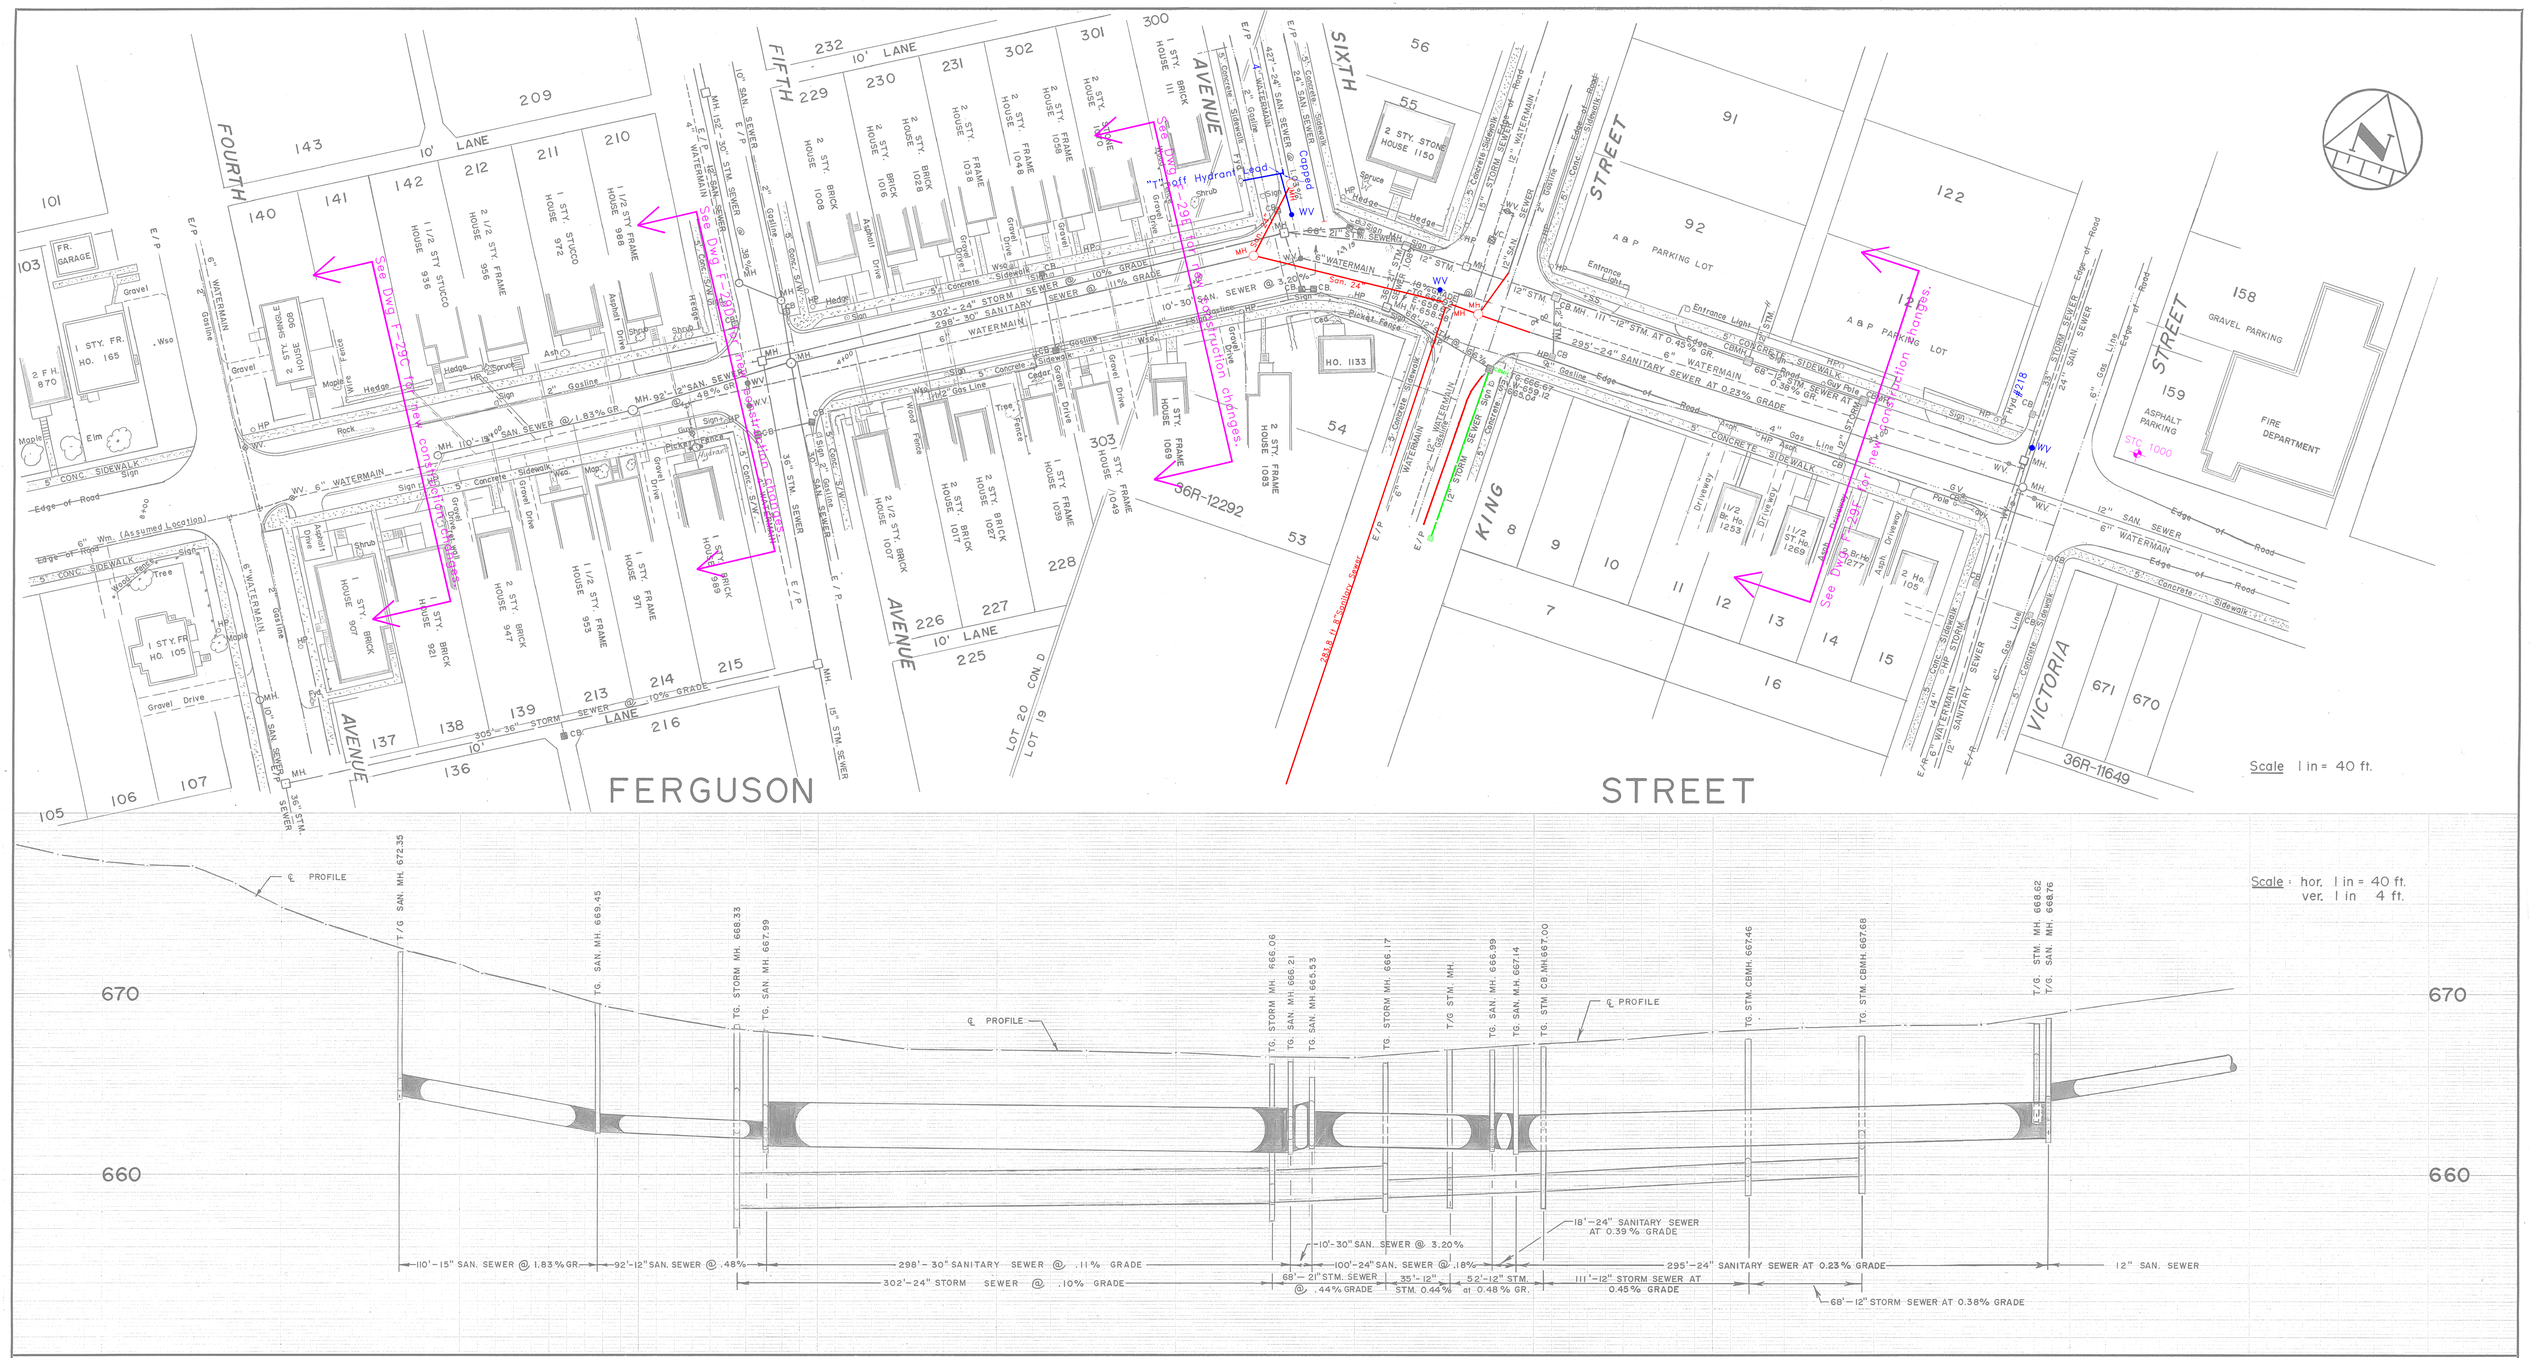

CHAINAGE	GROUND EL	INVERT
8+25	677.72	
8+00	677.28	
7+75	677.07	
7+50	677.02	
7+25	676.09	
7+00	674.79	
6+75	673.81	
6+50	673.04	
6+33	672.38	S-664.63 E-664.38
6+29		
6+00	671.45	
5+50	670.21	
5+23		W-662.37 E-662.37
5+00	668.90	
4+50	668.50	N-662.25 S-658.23
4+45		W-661.93 S-658.11
4+29		N-661.93 S-658.11
4+00	667.62	
3+50	666.93	
3+00	666.90	
2+50	666.83	
2+00	666.79	
1+50	666.51	W-658.42 S-658.42
1+47		W-658.42 S-658.42
1+36		W-658.26 E-658.26
1+24		N-661.90 W-661.88
1+00	666.43	W-661.88 E-661.88
0+83		W-658.72 S-658.72
0+50	666.97	W-658.88 S-658.88
0+48		E-658.88
0+33	666.97	W-661.49 S-661.49
0+23		W-661.47 S-661.47
0+09	667.15	W-661.46 S-661.46
0+00		W-661.42
0+05		W-659.20 S-659.20 E-659.15
0+50	667.47	
1+00	667.90	
1+16		W-659.66 N-659.66 E-659.66
1+50	668.12	
1+84		W-659.94 S-661.43
2+07	668.26	
2+50	668.35	
2+82		S-665.19 N-665.94
2+88		W-662.01 S-663.06 E-663.06
3+00	669.14	E-664.10

NOTES:

DISCLAIMER

The information contained on this drawing may be based upon data provided by others and may not have been verified by either as-constructed drawings or an Ontario Land Surveyor. The City of North Bay cannot accept responsibility for any errors or omissions on any information shown herein. Field verification, land surveys or excavation (with City approvals) may be required to determine actual location of any and all utilities or property lines.

NORTH BAY — Just North Enough to be PERFECT

No.	REVISION	DATE	INITIAL
8	Update SAN and Water at Sixth and Ferguson as per PW	DEC. 09	G.W.C.

No.	REVISION	DATE	INITIAL
1	NEW DRAWING	MAY/75	JDM.
2.	AS-CONSTRUCTED SAN. & STORM SEWER	MAR. 76	R.F.B.
3	HYDRO LINE REMOVAL	JULY 78	j.d.m.
4	℄ REVISED FROM 3+50 TO 12+00 BK 256-1980	FEB. 80	R.F.B.
5.	REVISED 6" WATERMAIN @ FOURTH AVE.	FEB. 80	A.P.
6.	ADDED DETAIL KING TO VICTORIA (KING TO VICTORIA)	APR. 80	j.d.m.
7.	AS CONST'D SAN. & STM. SEWERS ONLY Bk. 267	MAY 83	J.S.

APPROVED

FERGUSON STREET

FOURTH AVENUE TO VICTORIA STREET

REG'D PLAN Nº: 103, 57, 48, 62.

CITY OF NORTH BAY

ENGINEERING DEPARTMENT

SCALE: AS SHOWN

DATE: MAY. 1975

DRAWN BY: JM

CK'D. BY:

FIELD BOOK No. 241, 194

DRAWING No. F-30

REV.