

ALEX. McDONALD
108' 0" 0"
11' N.P.T.

SAVANNA
108' 0" 0"
11' N.P.T.

PUBLIC SCHOOLS
264' 0" 0"
11' N.P.T.

FRANK SCAPPATURA
132' 0" 0"
11' N.P.T.


W.J. ROACH
132' 0" 0"
11' N.P.T.

MRS. L. BUTTI
132' 0" 0"
11' N.P.T.

ST.

ST.

ST.

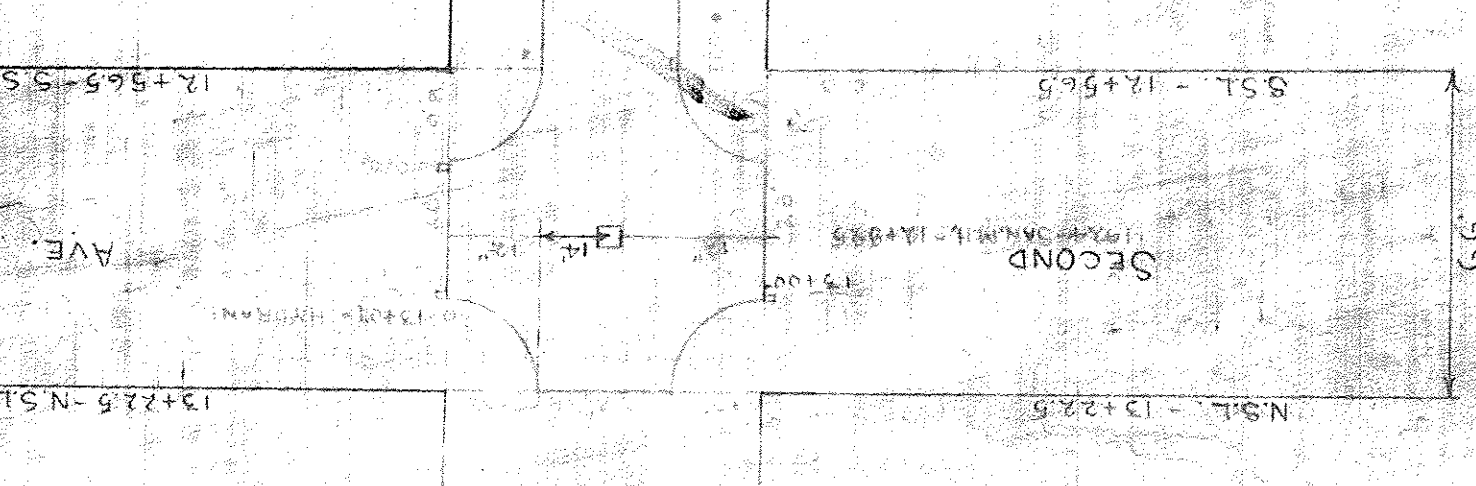

12+24.5 NSL

12+24.5 NSL

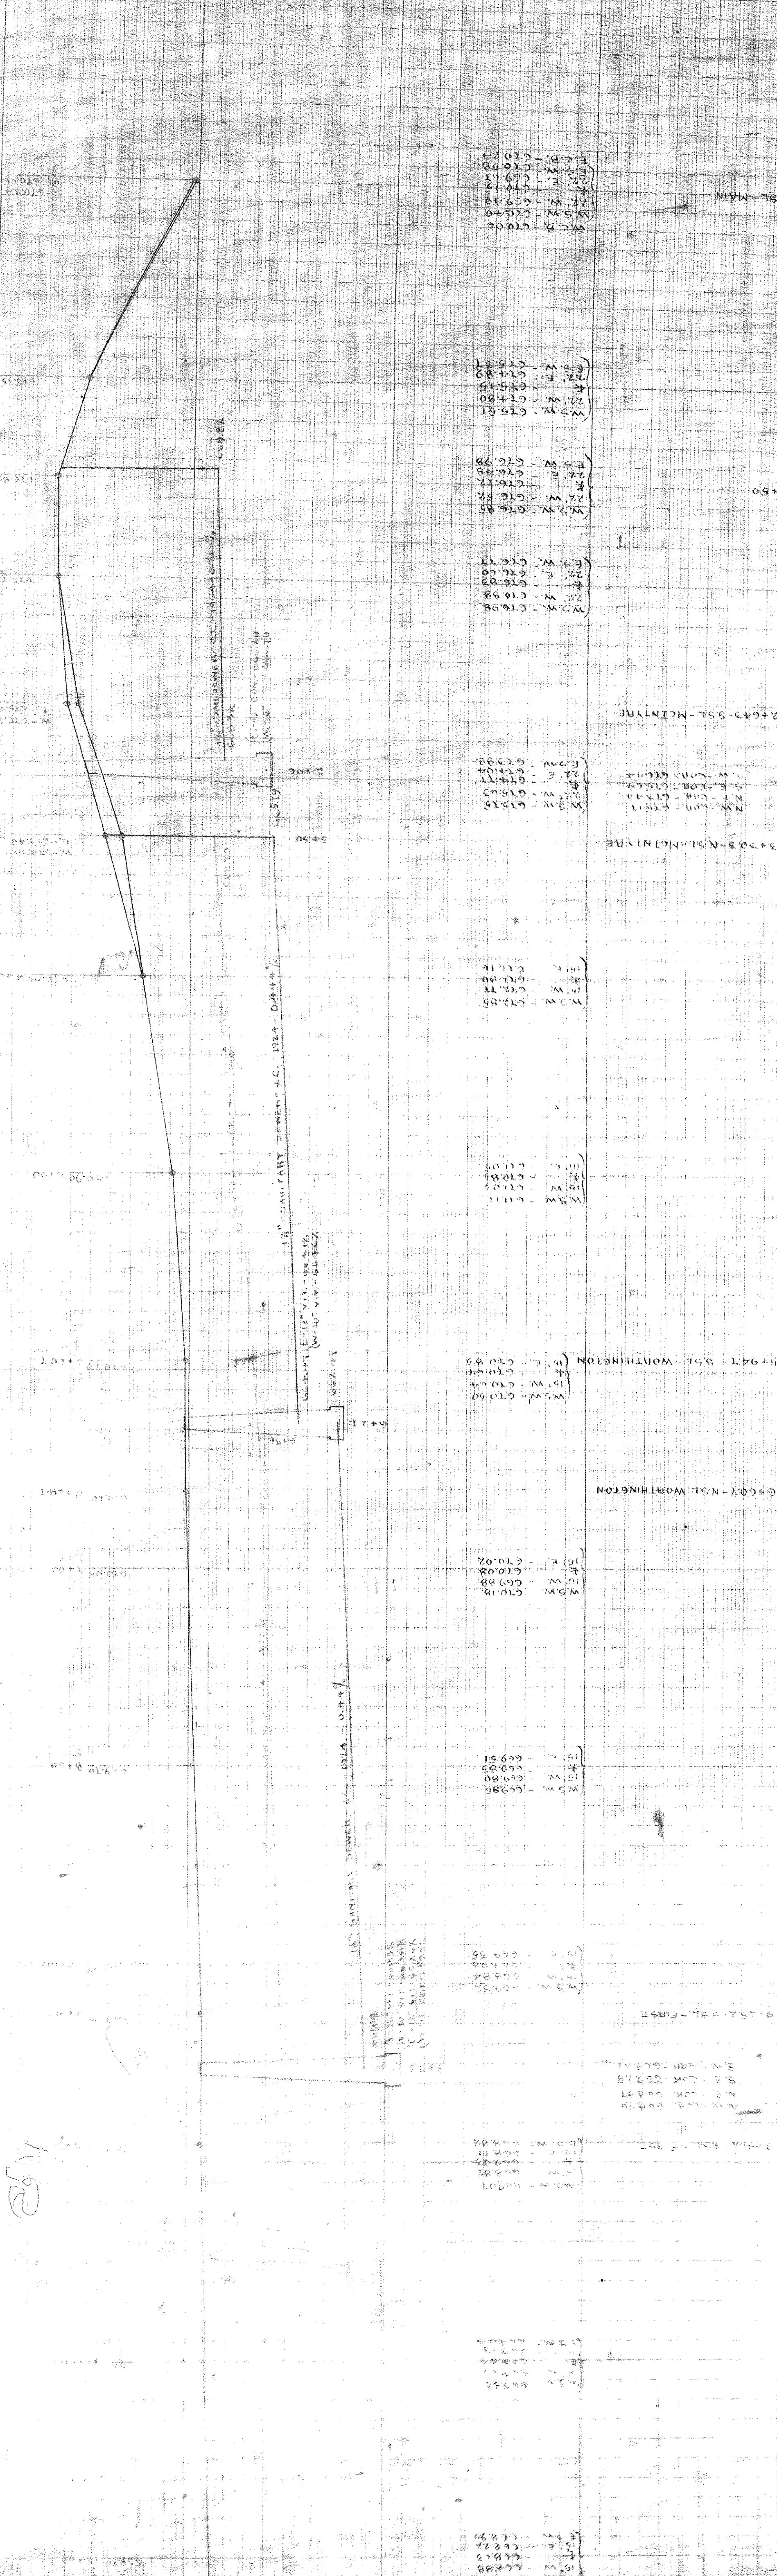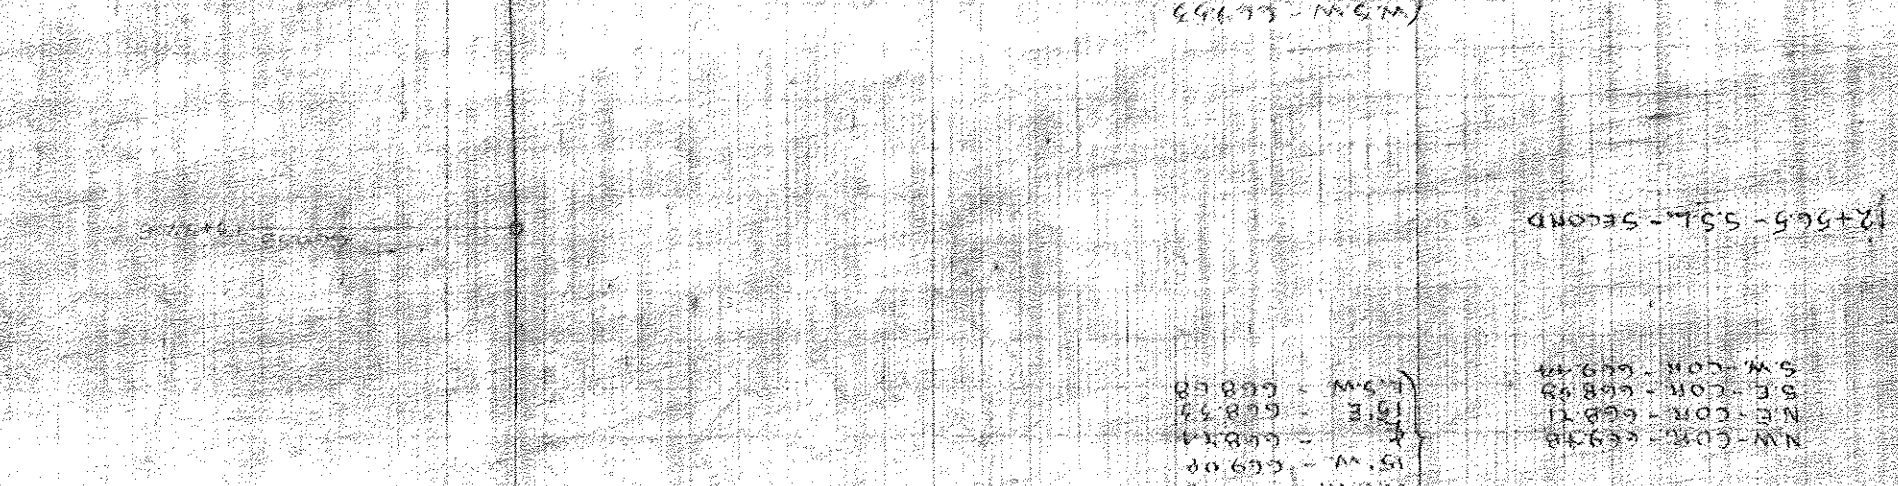

12+24.5 NSL

12+24.5 NSL

DISCLAIMER
The information contained on this drawing may be based upon data provided by others and may not have been verified by either the contractor or the City of North Bay. The City of North Bay cannot accept responsibility for any errors or omissions on any information shown herein. Field verification, land surveys or excavations (with City approval) may be required to determine actual location of any and all utilities or property lines.

PLAN AND PROFILE
OF
PAVEMENT AND UNDERGROUND WORK
ON
FERGUSON ST.
BETWEEN FIRST AVE. AND OAK ST.

Scale:
Hpr. - 1" = 40 ft.
Vert. - 1" = 4 ft.

Town Engineers Office, 1024
12-28