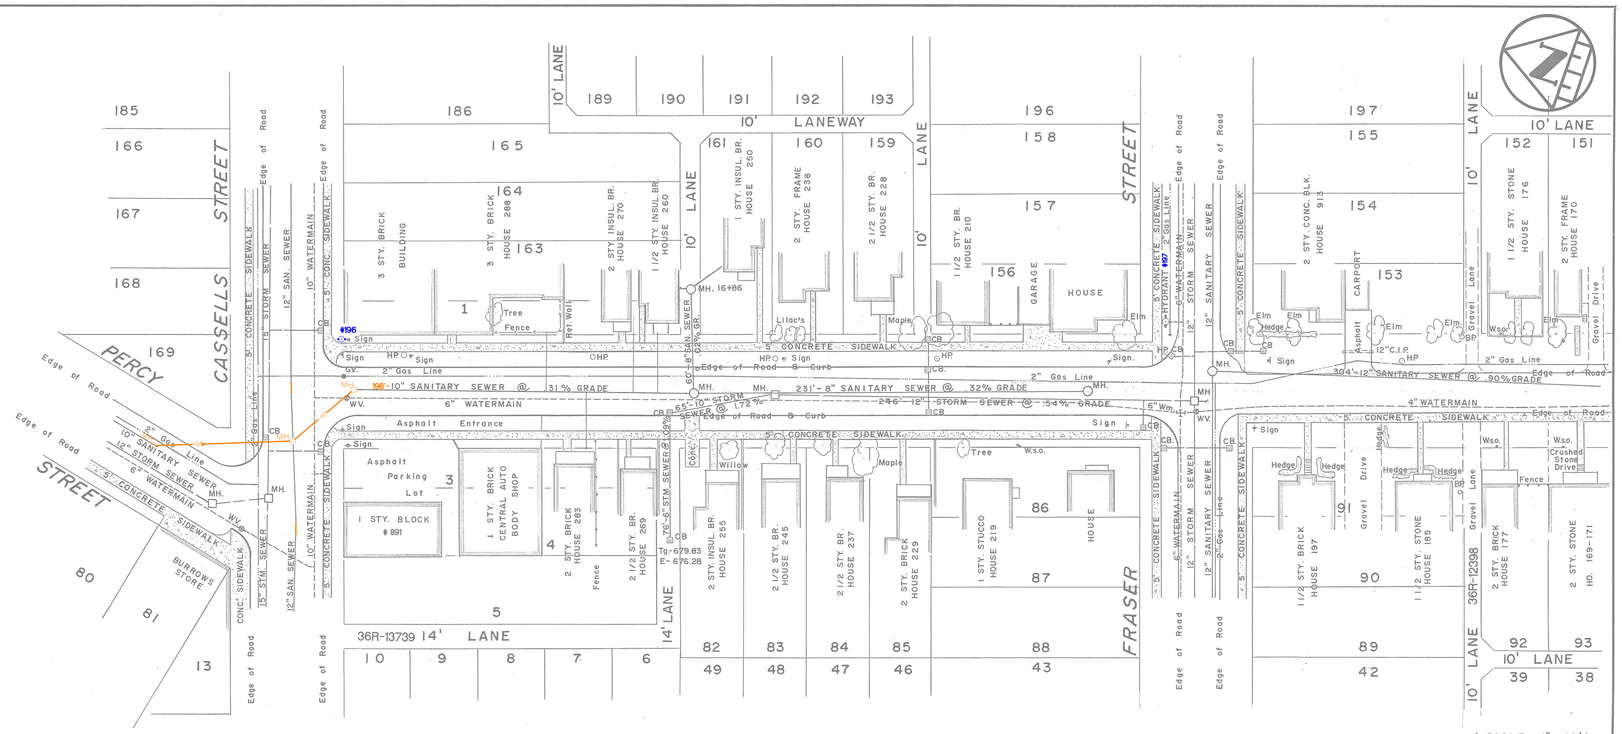

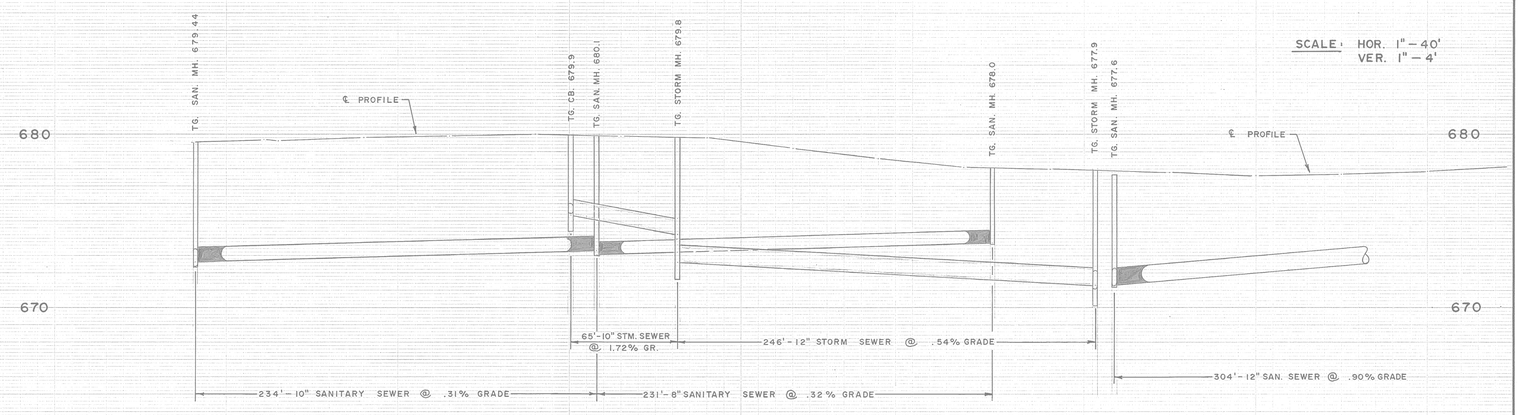

CHAINAGE	GROUND EL	INVERT
20+00		
19+20	679.5	W-672.39 E-672.44 S-672.62
19+18		
19+00	679.7	
18+87	679.6	
18+70	679.8	
18+20	679.8	
17+70	679.9	
17+20	680.0	
16+99		N-675.45 E-675.45
16+86		W-672.93
16+84		N-672.73 E-673.35
16+70	679.9	N-673.34 E-672.64 S-673.04
16+37		N-674.23 S-672.61
16+20	679.8	
15+70	679.2	
15+20	678.6	
14+70	678.1	
14+53		N-673.77
14+20	678.0	
13+93		N-671.28 E-671.08 S-671.18
13+82		W-671.18 E-671.28 S-671.28
13+70	677.8	
13+50	677.8	
13+00	677.60	
12+50	677.71	
12+00	677.85	

NOTES:

DISCLAIMER

The information contained on this drawing may be based upon data provided by others and may not have been verified by either as-constructed drawings or an Ontario Land Surveyor. The City of North Bay cannot accept responsibility for any errors or omissions on any information shown herein. Field verification, land surveys or excavation (with City approvals) may be required to determine actual location of any and all utilities or property lines.

NORTH BAY
Just North Enough to be PERFECT

No.	REVISION	DATE	INITIAL
1.	NEW DRAWING	MAY. 76	R. F. B.
2.	Sanitary sewer update: registered plans added.	Oct. 07	r.j.o.

APPROVED

FOURTH AVENUE
STATION 12+00 TO CASSELLS STREET
Reg'd. Plan Nº. 42, 48

CITY OF NORTH BAY
ENGINEERING DEPARTMENT

SCALE: AS SHOWN
DATE: MAY 76.
DRAWN BY: RFB
CK'D. BY:
FIELD BOOK No. 178, 242,
DRAWING No. F – 78
REV.

DWG. No.