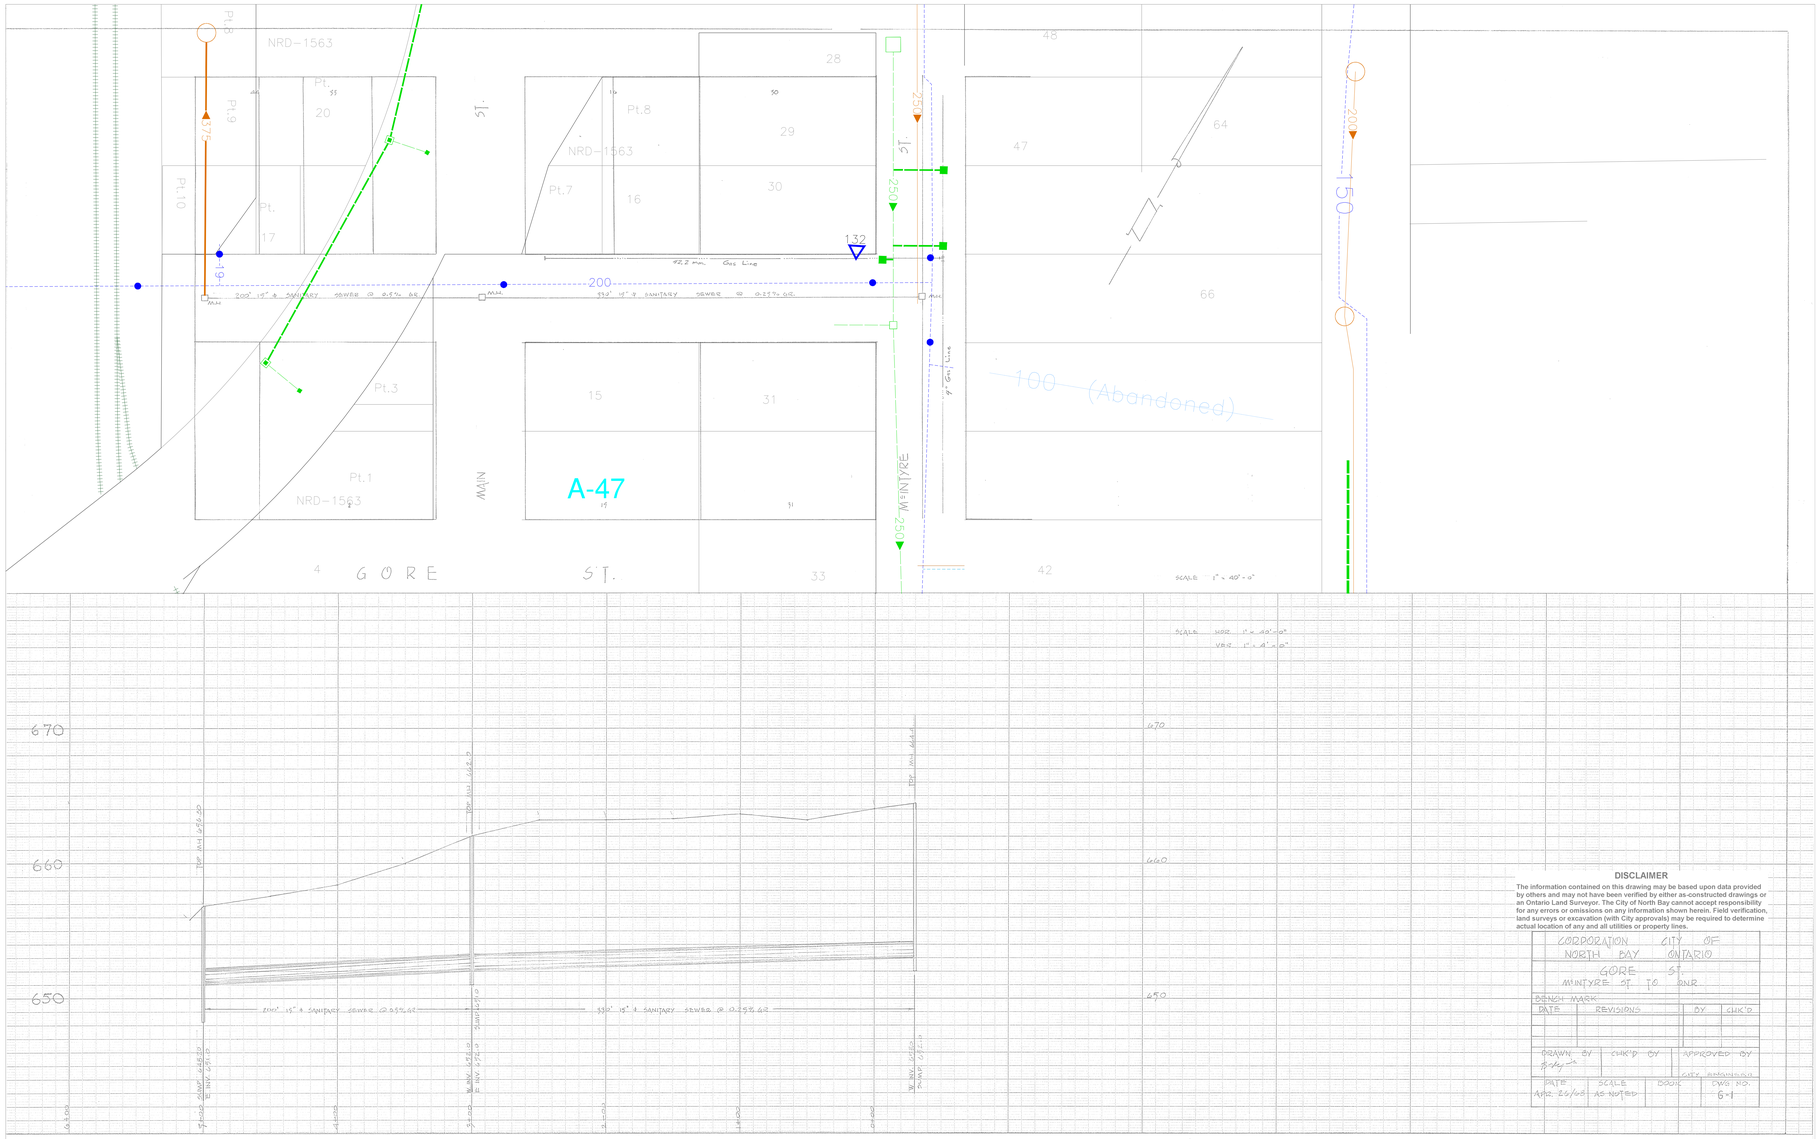
NRD-1563
Pt.8
Pt.9
Pt.10
Pt.7
Pt.3
Pt.1
20
17
28
29
30
16
15
31
33
48
47
64
66
42
4
172
196
200
132
252
260
150
100 (Abandoned)
A-47
MAIN ST.
MCINTYRE ST.
GORE ST.
200' 15" ø SANITARY SEWER @ 0.5% GRADE
330' 15" ø SANITARY SEWER @ 0.25% GRADE
Gas Line
SCALE 1" = 40'-0"
VERT. 1" = 4'-0"
670
660
650
TOP INV. 658.20
TOP INV. 658.0
TOP INV. 664.0
200' 15" ø SANITARY SEWER @ 0.5% GRADE
330' 15" ø SANITARY SEWER @ 0.25% GRADE
(4.00)
(14.00)
(24.00)
(34.00)
(44.00)
(54.00)
(64.00)
