




SCALE: 1" = 40'

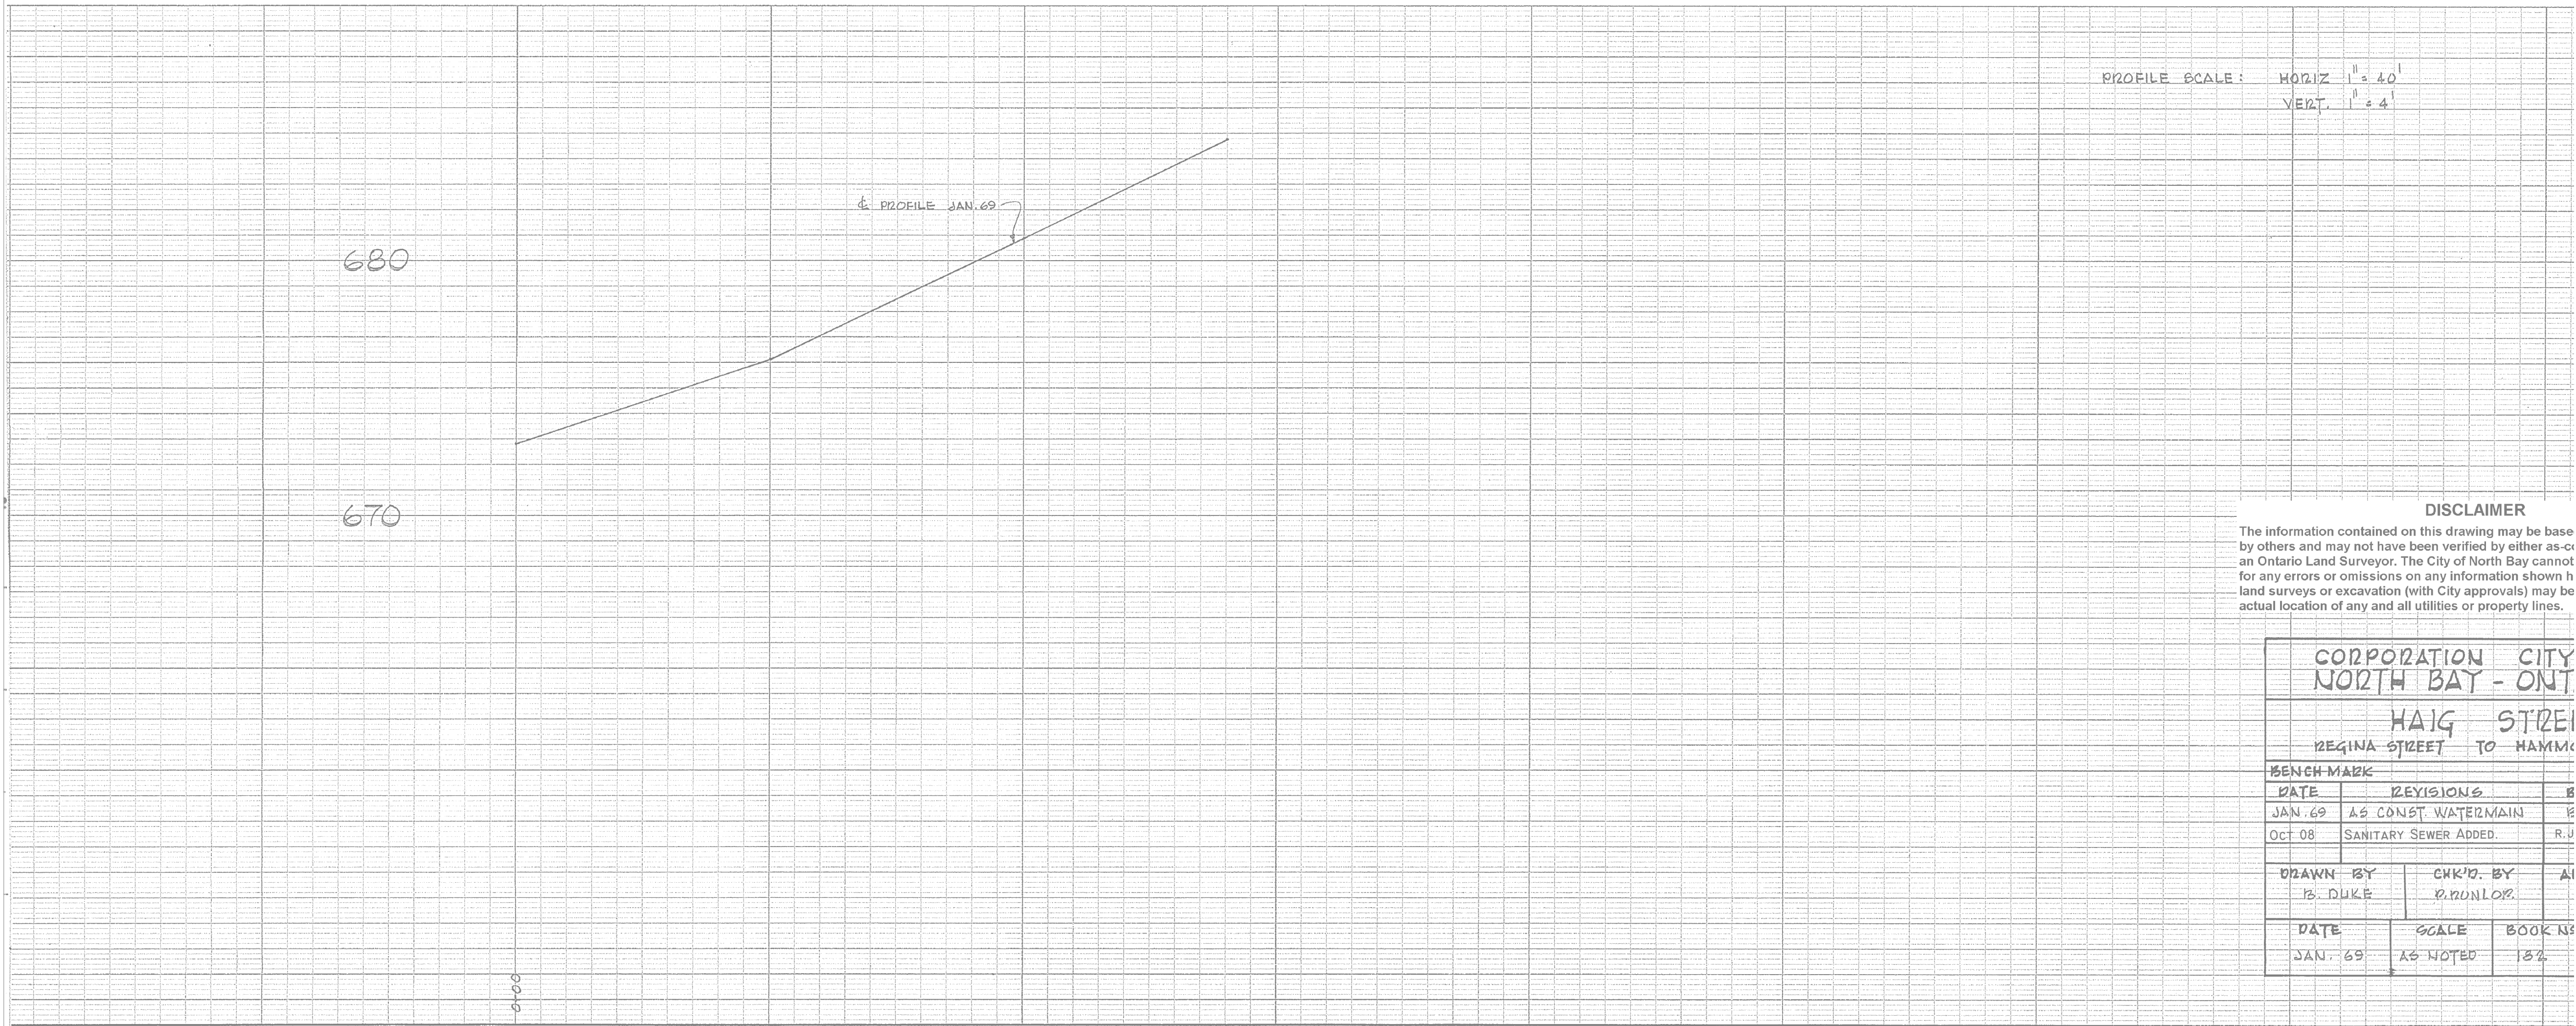

PROFILE SCALE: HORIZ 1" = 40'
VERT. 1" = 4'

DISCLAIMER

The information contained on this drawing may be based on information provided by others and may not have been verified by either as an Ontario Land Surveyor. The City of North Bay cannot be held responsible for any errors or omissions on any information shown hereon. The City of North Bay (with City approvals) may be held responsible for the actual location of any and all utilities or property lines.

CORPORATION CITY OF NORTH BAY - ONTARIO		
HAIG STREET		
REGINA STREET TO HAMMOND STREET		
BENCH-MARK		
DATE	REVISIONS	BY
JAN. 69	AS CONST. WATERMAIN	R.D.
OCT. 08	SANITARY SEWER ADDED	R.D.
DRAWN BY		CHK'D. BY
R. DUKE		R. DUNLOP
DATE	SCALE	BOOK NO.
JAN. 69	AS NOTED	132