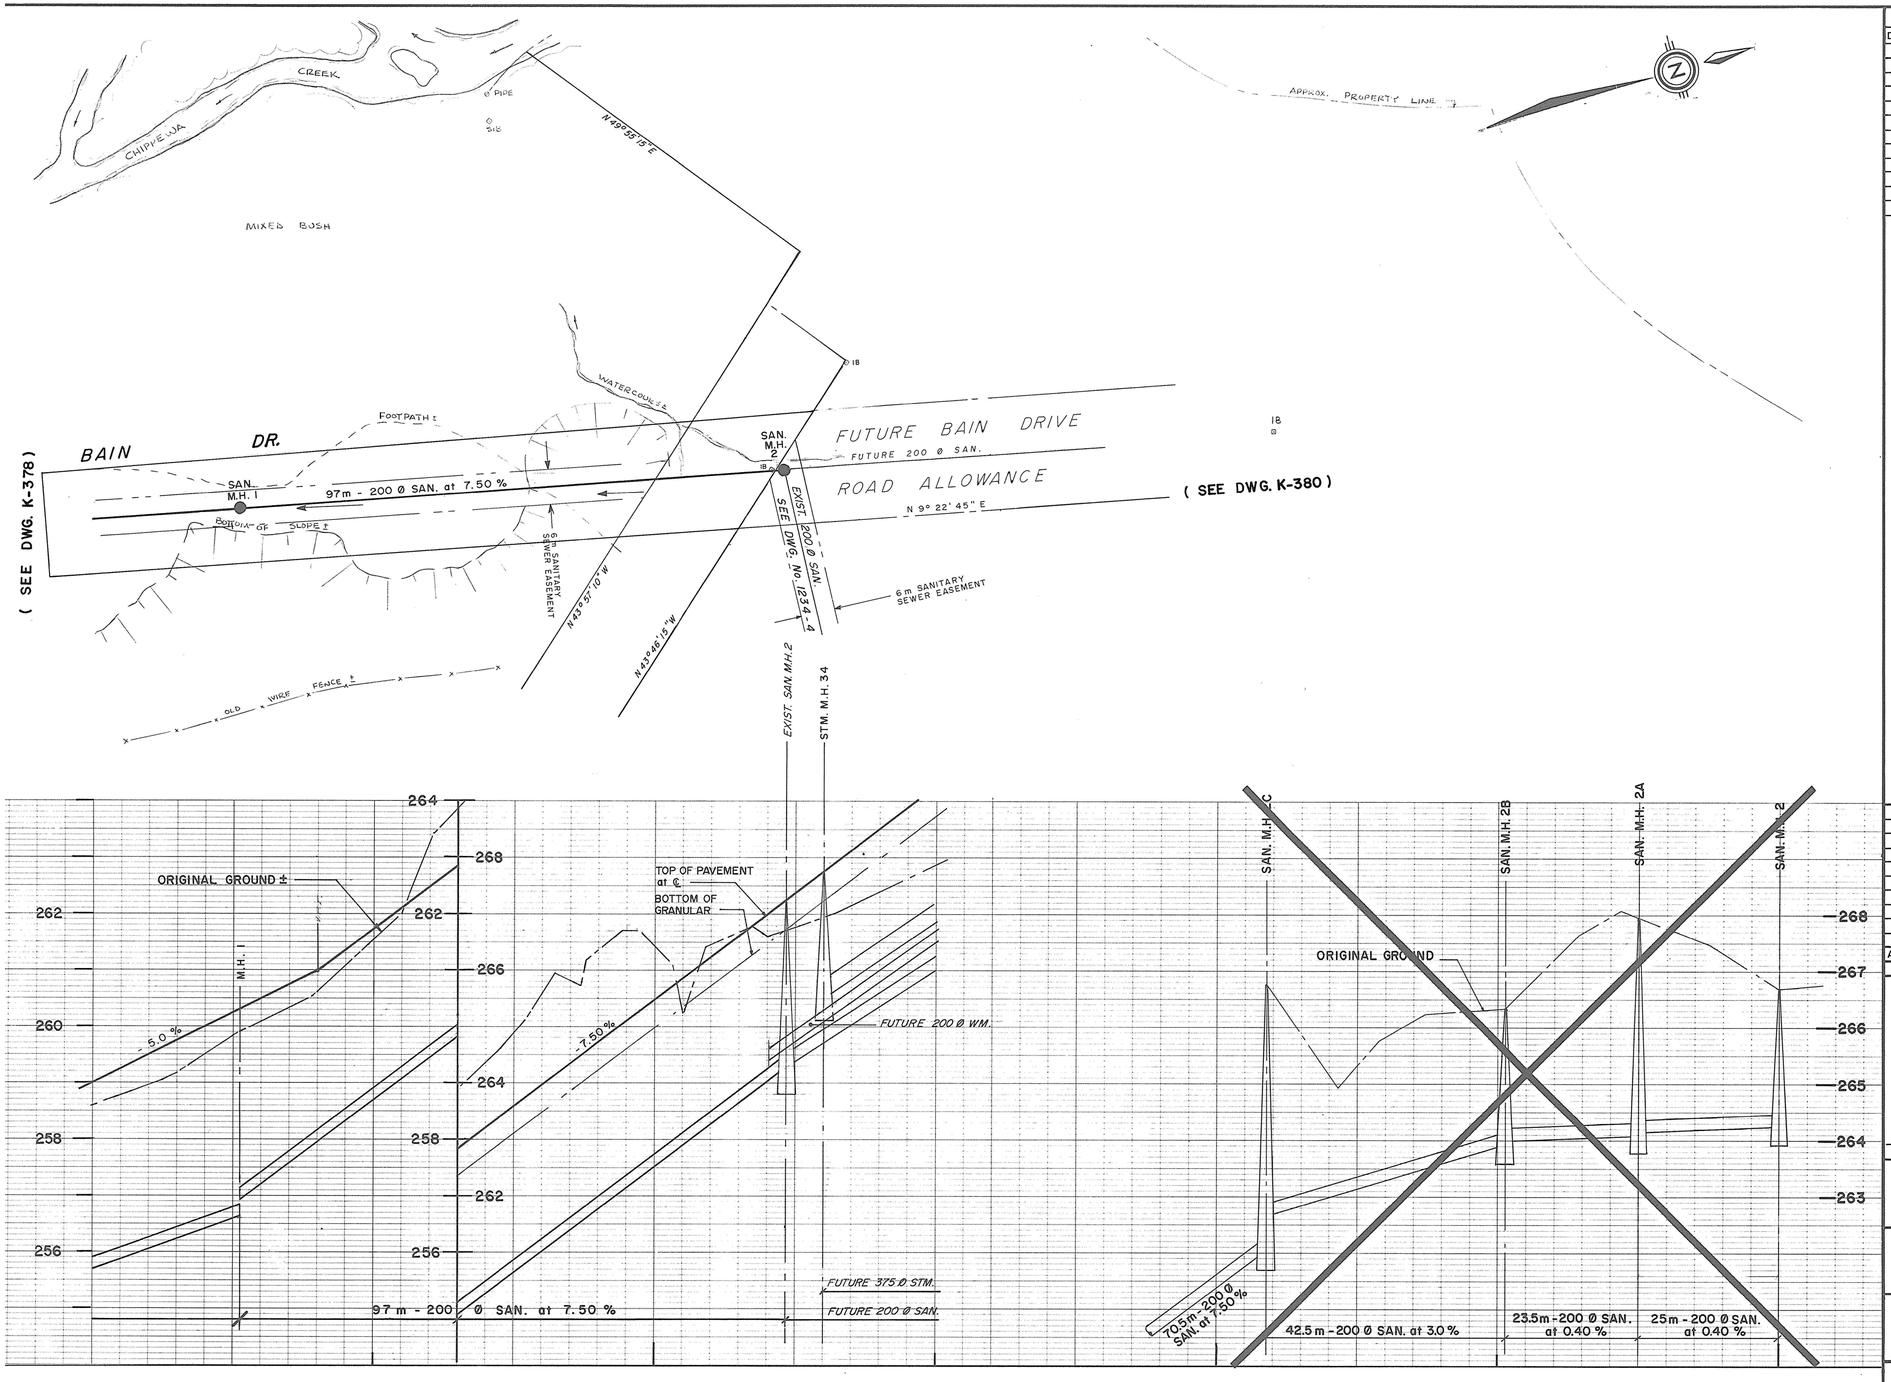

REFERENCE	
DWG Nº	DESCRIPTION

DISCLAIMER

The information contained on this drawing may be based upon data provided by others and may not have been verified by either as-constructed drawings or an Ontario Land Surveyor. The City of North Bay cannot accept responsibility for any errors or omissions on any information shown herein. Field verification, land surveys or excavation (with City approvals) may be required to determine actual location of any and all utilities or property lines.

APP'D BY	DETAILS	DATE	Nº
B.D.	ADD M.H.2 TO 2C - DELETE M.H. 2C TO 2	FEB15/90	A

REVISIONS

RECOMMENDED BY | APPROVED BY

KENWOOD HILLS COLLECTOR SEWER

PLAN AND PROFILE

northland engineering limited
Consulting Engineers and Planners
NORTH BAY SUDBURY TIMMINS

DRAWN BY: E.A.	DATE: JULY 1988
CHECKED BY: B.D.	SCALE: HORIZ. 1:500 VERT. 1:50
FIELD BOOK:	

OFFICE	PROJECT Nº	DRAWING Nº	REV.
NORTH BAY	1234 & 3161	K-379	