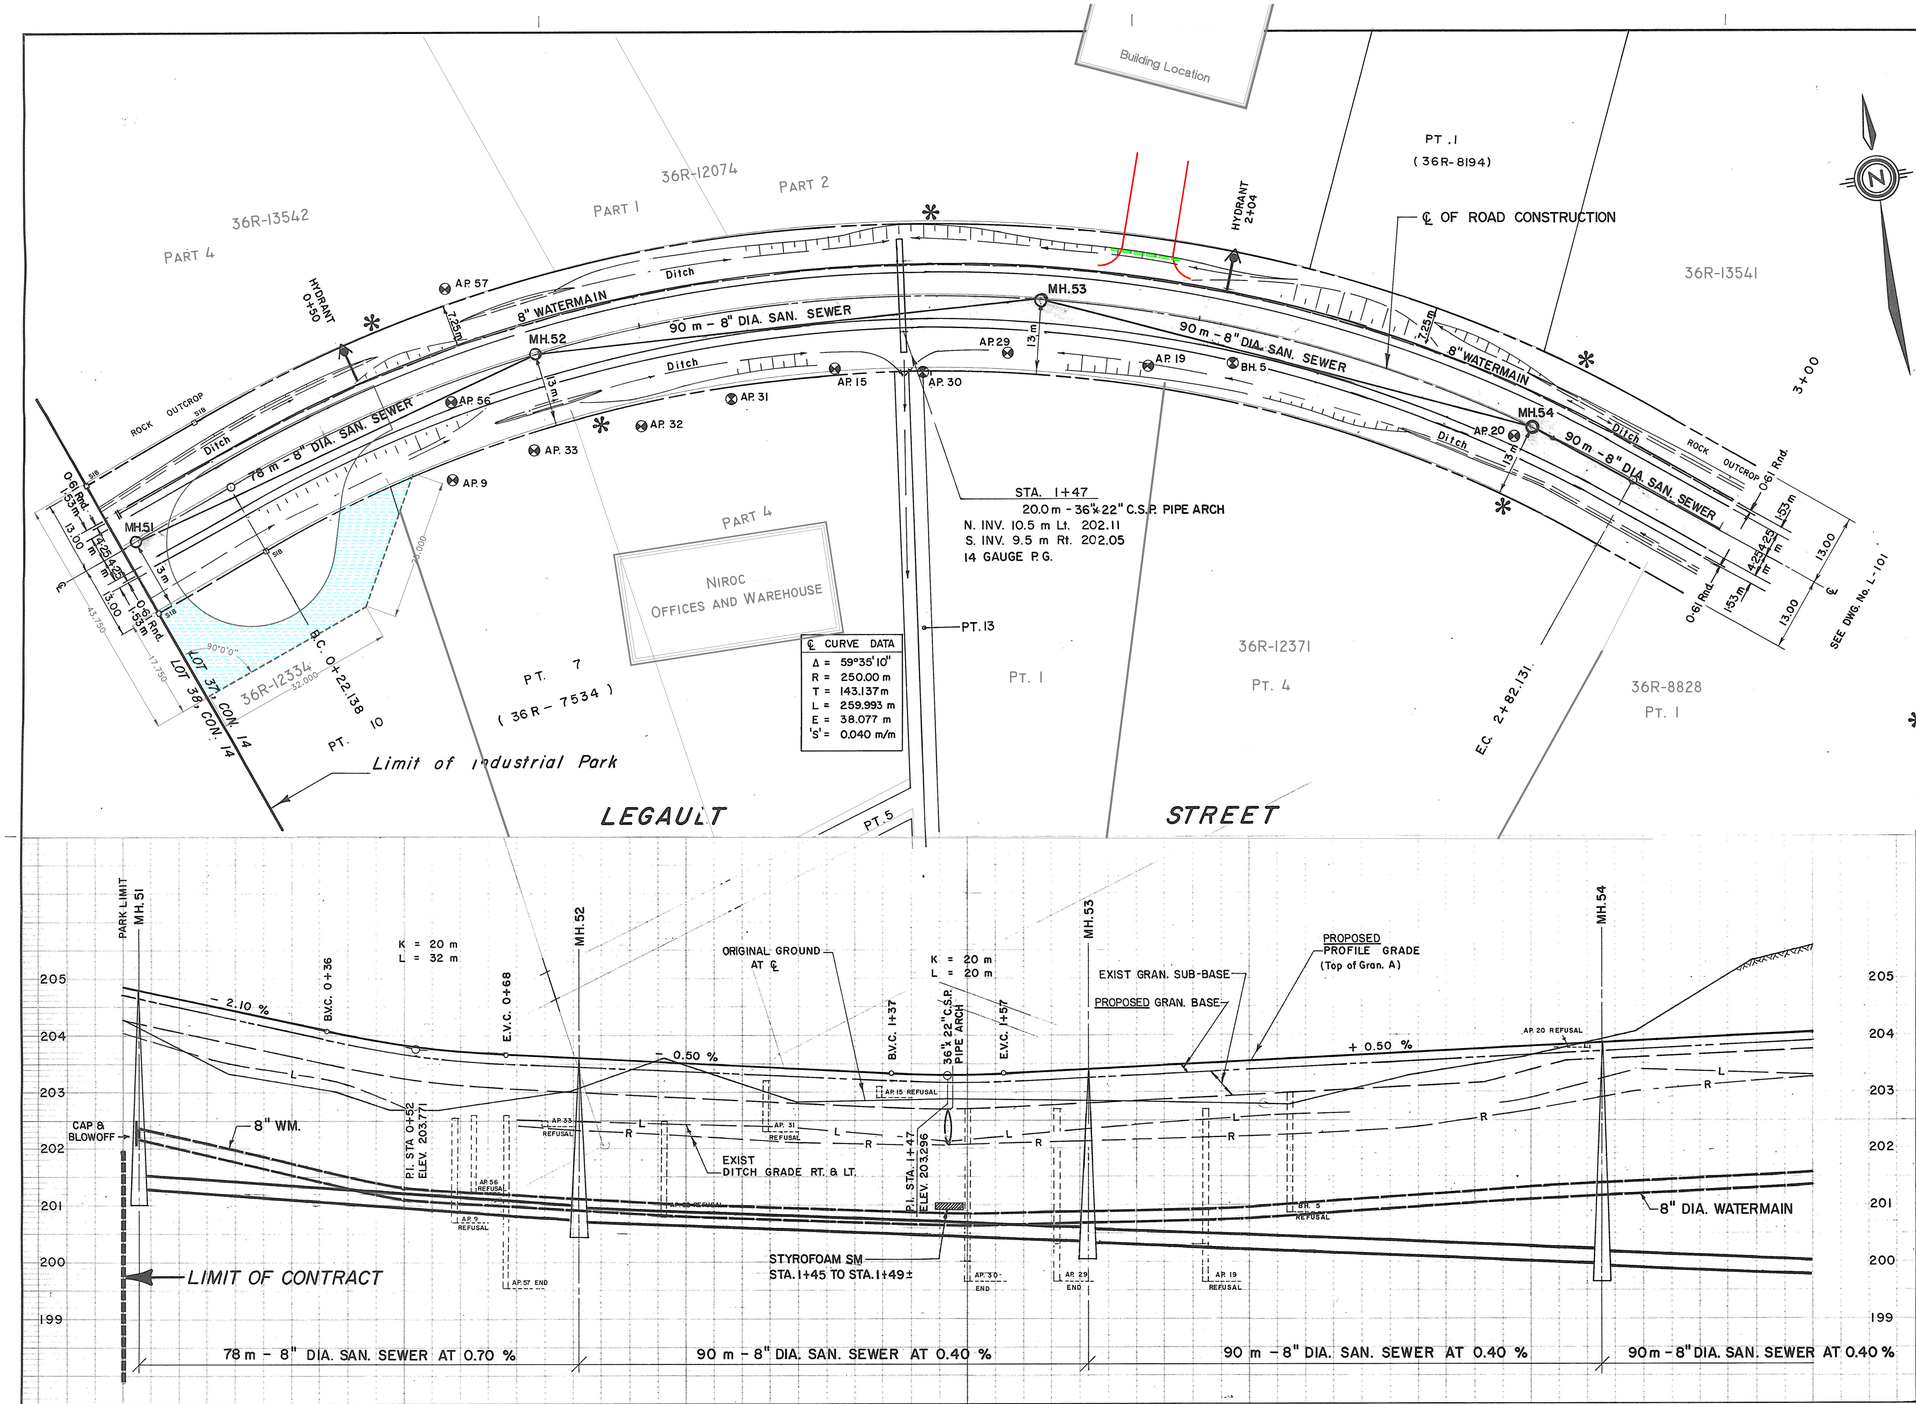

NORTH BAY

DISCLAIMER

The information contained on this drawing may be based upon data provided by others and may not have been verified by either as-constructed drawings or an Ontario Land Surveyor. The City of North Bay cannot accept responsibility for any errors or omissions on any information shown herein. Field verification, land surveys or excavation (with City approvals) may be required to determine actual location of any and all utilities or property lines.

NOTES

1. ROAD CONSTRUCTION
   - STA. 0+00± TO STA. 0+90 ± — ROCK CUT AND FILL
   - STA. 0+90 ± TO STA. 2+60 ± — ROCK FILL
   - STA. 2+60± TO STA. 3+50 ± — ROCK CUT
2. ALL UNDERGROUND UTILITIES ARE COMPLETE WITH THE EXCEPTION OF THE TOPS OF THE MANHOLES WHICH ARE TO BE ADJUSTED, UNDER THIS CONTRACT, TO SUIT THE FINAL PAVEMENT ELEVATIONS.
3. RIGHT OF WAY GRADING IS COMPLETE WITH THE EXCEPTION OF THE INSTALLATION OF THE GRANULAR BASE.

✻ INDICATES 6" SANITARY AND 6" WATER SERVICES

ALL DIMENSIONS SHOWN ARE IN METRIC VALUES UNLESS NOTED OTHERWISE.

CHAINAGE	0+00	+02.75	+25	+36	+50	+68	+75	+81	1+00	+25	+37	+50	+57	+71.50	+75	2+00	+25	+50	+62.40	+75	3+00	CHAINAGE
PROFILE GRADE ELEVATIONS	204.863		204.338	204.107	203.862	203.691	203.656		203.531	203.406	203.346	203.323	203.346	203.436		203.561	203.686	203.811		203.936	204.061	PROFILE GRADE ELEVATIONS
DITCH RT.								202.35		202.10		202.05		202.15			202.35			203.00	203.25	DITCH RT.
DITCH LT.	204.05			203.20	202.75			202.50		202.40		202.11		202.40		202.60		202.85		203.40	203.30	DITCH LT.
SAN. INVERT	201.300							200.754 200.724						200.364 200.334					199.974 199.944			SAN. INVERT
TOP W.M.	202.36				201.27				201.03			200.82				201.06		201.31			201.56	TOP W.M.

REVISIONS

DATE	DETAILS	BY
17 FEB. '81	CULVERT STA. 1+47 TO PIPE ARCH, INVERTS	B.D.
FEB. '82	REVISED TO CONTRACT No. 2	R.E.A.
Nov. 08	REGISTERED PLANS ADDED.	R.J.O.
Dec '13	REGISTERED PLANS ADDED.	G.W.C.

RECOMMENDED BY | APPROVED BY

CITY OF NORTH BAY
DEPARTMENT OF REGIONAL ECONOMIC EXPANSION AND MINISTRY OF NORTHERN AFFAIRS

INDUSTRIAL PARK

LEGAULT STREET
STA. 0+00 TO STA. 3+00

NORTHLAND ENGINEERING LTD.
Consulting Engineers and Planners
NORTH BAY SUDBURY THUNDER BAY

DRAWN BY: D. COOPER & B.A.	DATE: NOV. 1980
CHECKED BY: D.R.	FIELD BOOK:
SCALE: HOR. 1 : 500 VERT. 1 : 50	CONTRACT Nº 2
OFFICE NORTH BAY	PROJECT Nº 1877
DRAWING Nº L-102	

TRANSLAR 500-6-78