
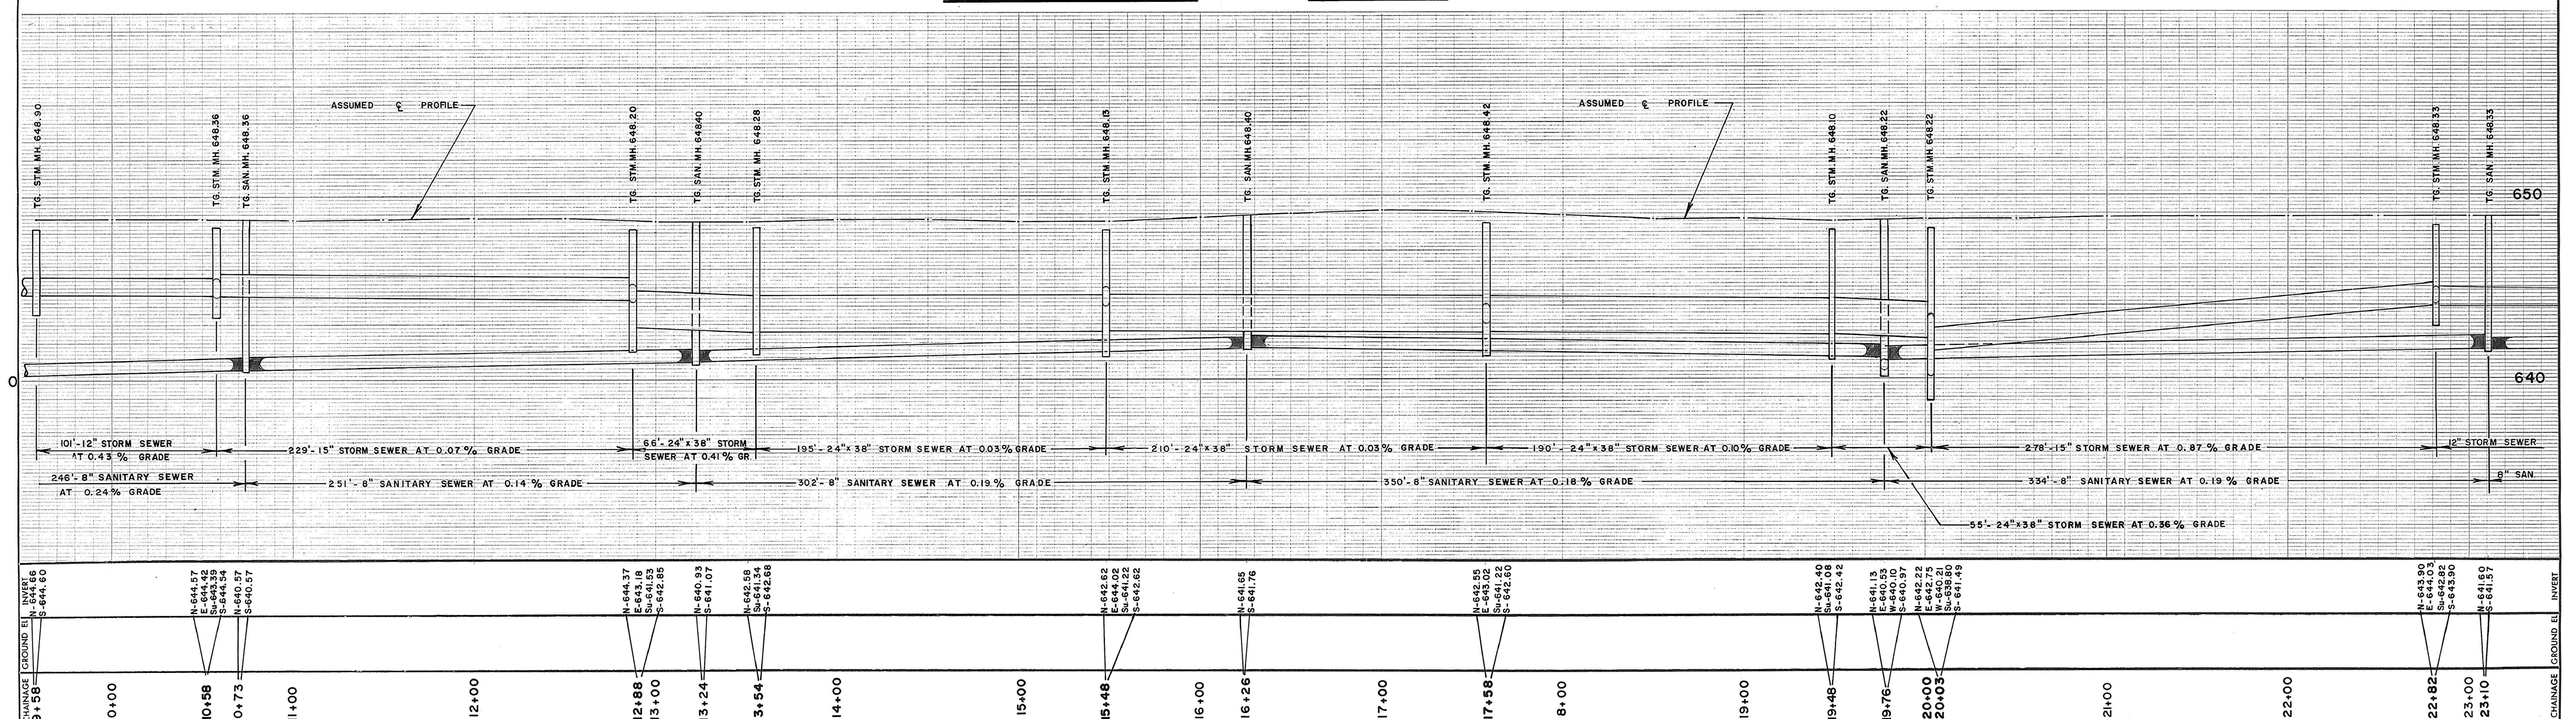


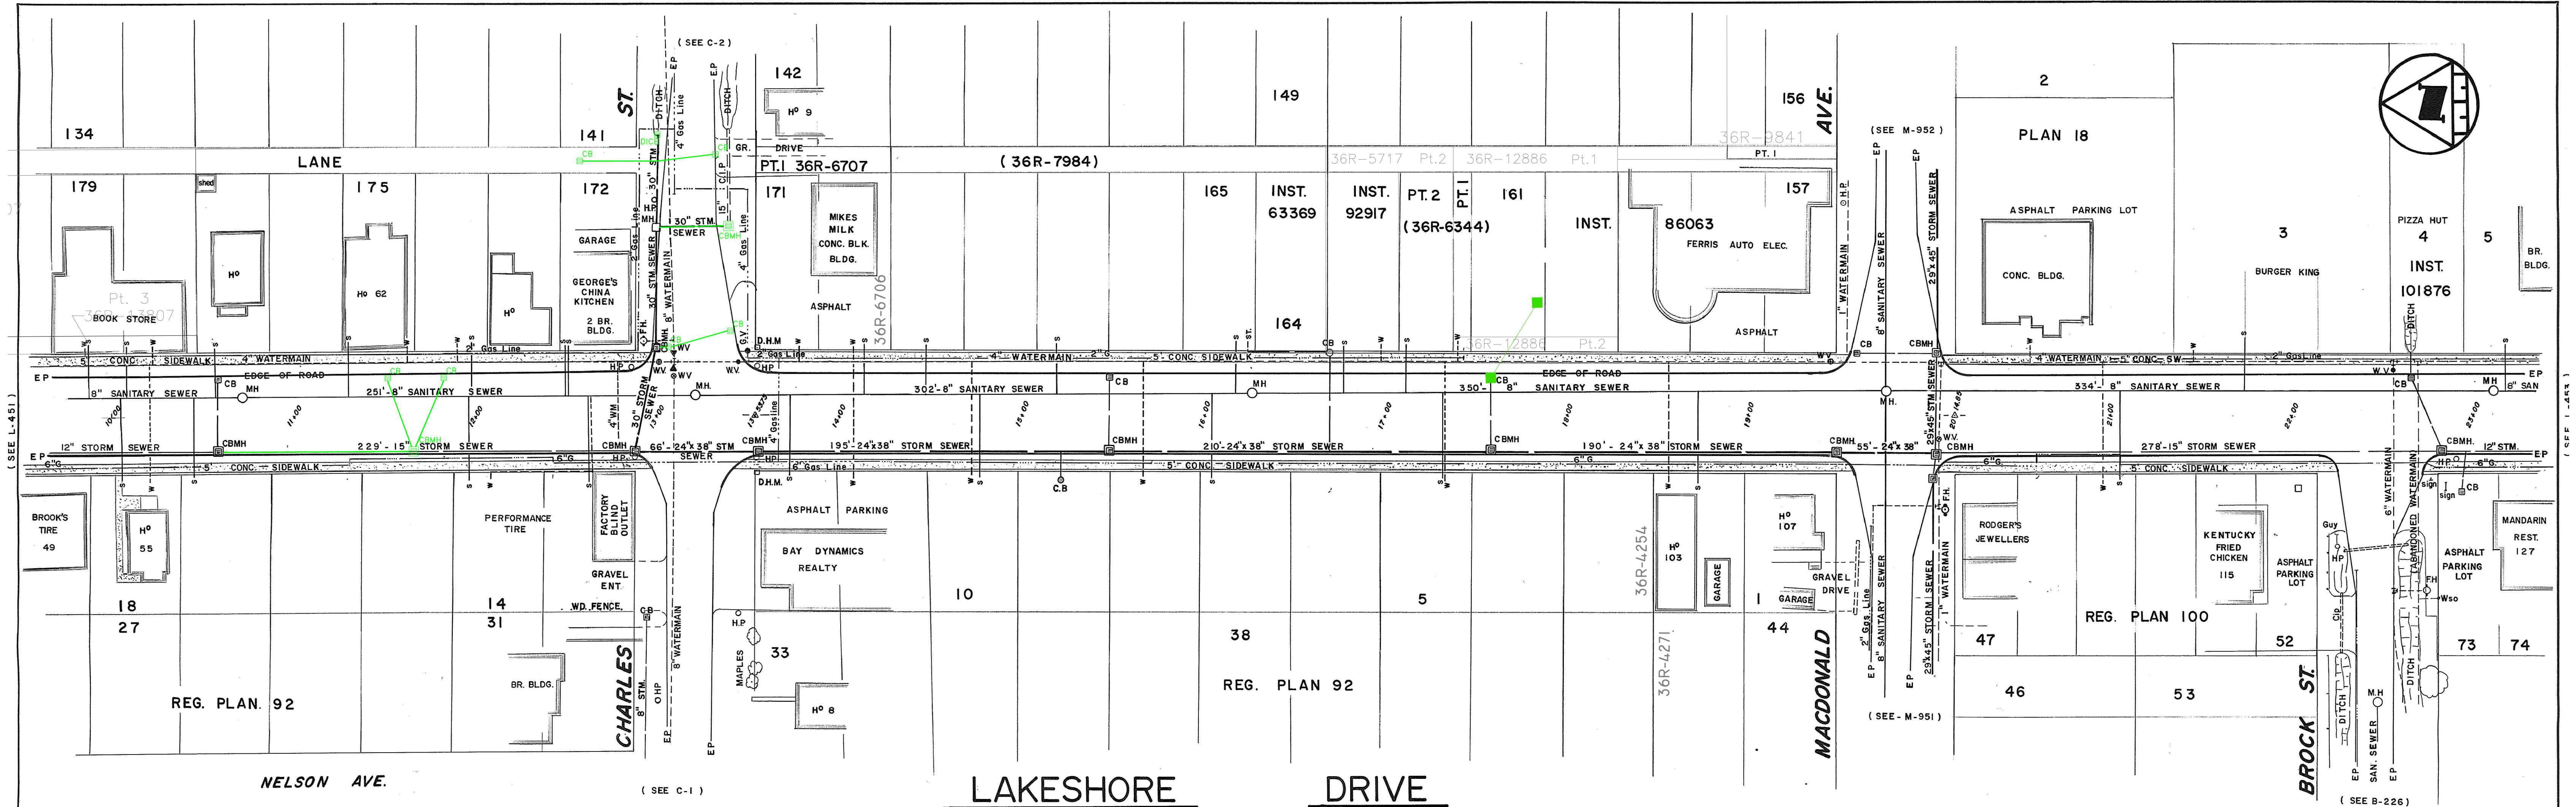

NOTES:

DISCLAIMER

The information contained on this drawing may be based upon data provided by others and may not have been verified by either as-constructed drawings or an Ontario Land Surveyor. The City of North Bay cannot accept responsibility for any errors or omissions on any information shown herein. Field verification, land surveys or excavation (with City approvals) may be required to determine actual location of any and all utilities or property lines.

No.	REVISION	DATE	INITIAL
3.	R-plans, storm network added	Sept 15	J.J.M.
2.	36R-12886 added	Jul 10	G.W.C.
1.	REGISTERED PLANS ADDED	Nov 08	R.J.O.

APPROVED

LAKESHORE DRIVE
FODOR STREET TO BROCK STREET

CITY OF NORTH BAY
ENGINEERING DEPARTMENT

SCALE: HOR - 1" = 40'
VER - 1" = 4'

DATE: MARCH/92

DRAWN BY: P.L.C.
CK'D BY:

FIELD BOOK NO.

DRAWING NO. **L-452**

REV.