


DISCLAIMER
The information contained on this drawing may be based upon data provided by others and may not have been verified by either as-constructed drawings or an Ontario Land Surveyor. The City of North Bay cannot accept responsibility for any errors or omissions on any information shown herein. Field verification, land surveys or excavation (with City approvals) may be required to determine actual location of any and all utilities or property lines.

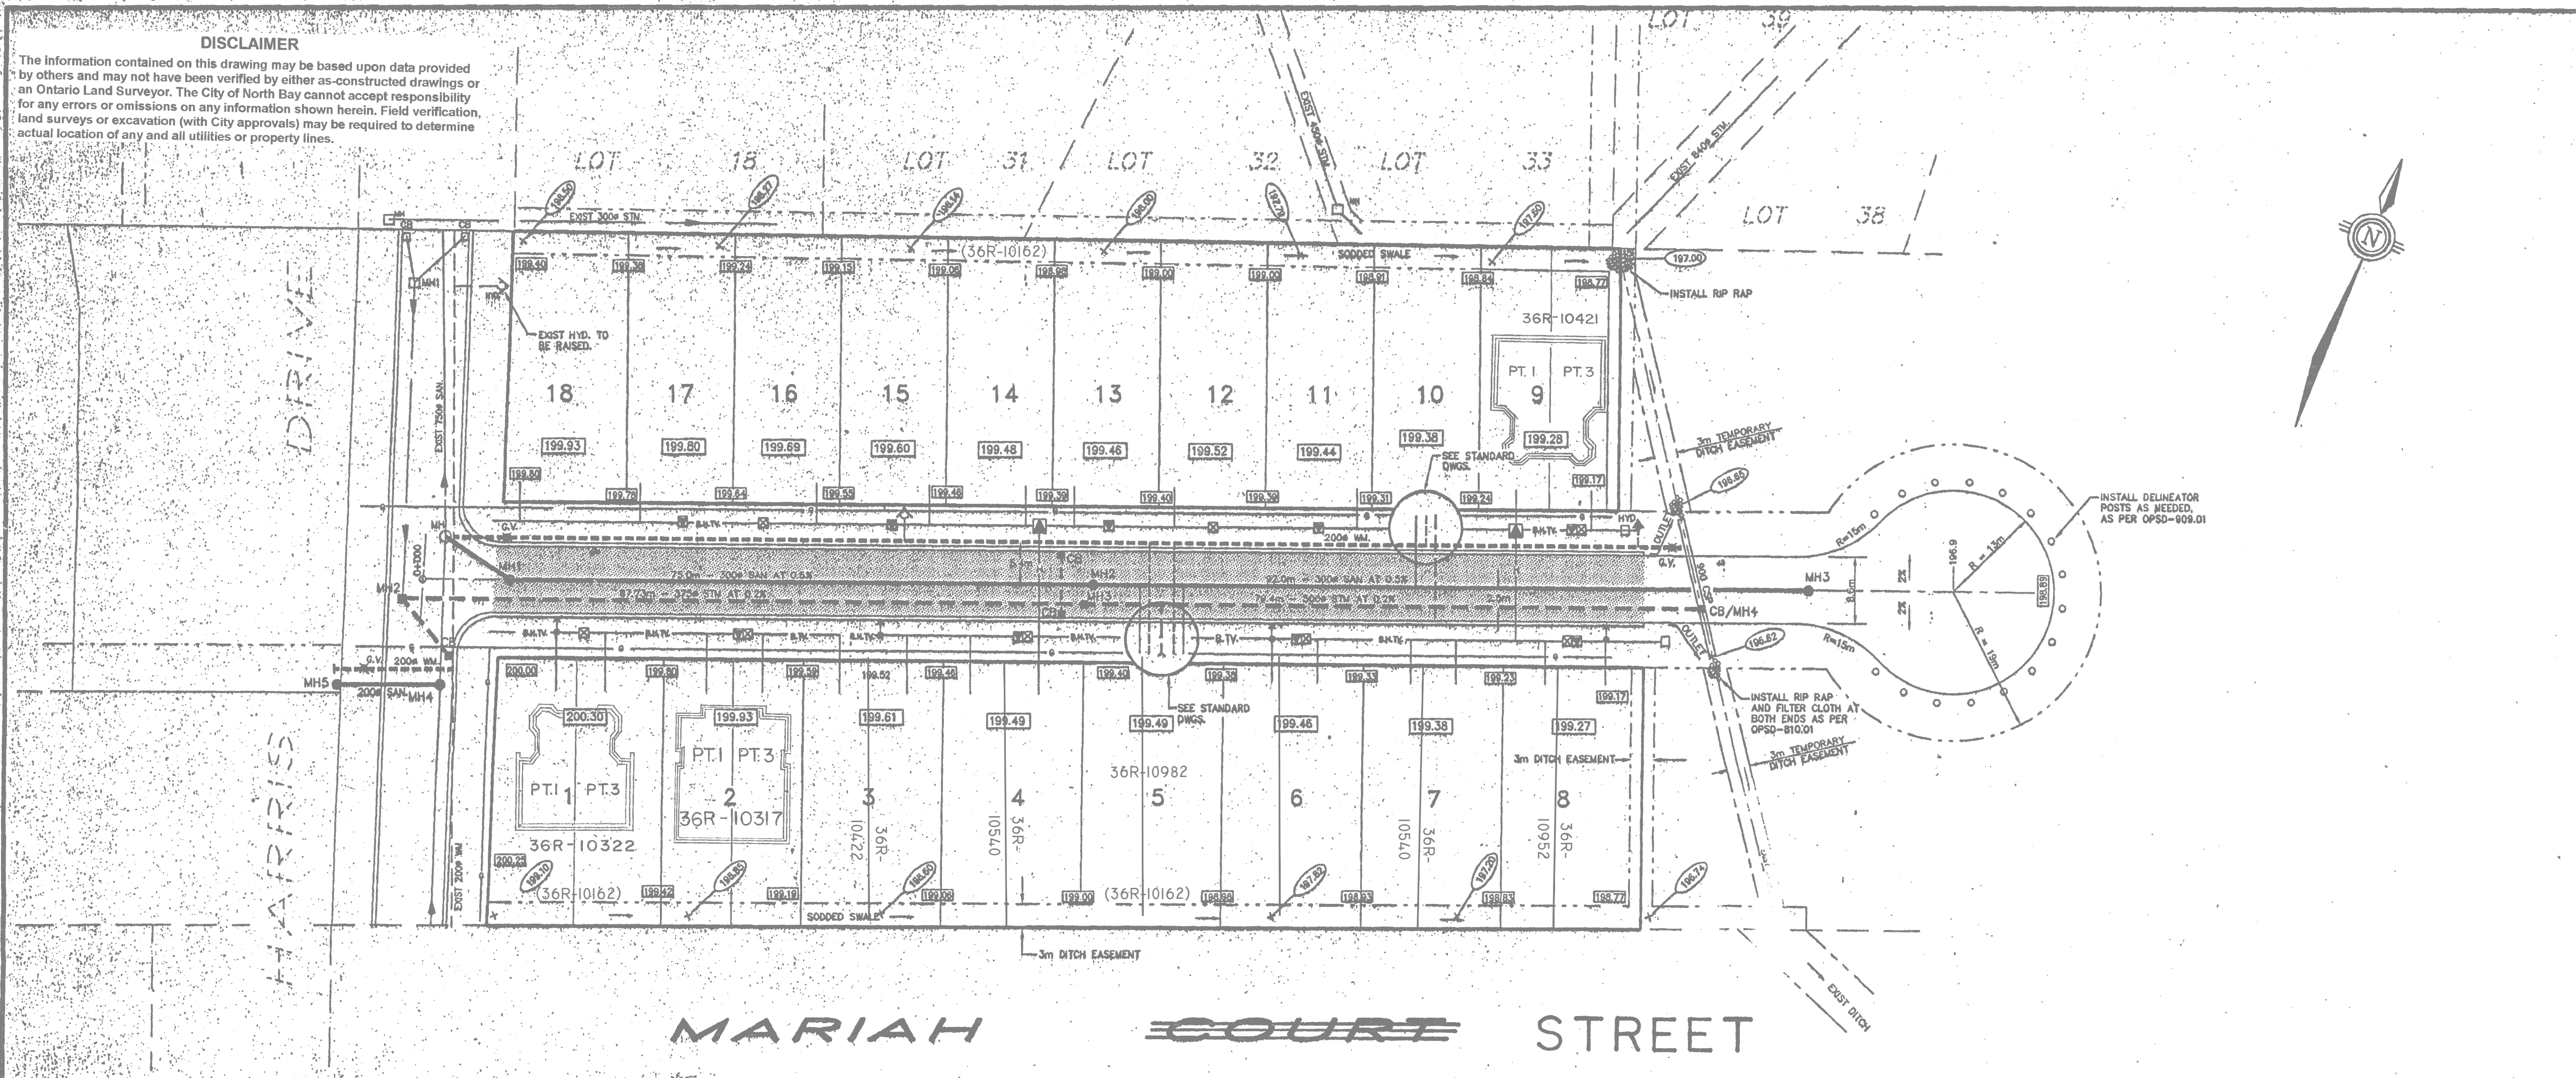

REFERENCE	
DWG No	DESCRIPTION
C1	GENERAL PLAN
C2	PLAN AND PROFILE - MARIAH COURT
C4	STANDARDS
C5	STANDARDS

GENERAL NOTES


CONTRACTOR TO ASSUME RESPONSIBILITY TO LIMITS OF CONTRACT.
LOCATION OF EXISTING BURIED UTILITIES ARE APPROXIMATE AND MUST BE VERIFIED BY THE CONTRACTOR.

- NOTES:
- 1 POSITION AND ELEVATIONS ARE ASSUMED.
 - 2 SODDING AND SIDE SLOPES - AS PER OPSD 218.01
 - 3 CSP BEDDING AND B/FILL - AS PER OPSD 802.01 & 803.04


LEGEND

ORIGINAL GROUND	+ 200.2
BOTTOM OF SODDED SWALE	+ 200.2
FINISHED GRADE	+ 200.2
WATERMAIN - GATE VALVE	⊗
FIRE HYDRANT	⊕
CONDUIT TERMINATION BOX (TEMPORARY)	□
TRANSFORMER	⏚
BELL BOX	⊞
LIGHT STANDARD	⊙
CATV PEDESTAL	⊞
NATURAL GAS	—

GAS PLANT APPROVED		CATV PLANT APPROVED	
CENTRA GAS ONTARIO INC	DATE	MACLEAN HUNTER CABLE TV	DATE
HYDRO PLANT APPROVED		BELL PLANT APPROVED	
NORTH BAY HYDRO	DATE	BELL CANADA LTD.	DATE

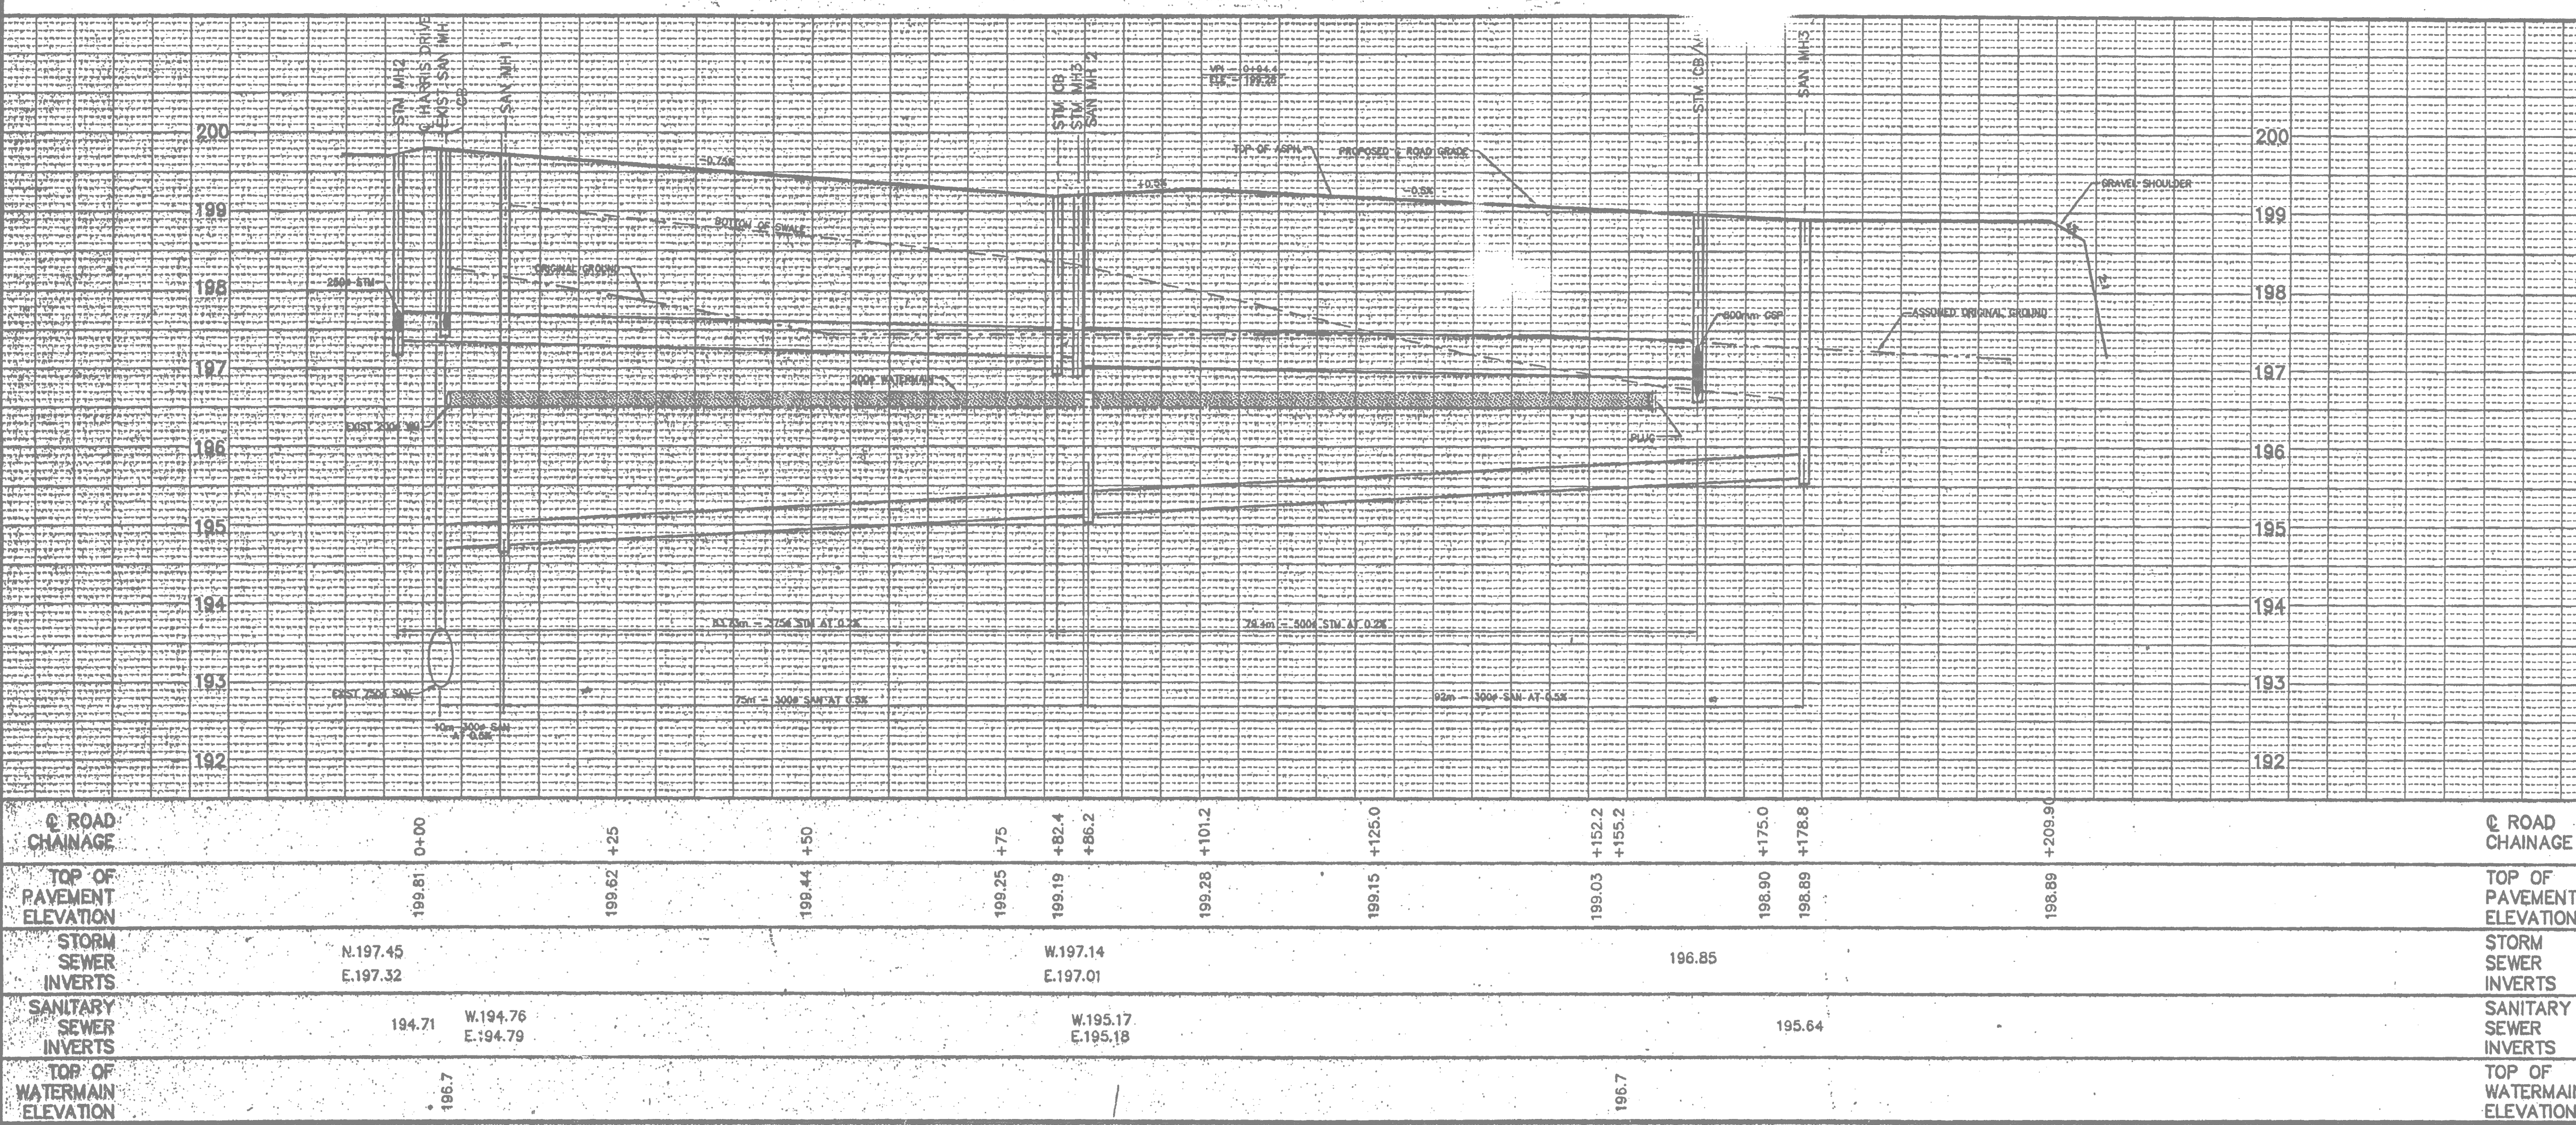

R.J.O.	REGISTERED PLANS ADDED	Dec 2008	1
APP'D BY	DETAILS	DATE	No

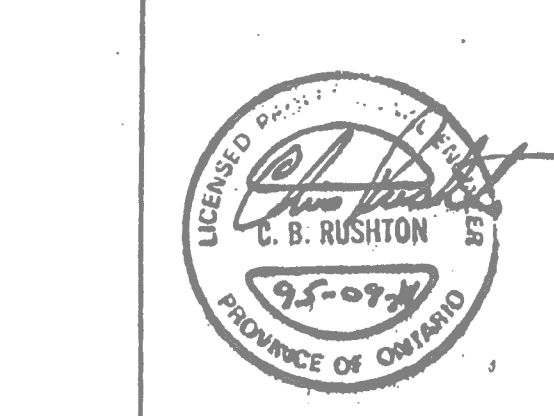

RECOMMENDED BY	APPROVED BY
----------------	-------------

A. & J. FERREIRA HOMES LTD.

FERREIRA SUBDIVISION

PLAN AND PROFILE

SEI SHELTA ENGINEERING INC. PROJECT MANAGERS, ENGINEERS, DESIGNERS NORTH BAY ONT. Telephone: (705) 495-1958 Fax: (705) 495-3218	
DRAWN BY: G.L.H.	DATE: AUG./95
CHECKED BY: C.B.R.	SCALE: HORIZ. 1 : 500 VERT. 1 : 50
CAD FILE: 1011-C2	
OFFICE: NORTH BAY	PROJECT No: 1011
	DRAWING No: M-1201
	REV. 5