

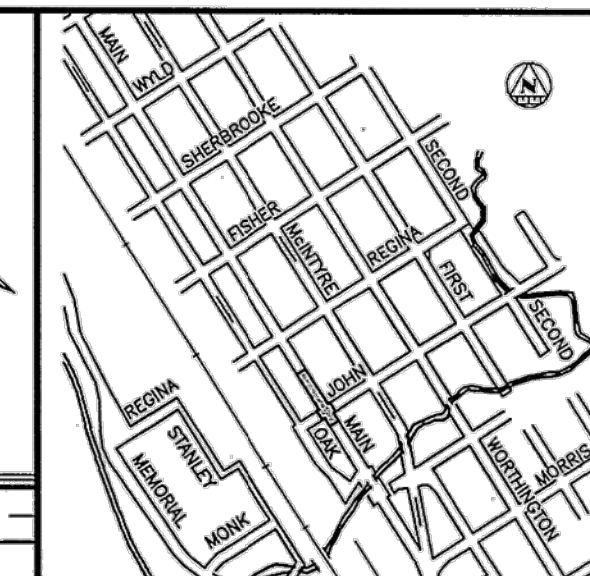


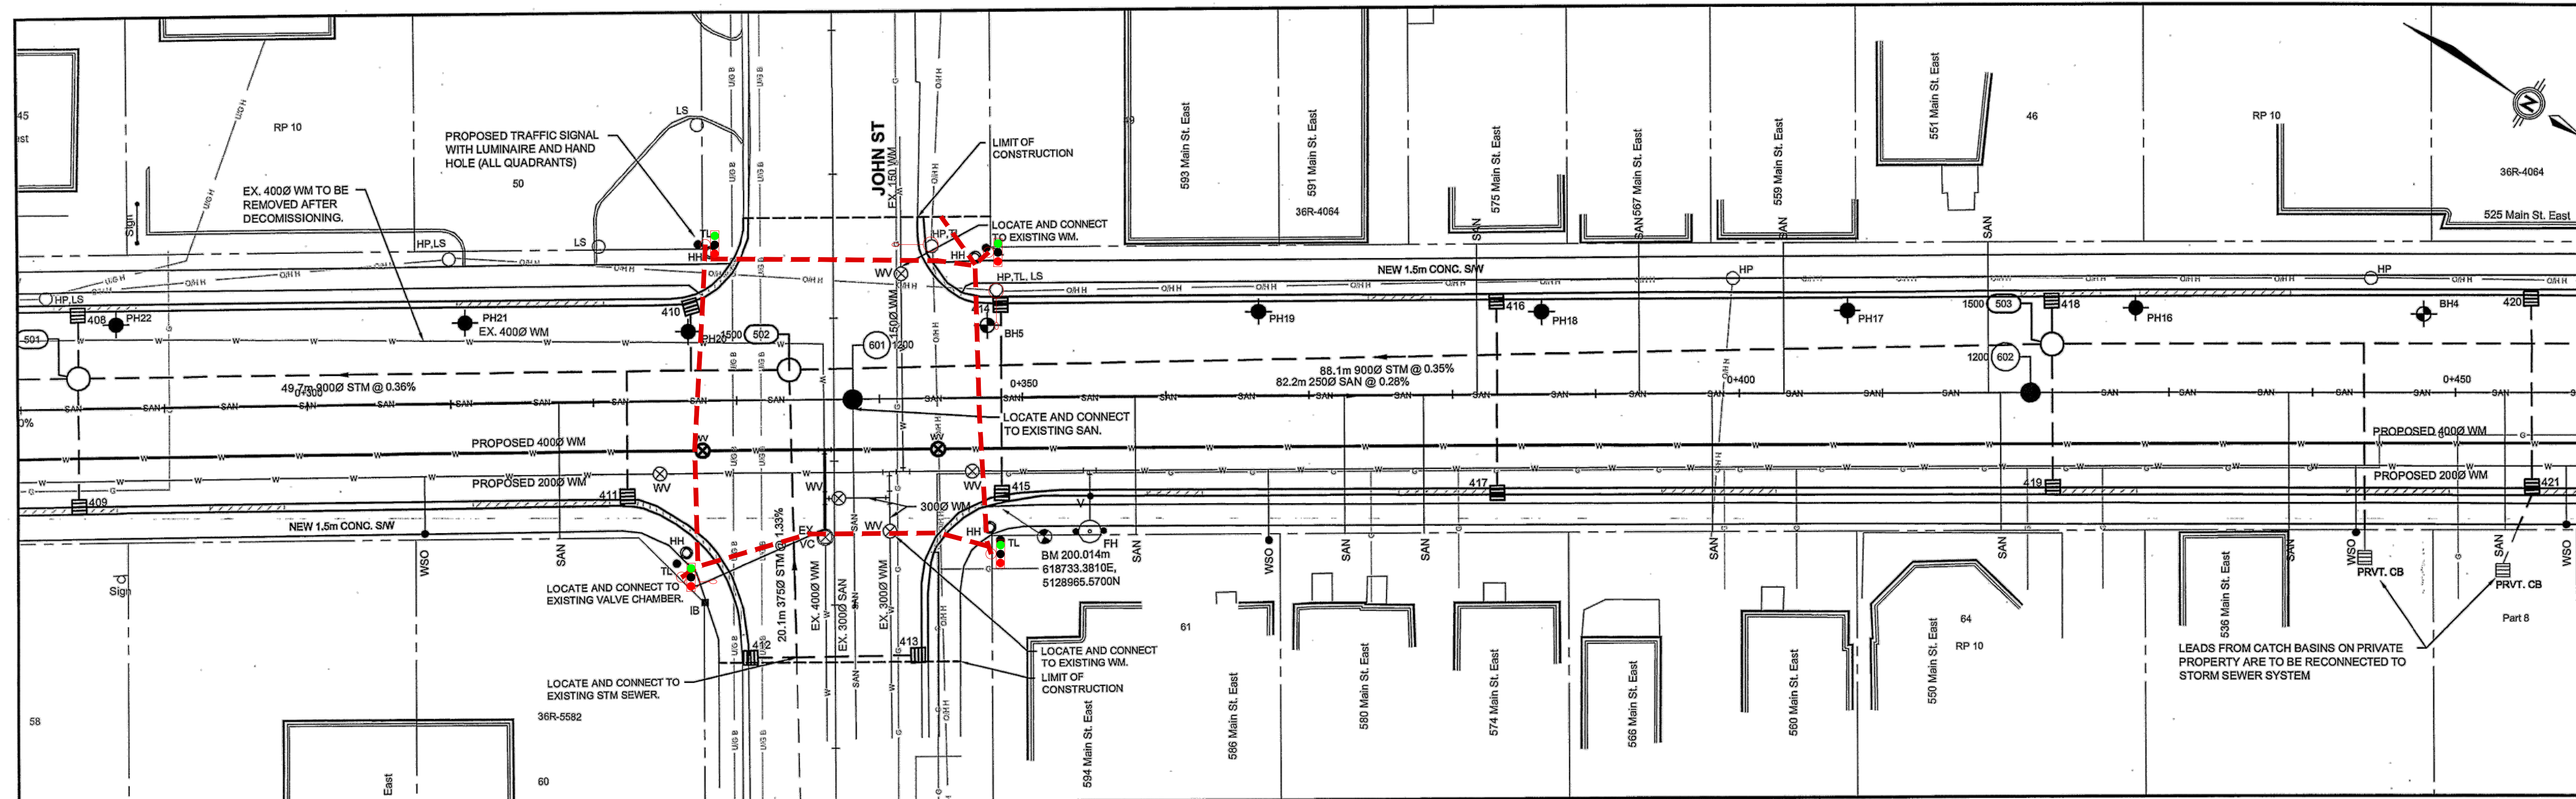

- KEY PLAN**
- LEGEND**
- NOTE: REFER TO DWG. G-1 FOR COMPLETE LEGEND
- W - EXISTING WATERMAIN
 - W - PROPOSED WATERMAIN
 - SAH - EXISTING SANITARY
 - SAH - PROPOSED SANITARY
 - STH - EXISTING STORM
 - STH - PROPOSED STORM
 - MSH - EXISTING SANITARY MANHOLE
 - MSH - PROPOSED SANITARY MANHOLE
 - MSH - EXISTING STORM MANHOLE
 - MSH - PROPOSED STORM MANHOLE
 - CB - EXISTING CATCHBASIN
 - CB - PROPOSED CATCHBASIN
 - PH - EXISTING FIRE HYDRANT
 - PH - PROPOSED FIRE HYDRANT
 - VC - EXISTING VALVE CHAMBER
 - VC - PROPOSED VALVE CHAMBER
 - WV - EXISTING WATERMAIN VALVE
 - WV - PROPOSED WATERMAIN VALVE
 - WV - EXISTING SANITARY SHUTOFF
 - WV - PROPOSED SANITARY SHUTOFF
 - WV - EXISTING SANITARY CLEANOUT
 - WV - PROPOSED SANITARY CLEANOUT
 - LS - EXISTING LIGHT STANDARD
 - LS - PROPOSED LIGHT STANDARD
 - HP - EXISTING HYDRO POLE
 - HP - PROPOSED HYDRO POLE
 - HP - EXISTING GUY WIRE
 - HP - PROPOSED GUY WIRE
 - HP - EXISTING TRAFFIC LIGHT POLE
 - HP - PROPOSED TRAFFIC LIGHT POLE
 - HP - EXISTING HYDRO POLE w/ TRAFFIC LIGHT POLE
 - HP - PROPOSED HYDRO POLE w/ TRAFFIC LIGHT POLE
 - IB - STANDARD IRON BAR
 - PM - PARKING METER
 - CO - DOUBLE PARKING METER
 - CO - EXISTING TREE w/ RETAINING WALL
 - BO - BOREHOLE
 - BO - PROBEHOLE
 - BO - (BASED ON PATTERSON GROUP GEOTECHNICAL INVESTIGATION MARCH 25, 2010.)

Main Street East

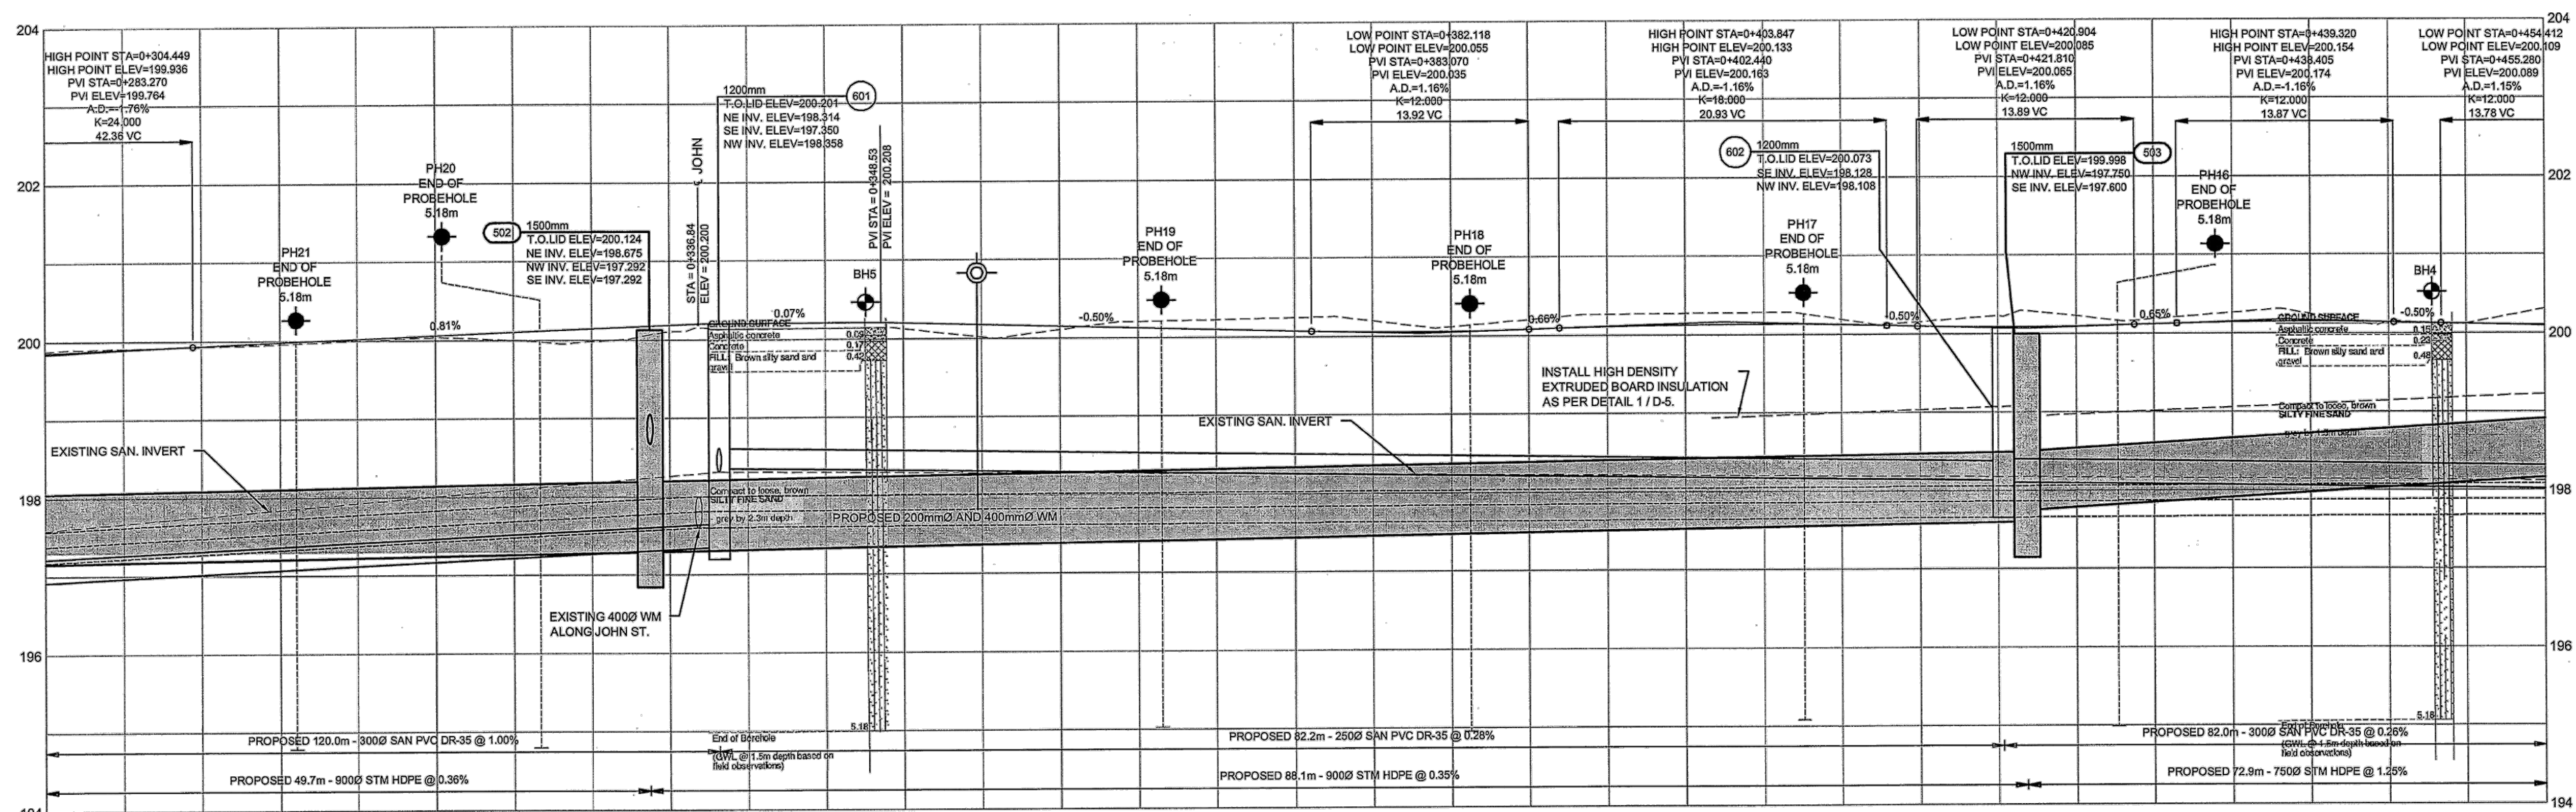

C.L. ROADWAY STATION	0+295	0+300	0+310	0+320	0+330	0+340	0+350	0+360	0+370	0+380	0+390	0+400	0+410	0+420	0+430	0+440	0+450

REVISIONS

no.	date	by	description
1.	27 MAY 2011	DJLH	ISSUED FOR TENDER
2.	27 JULY 2011	DJLH	ISSUED FOR CONSTRUCTION
3.	Oct 20 2011	Jp	E-Hydro UG Traffic (Approx)

J.L. Richards & Associates Limited
175 Progress Road
North Bay, ON Canada
P1B 8G4
Tel: 705 498 7897
Fax: 705 498 6862

L. J. RANTA
PROFESSIONAL ENGINEER
PROVINCE OF ONTARIO
JLR Project Number - 24107



RECONSTRUCTION OF MAIN STREET EAST
Tender

NEW CONSTRUCTION

PLAN & PROFILE
0+300 TO 0+450

designer JN/JH	drawn by: DJLH
checked by: LR	approved by: KKM
scale 1:250 1:50	drawing number M-137B
date MAY 2011	