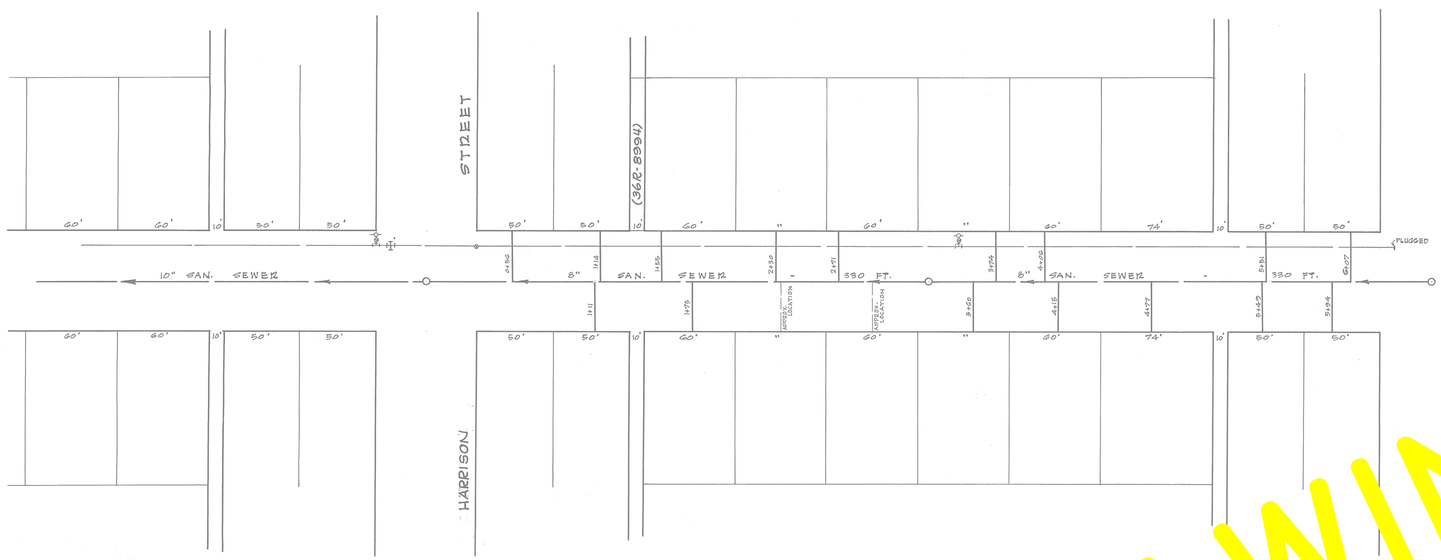

PLEASE SEE DRAWING M-653

DISCLAIMER

The information contained on this drawing may be based upon data provided by others and may not have been verified by either as-constructed drawings or an Ontario Land Surveyor. The City of North Bay cannot accept responsibility for any errors or omissions on any information shown herein. Field verification, land surveys or excavation (with City approvals) may be required to determine actual location of any and all utilities or property lines.

# TOWNSHIP OF WIDDIFIELD
## SANITARY SEWER EXTENSIONS
## MONTROSE AVENUE
FROM CHIPPEWA ST. TO OLIVE ST.

NORTHLAND ENGINEERING
CONSULTING CIVIL ENGINEERS
NORTH BAY ONTARIO

APPROVALS -

| MK. | DATE | REVISION | BY |
|---|---|---|---|
| A | NOV. 29/62 | AS CONSTRUCTED - BY-LAW NO. 967 | J.C.F. |

DRAWN BY: J.C.F. | SCALE - HOR: 1 IN. = 40 FT. VERT: 1 IN. = 4 FT. | DWG. NO. M-652 | REV. A

CHECKED BY: EMB | DATE - NOV. 29th, 1962

KEUFFEL & ESSER CO. NEW YORK
TRADE STANDARD MARK
PROFILE PLATE A 4 X 20
100% RAG PAPER
MADE IN U.S.A.