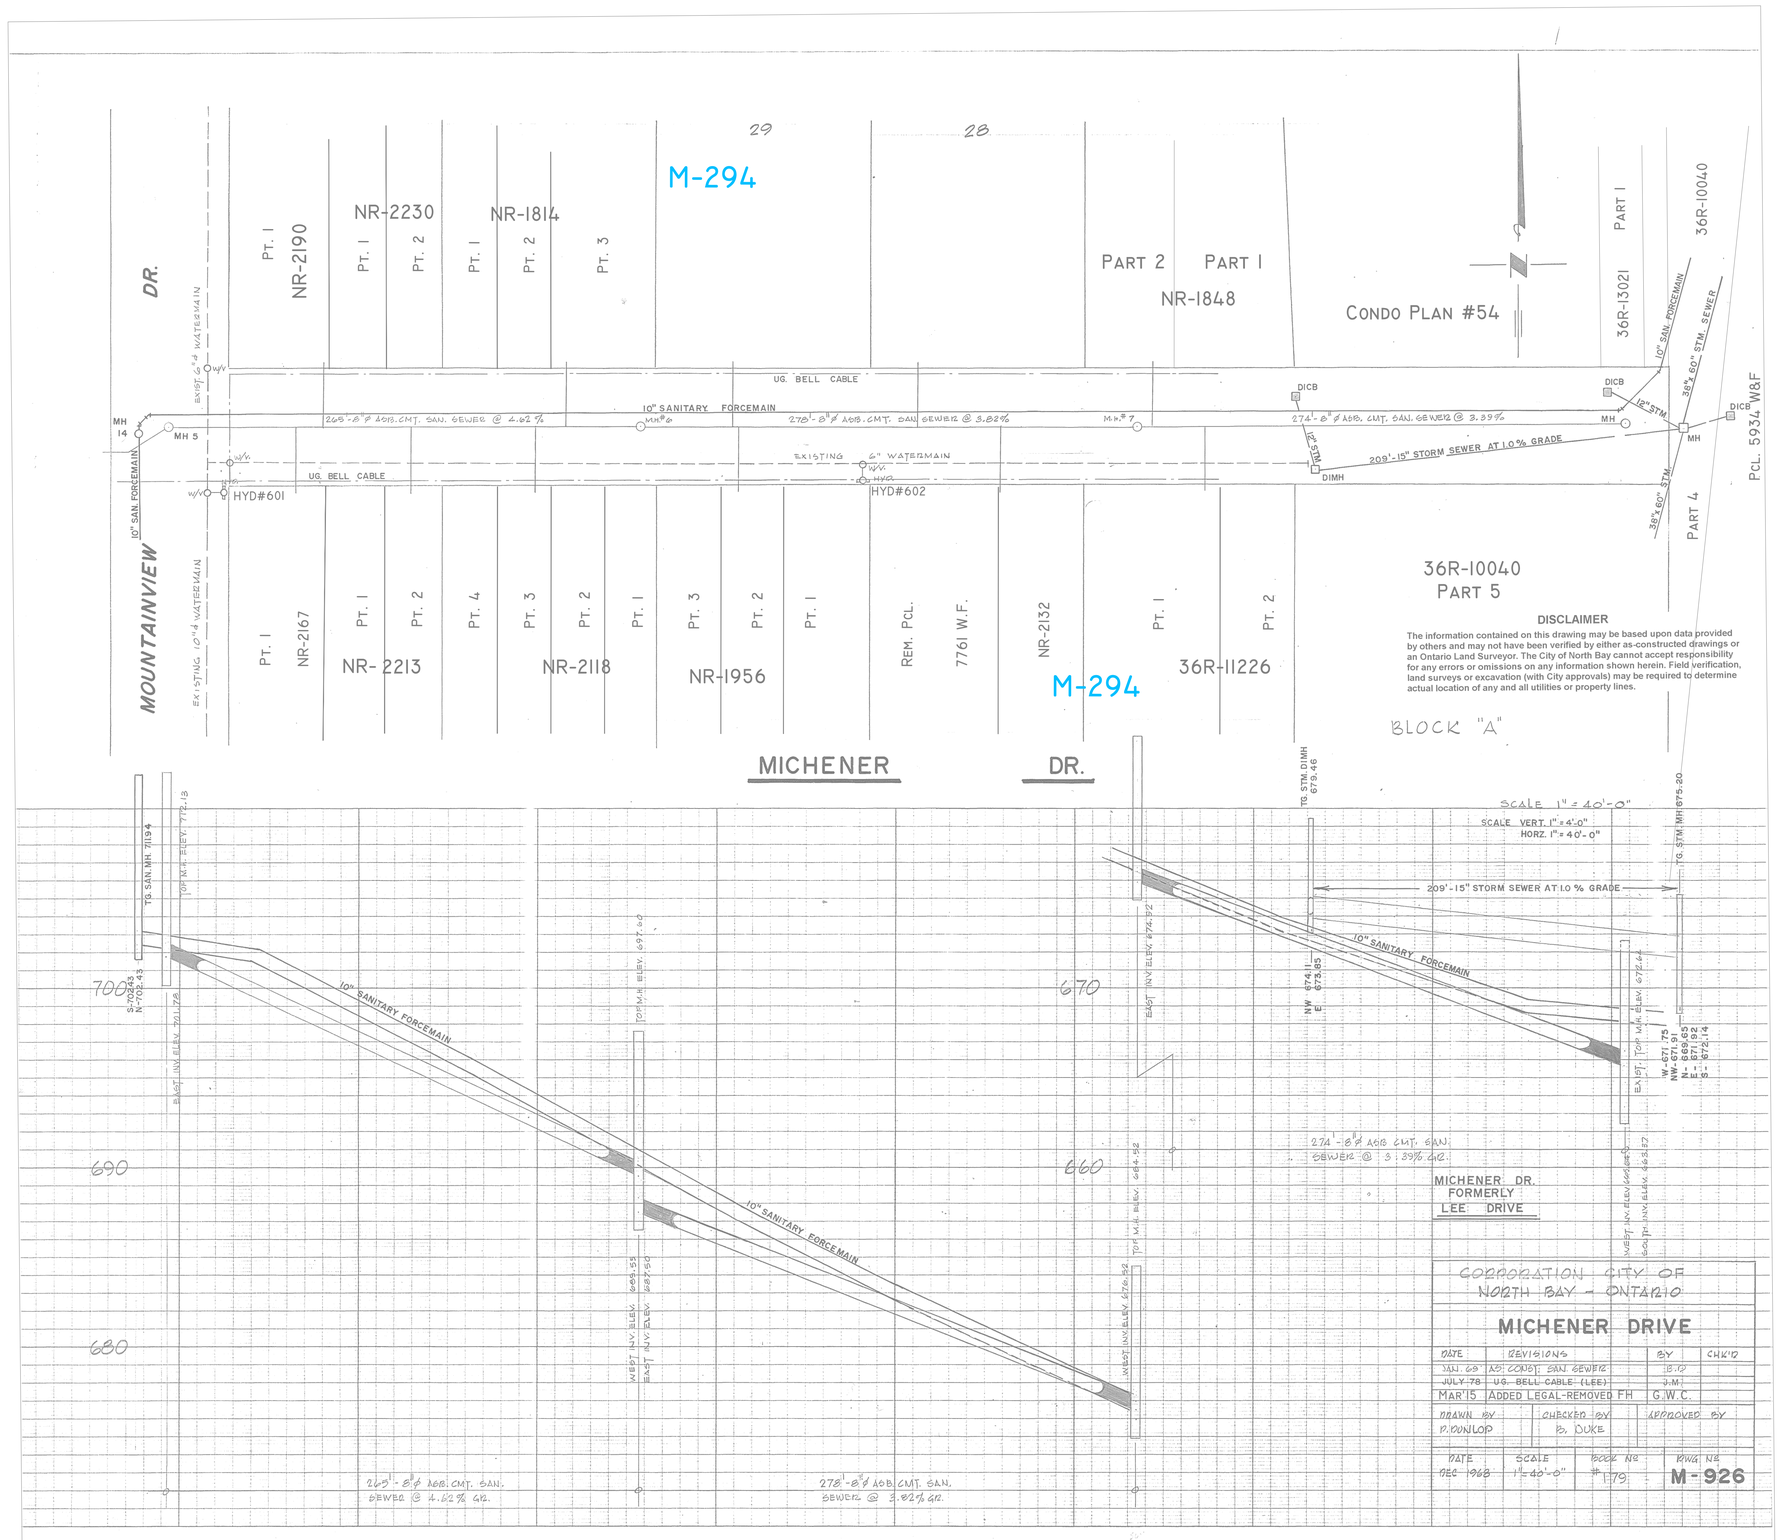


CORPORATION CITY OF NORTH BAY - ONTARIO

# MICHENER DRIVE

| DATE | REVISIONS | BY | CHK'D |
|---|---|---|---|
| JAN. 69 | ADD COND. SAN SEWER | I.B. | |
| JULY 78 | U.G. BELL CABLE (LEE) | J.M. | |
| MAR'15 | ADDED LEGAL-REMOVED FH | G.W.C. | |

| DRAWN BY | CHECKED BY | APPROVED BY |
|---|---|---|
| D. DUNLOP | D. DUKE | |

| DATE | SCALE | BOOK NO | DWG. NO |
|---|---|---|---|
| DEC 1968 | 1"=40'-0" | #179 | M-926 |

KEUFFEL & ESSER CO. NEW YORK
TRADE STANDARD MARK REG. U.S. PAT. OFF. PROFILE PLATE A 4 X 20 100% RAG PAPER MADE IN U.S.A.
KEUFFEL & ESSER CO. NEW YORK