


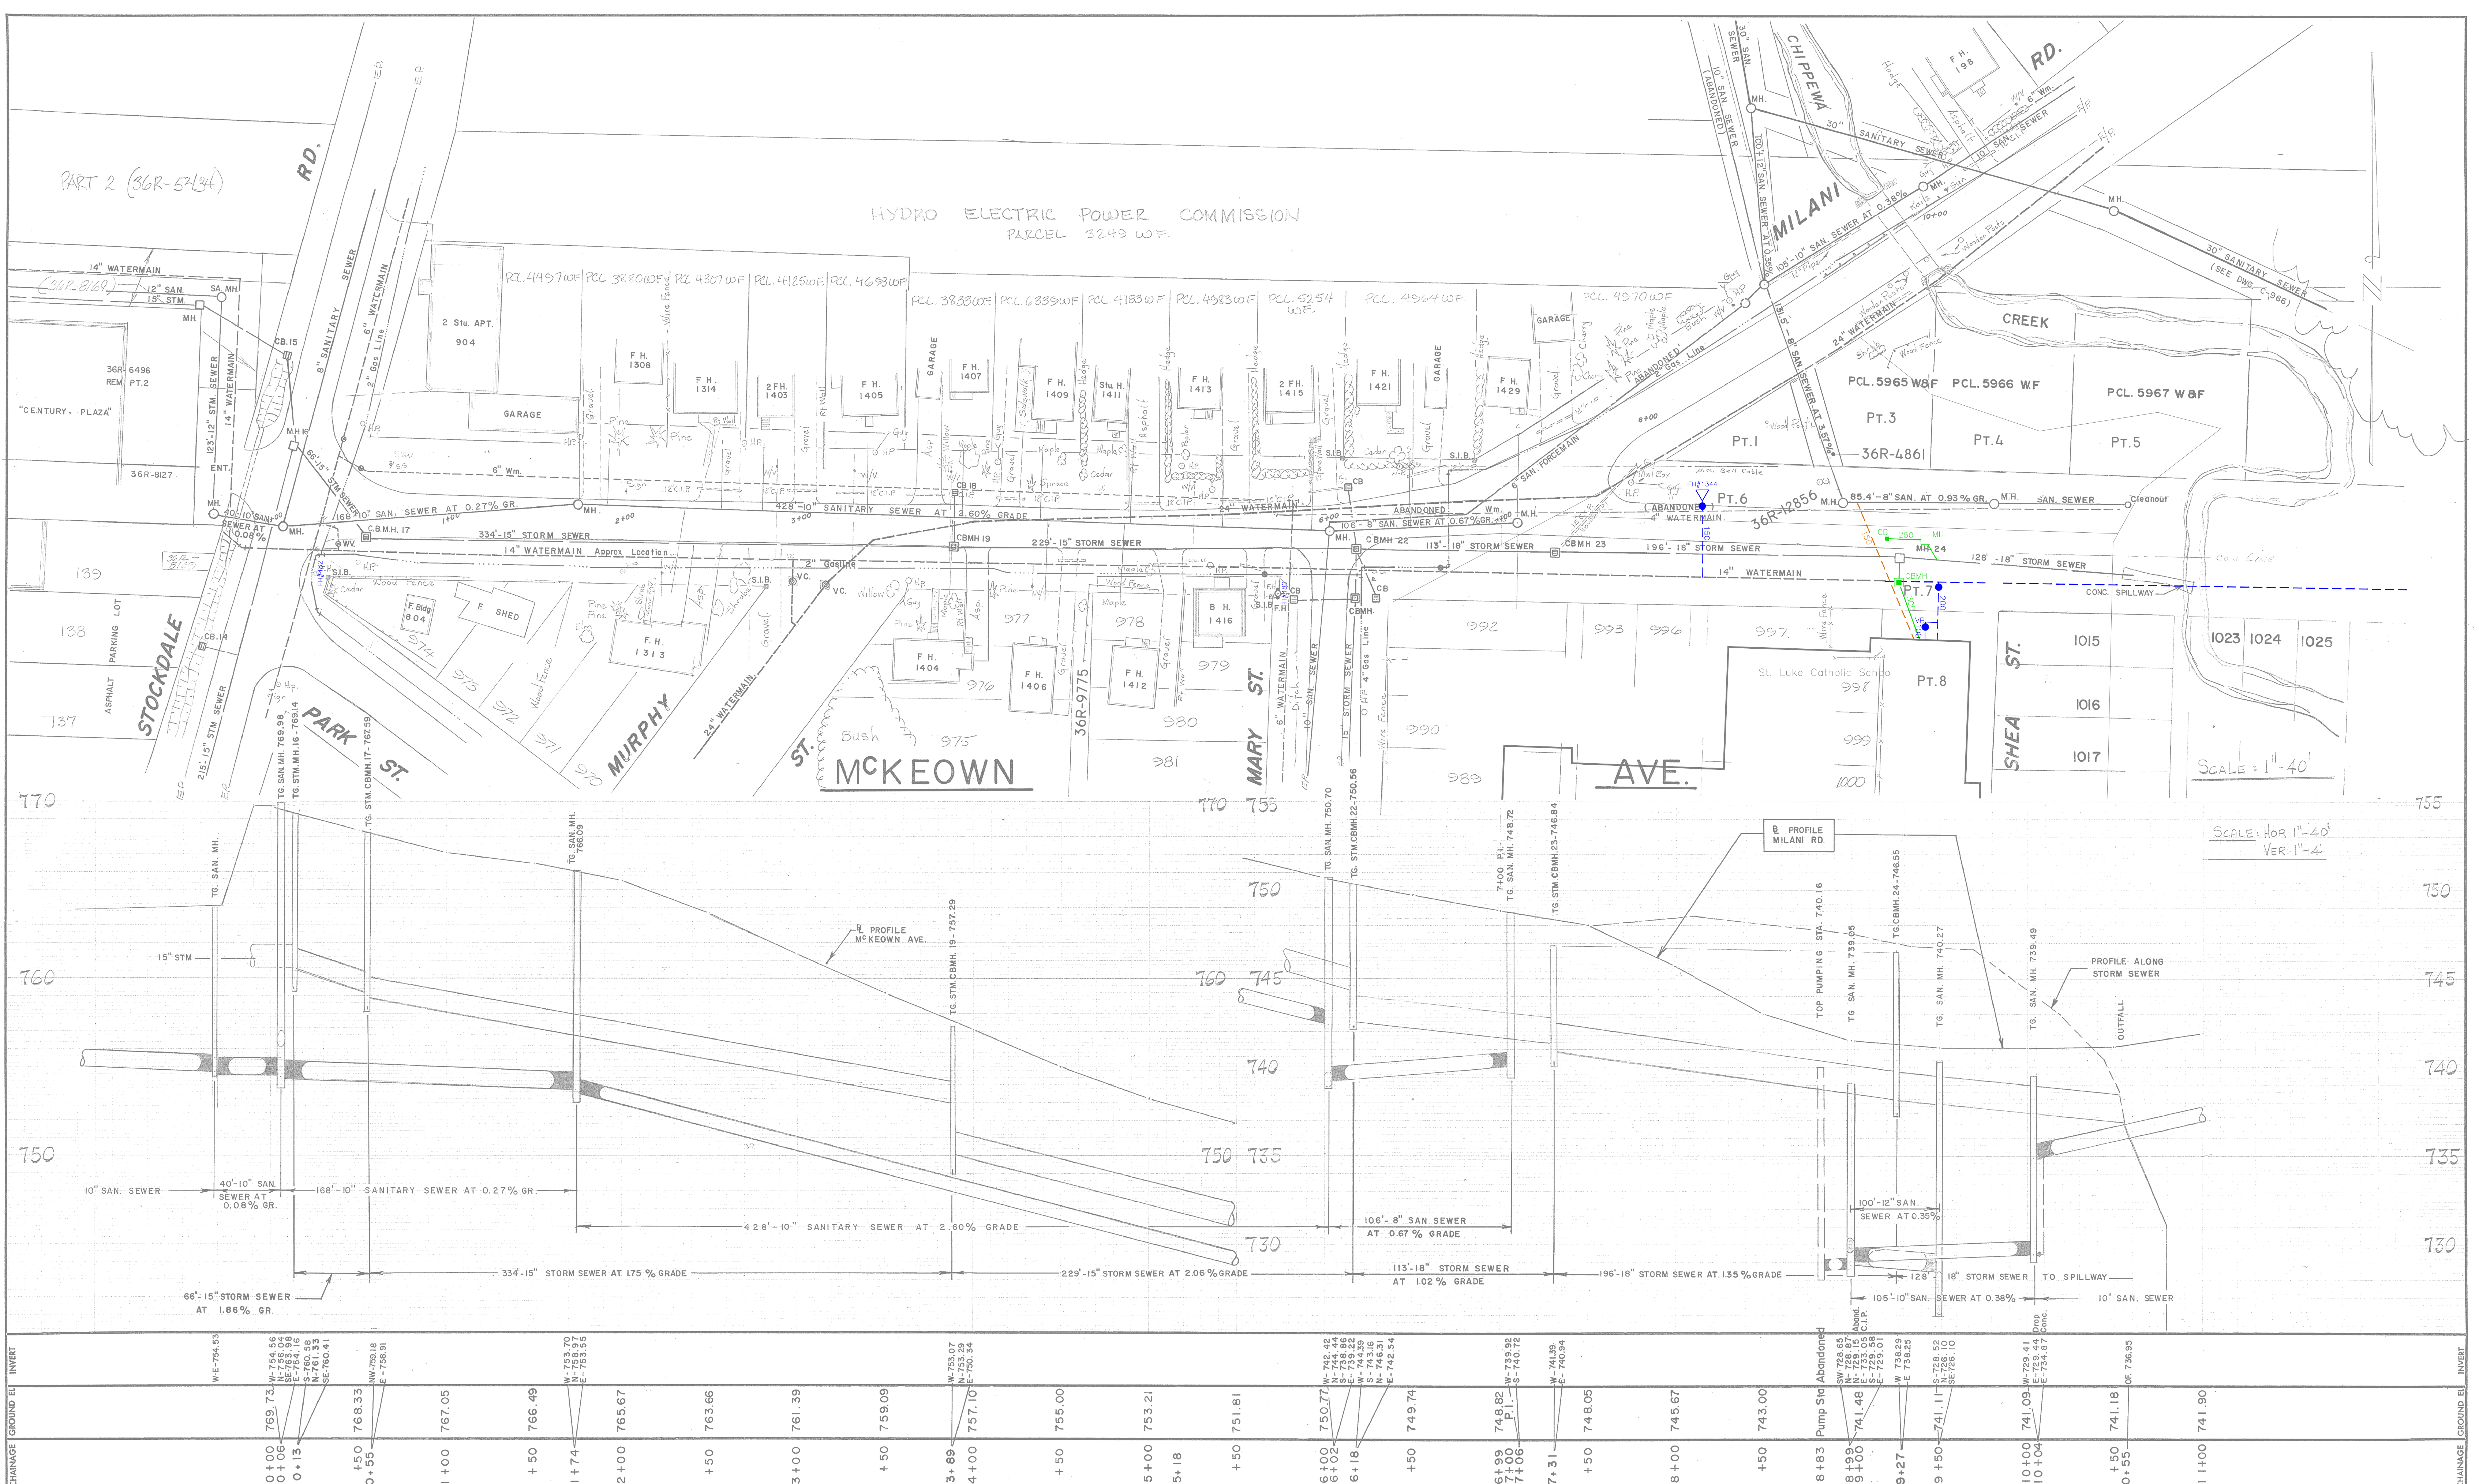

NOTES:

DISCLAIMER

The information contained on this drawing may be based upon data provided by others and may not have been verified by either as-constructed drawings or an Ontario Land Surveyor. The City of North Bay cannot accept responsibility for any errors or omissions on any information shown herein. Field verification, land surveys or excavation (with City approvals) may be required to determine actual location of any and all utilities or property lines.

No.	REVISION	DATE	INITIAL
8.	UPDATED SCHOOL AND SERVICES	OCT '12	G.W.C.
1.	ADD GAS LINE	NOV. 83	J.S.
2.	REVISE 8" SAN. SEWER AT SHEA ST.	NOV. 83	J.S.
3.	6" WM. LOCATION AS OF MARC. SEGUIN	SEPT. 91	R.T.
4.	ADD NEW STM. SEWER - STOCKDALE-MCKEOWN	JAN. 92	R.T.
5.	REGISTERED PLANS ADDED.	DEC. 08	R.J.O.
6.	ADDED 36R-12856	JUN/10	G.W.C.
7.	UPDATED WATER	FEB '11	G.W.C.

APPROVED

NORTH BAY
ON TARIO, CANADA
Just North Enough to be PERFECT

MCKEOWN AVE. - MILANI RD.
STOCKDALE ROAD TO CHIPPEWA CREEK

REQ'D PLAN N^o: M-177

CITY OF NORTH BAY
ENGINEERING DEPARTMENT

SCALE: AS SHOWN

DRAWN BY: RFB
CK'D BY:

FIELD BOOK No.
#220

DRAWING No.
MC-4

DATE: JULY/12

REV.