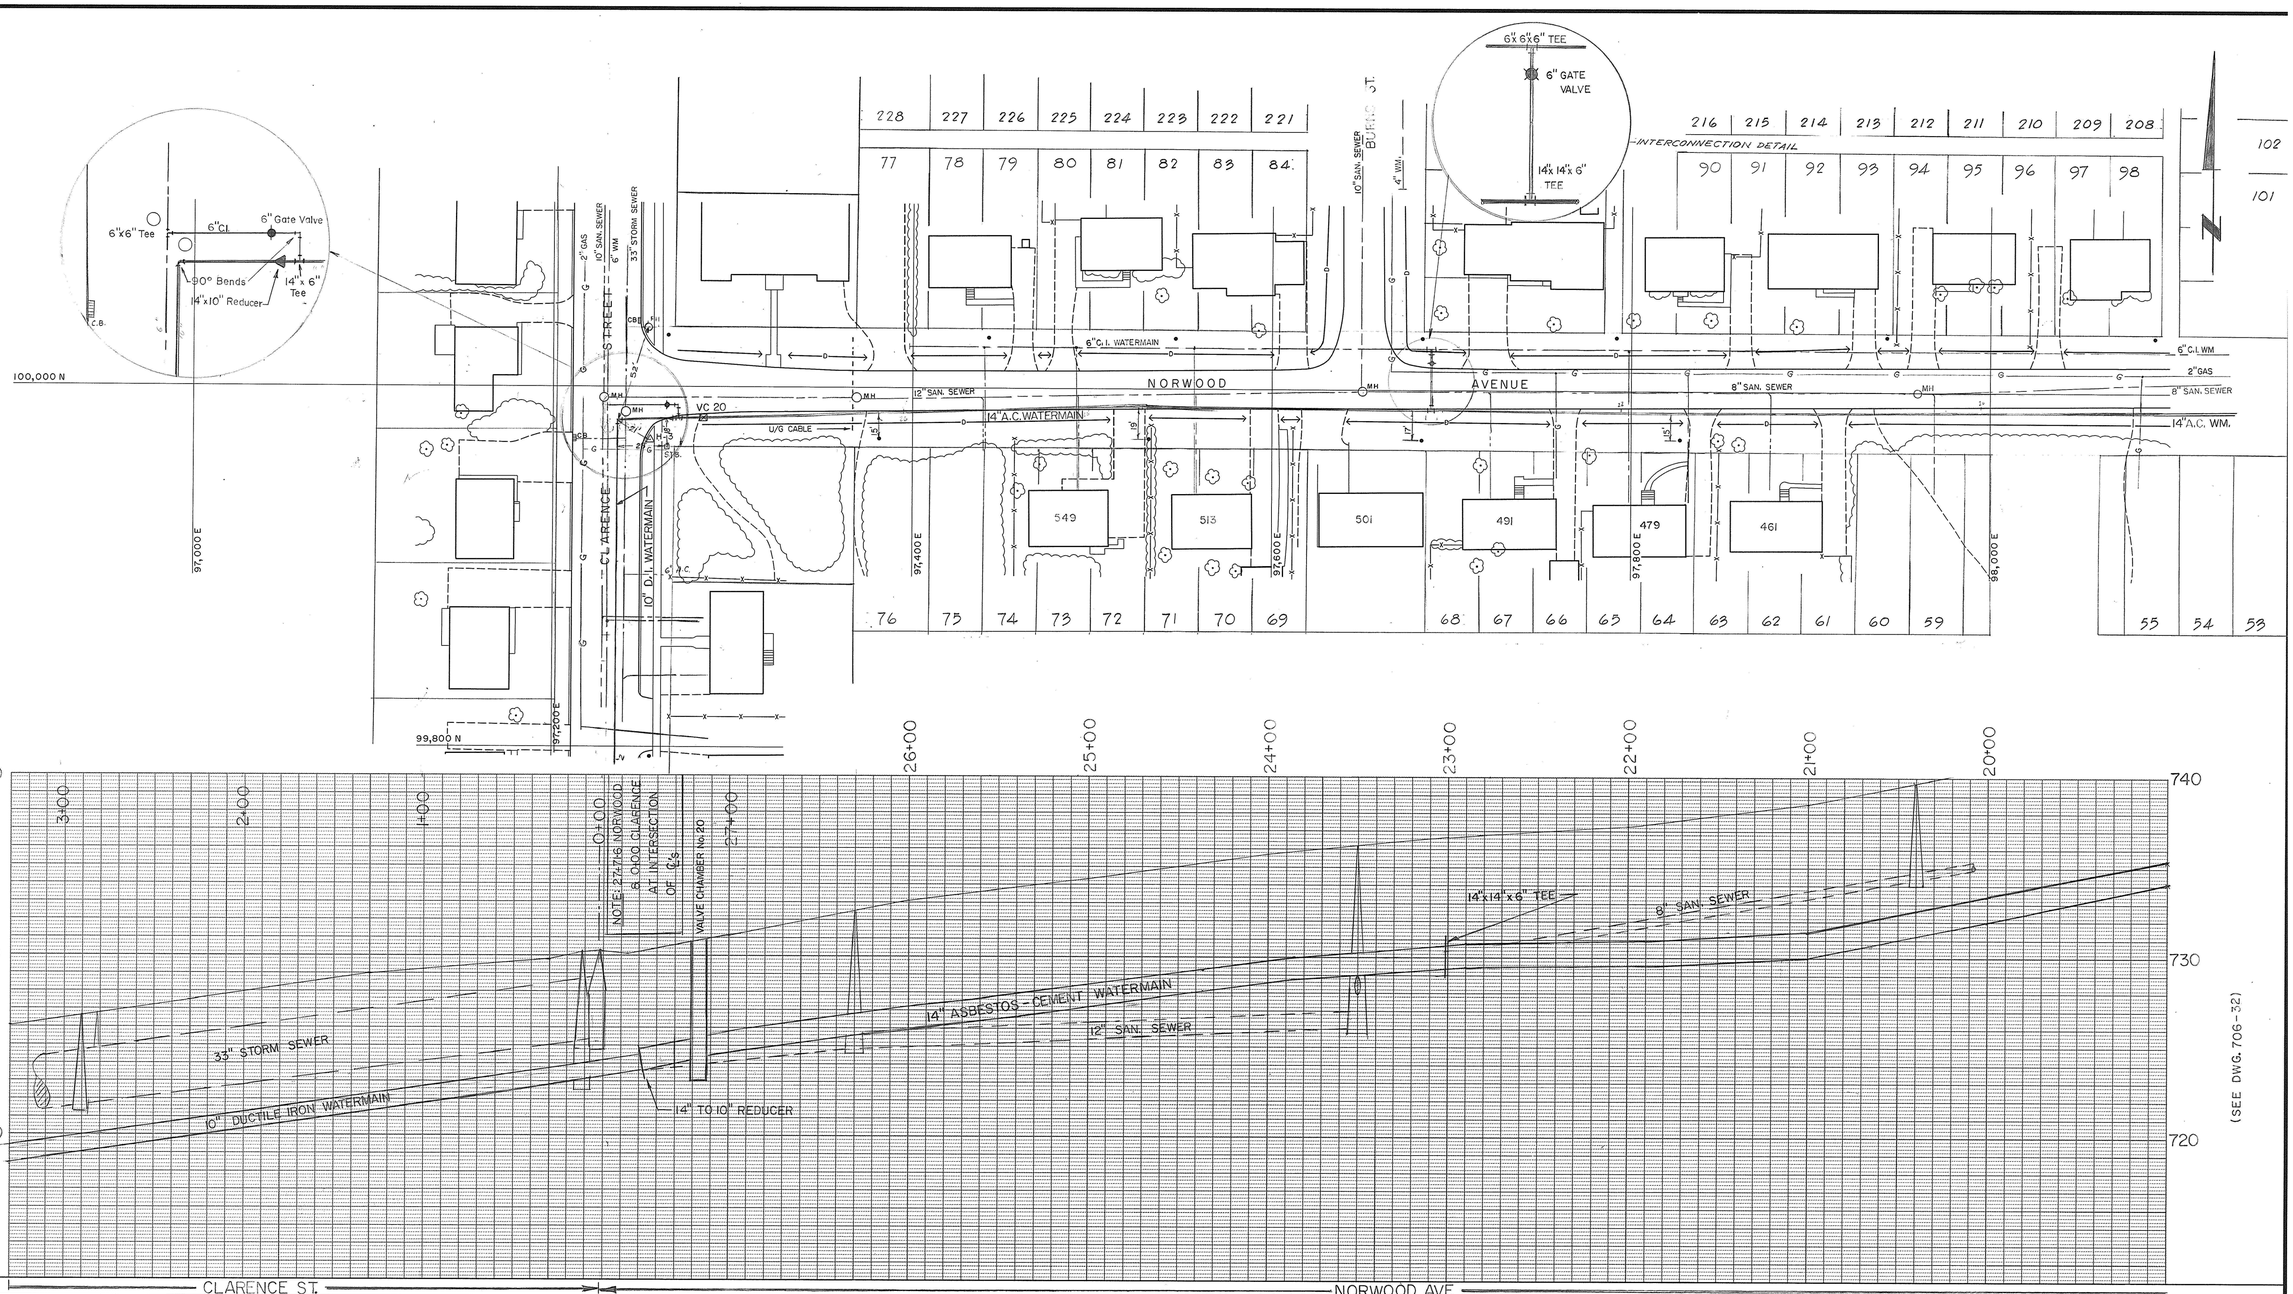

SHEET INDEX

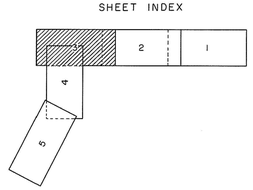

DISCLAIMER

The information contained on this drawing may be based upon data provided by others and may not have been verified by either as-constructed drawings or an Ontario Land Surveyor. The City of North Bay cannot accept responsibility for any errors or omissions on any information shown herein. Field verification, land surveys or excavation (with City approvals) may be required to determine actual location of any and all utilities or property lines.

MK.	BY	REVISIONS	APP.	DATE
B	M.W	LOT LINES & DESCRIPTIONS, PLAN Nº		DEC. 1974
A	J.G.K.	AS CONSTRUCTED		FEB. 1973

DWN. BY J.G.K.
CHKD. BY A.H.
DATE MAY 1971
SCALE HORIZ. 1"=40' VERT. 1"=4'

CONTRACT- D

NORWOOD AVENUE

STA. 20+00 to STA. 27+72
(CLARENCE ST. STA. 0+00 to STA. 3+00)

Northland Engineering Ltd.
CONSULTING CIVIL ENGINEERS
NORTH BAY - SUDBURY - TORONTO

No. 706-33
N-131