


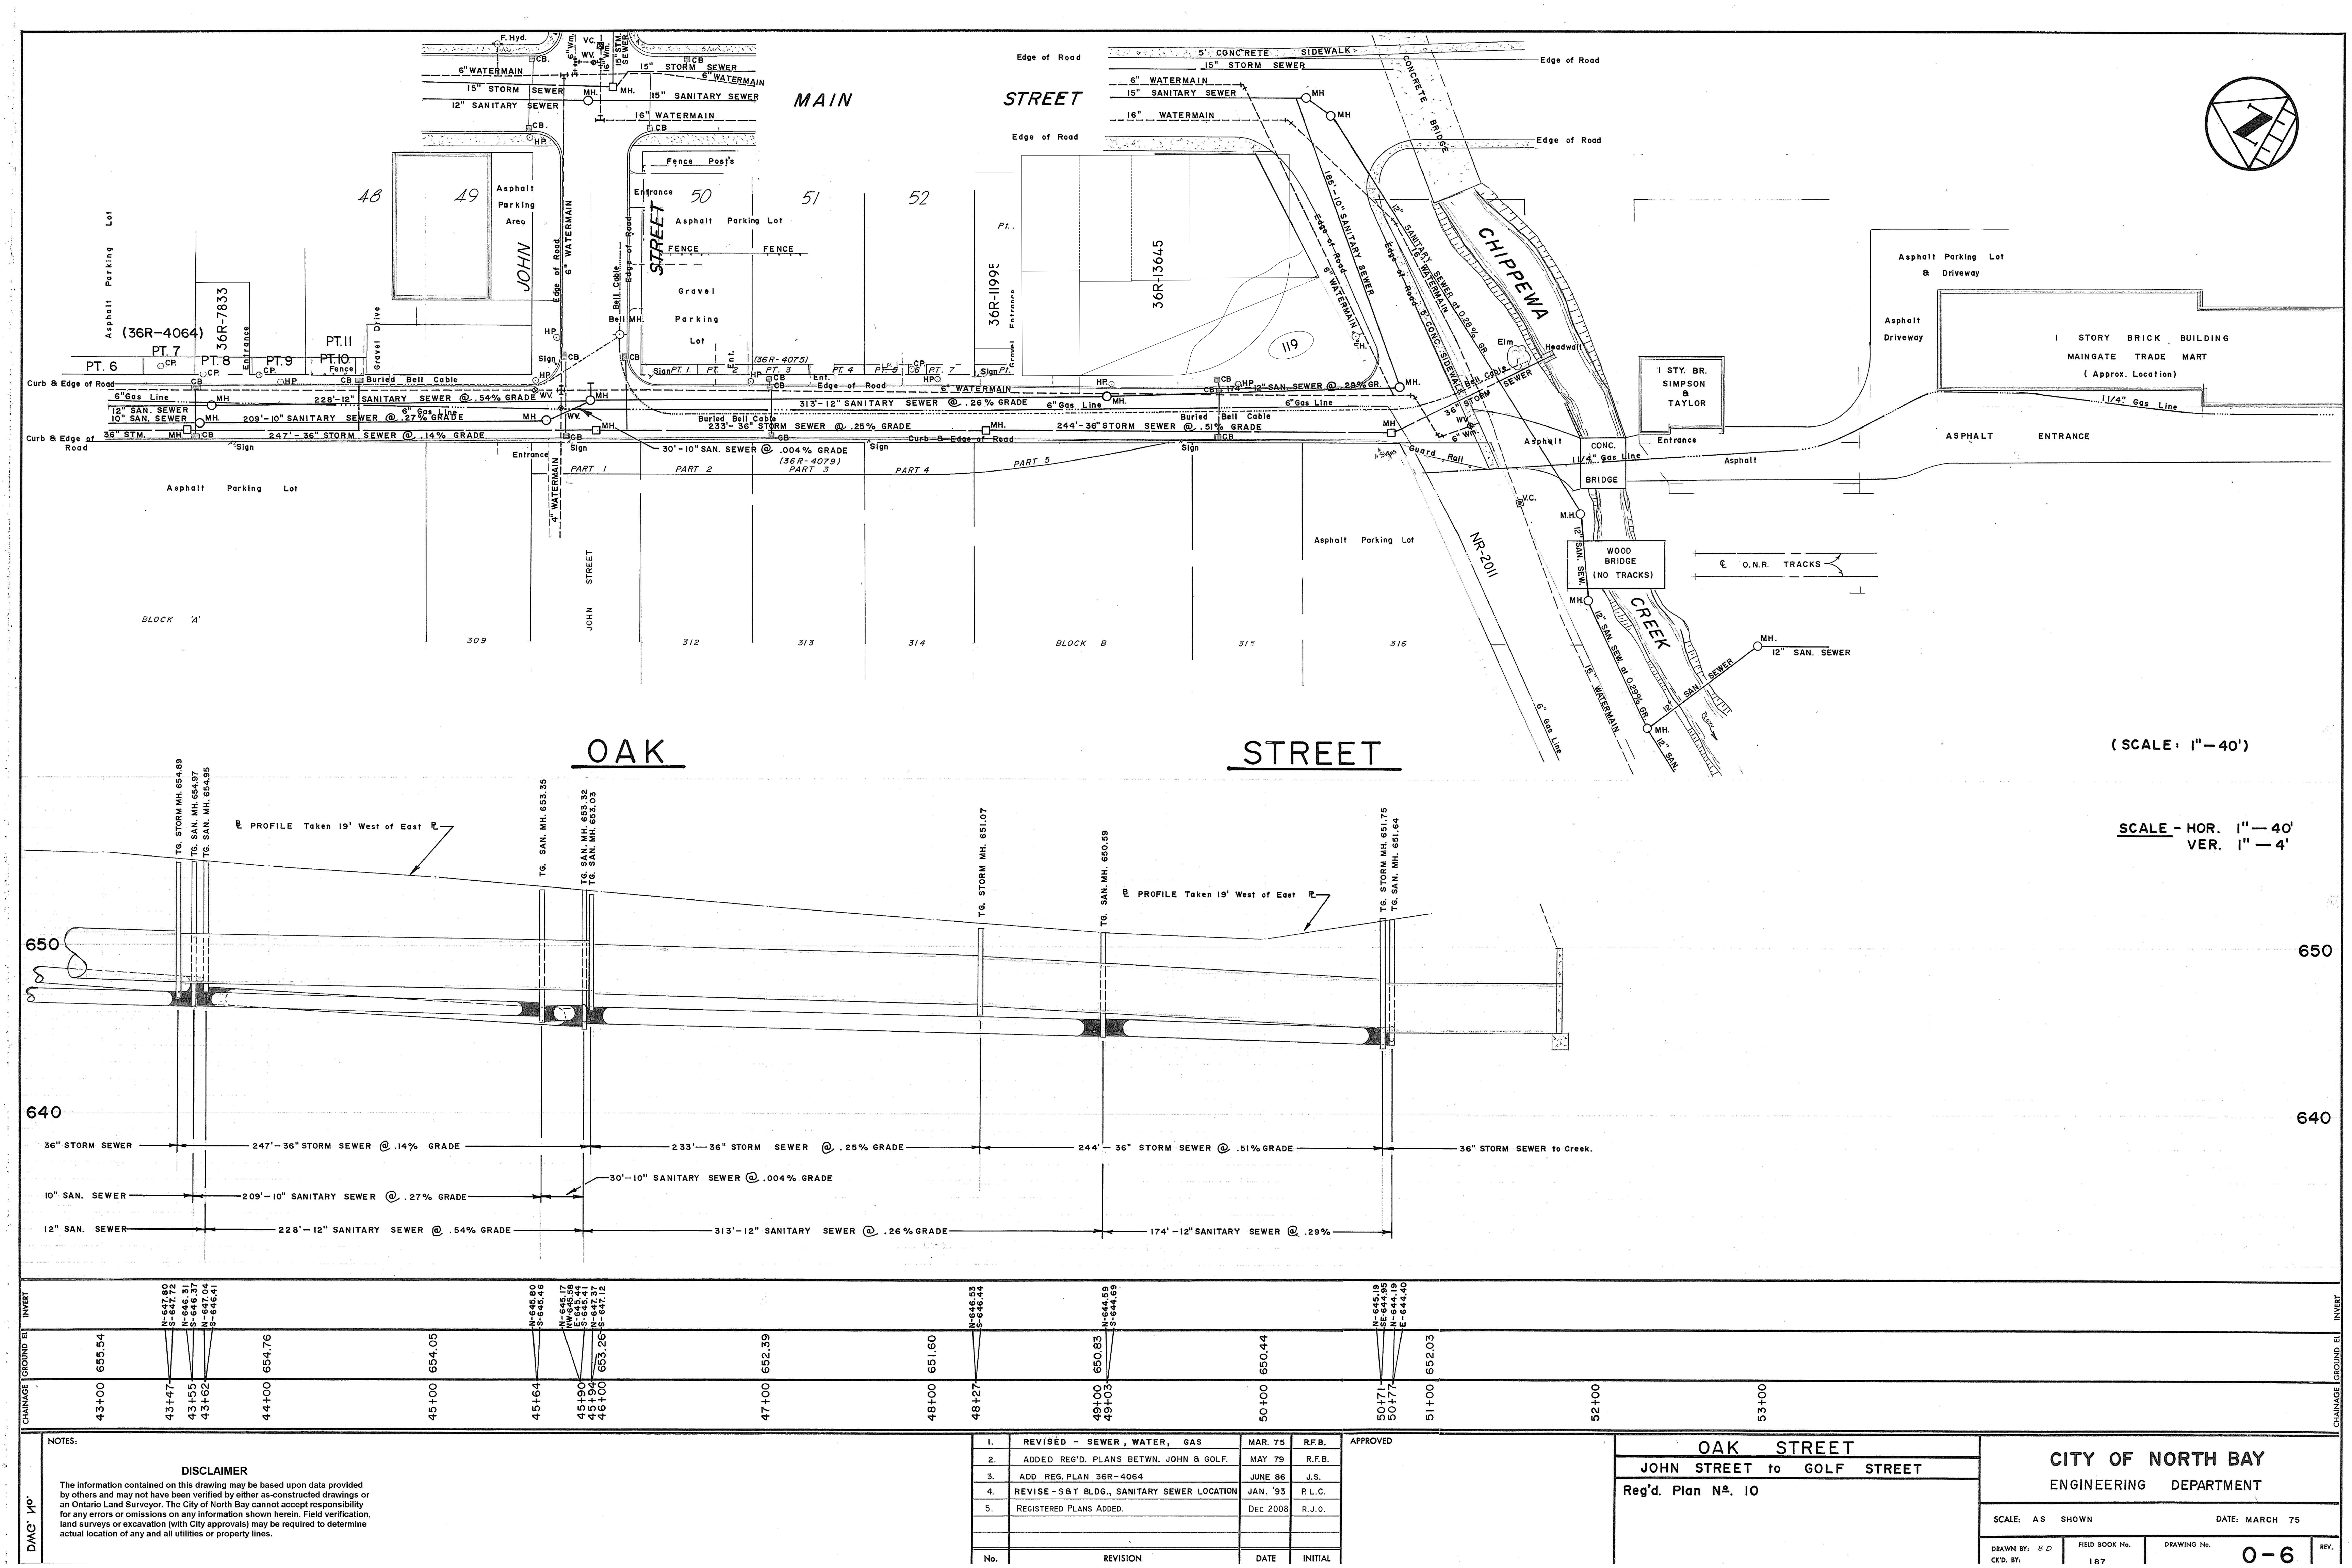

SCALE - HOR. 1" = 40'
VER. 1" = 4'

OAK STREET
JOHN STREET to GOLF STREET
Reg'd. Plan N ^o . 10

SCALE: AS SHOWN DATE: MARCH 75

DRAWN BY: <i>B.D.</i>	FIELD BOOK No.	DRAWING No.
CK'D. BY:	187	0-6

0-6