
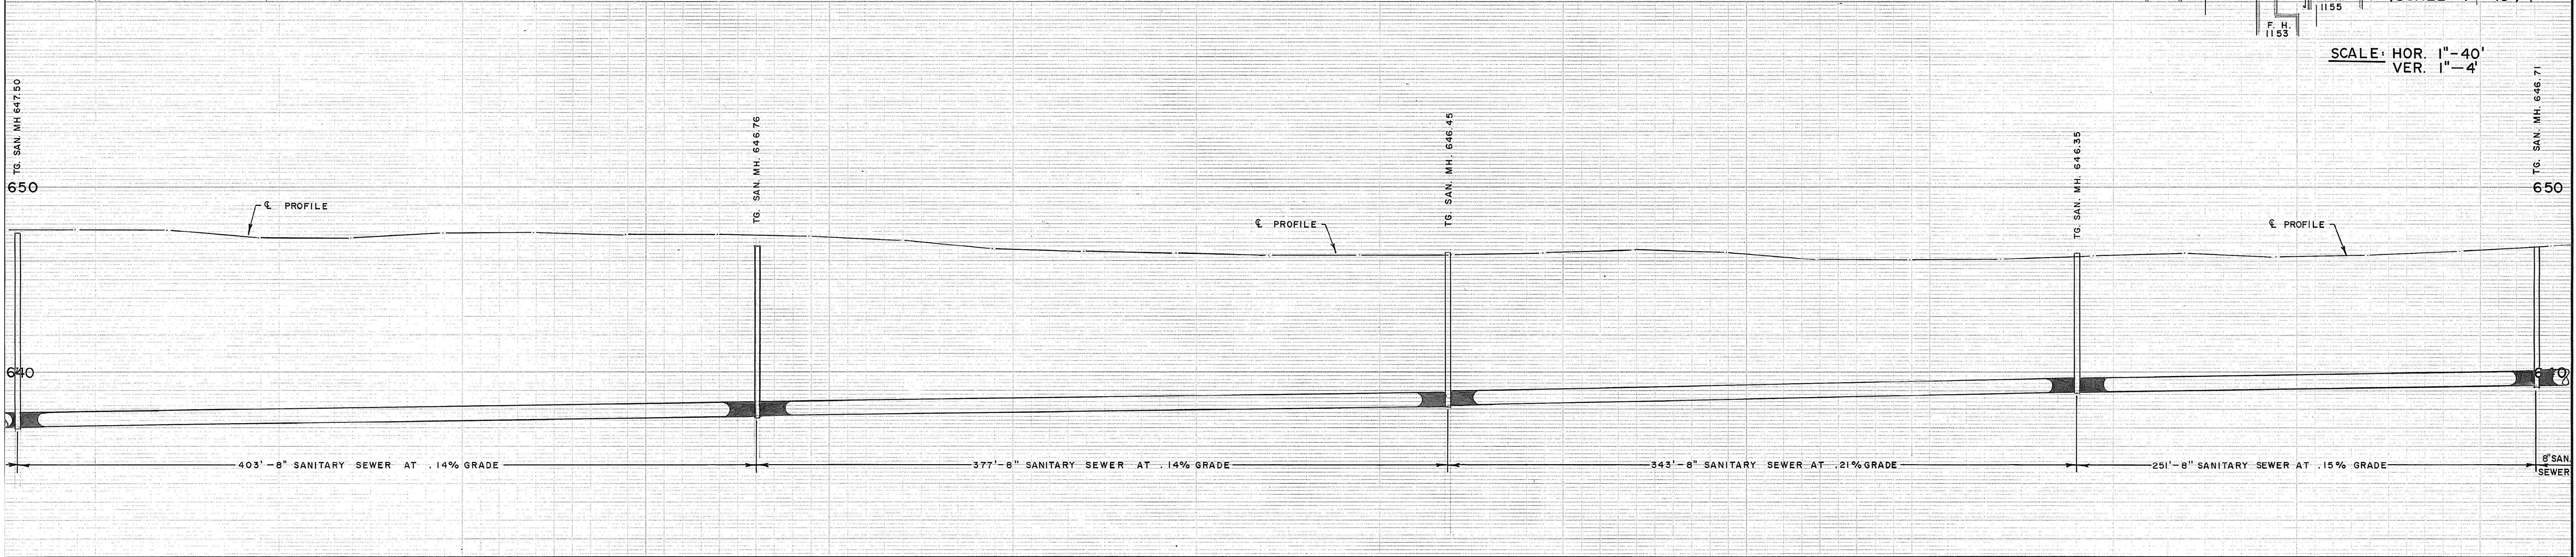


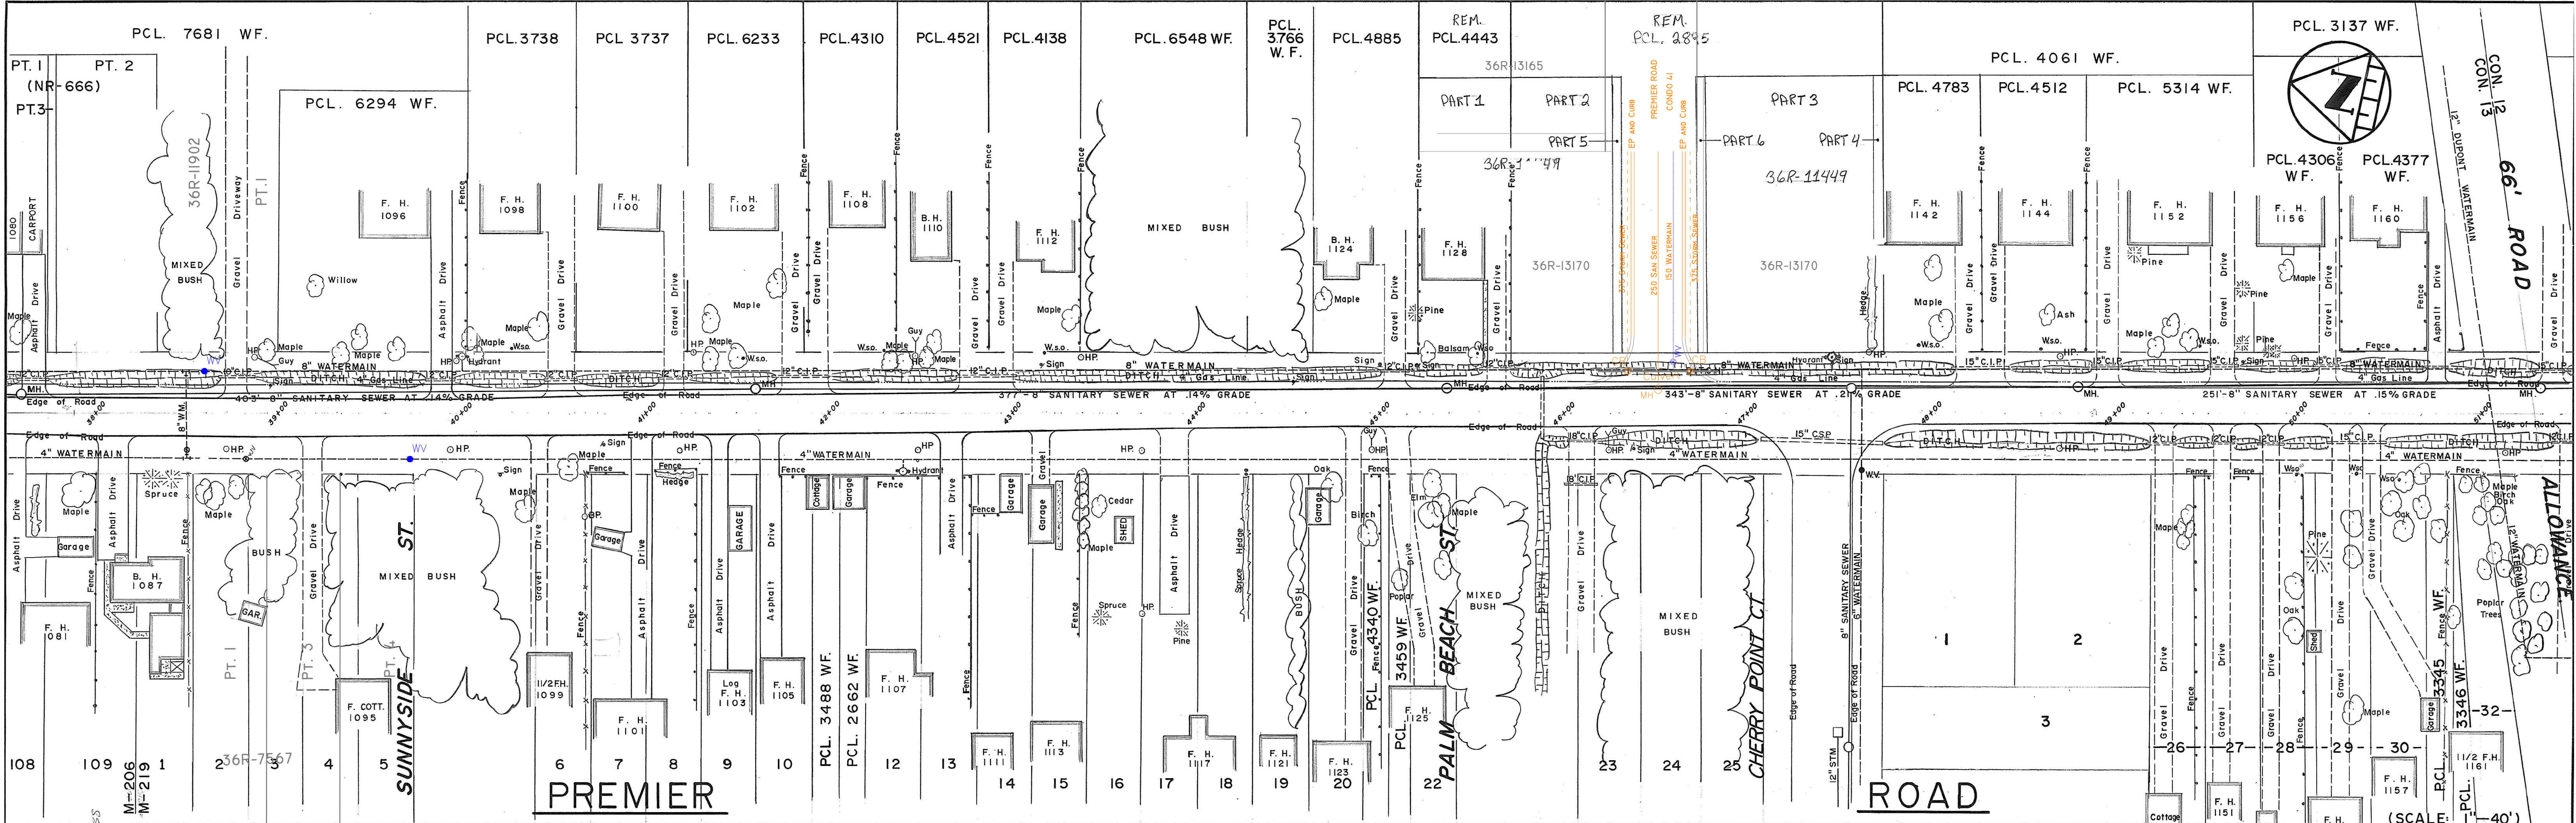

CHANGE	GROUND EL.	INVERT
37+57	647.07	647.07
37+88	647.71	
38+00		
38+38	647.63	
38+88	647.26	
39+00		
39+38	647.25	
39+88	647.51	
40+00		
40+38	647.56	
40+88	647.44	
41+00		
41+38	647.42	
41+60		
41+88	647.36	
42+00		
42+38	647.16	
42+88	646.66	
43+00		
43+38	646.54	
43+88	646.42	
44+00		
44+38	646.35	
44+88	646.36	
45+00		
45+37	646.39	
45+88	646.45	
46+00		
46+38	646.60	
46+88	646.46	
47+00		
47+38	646.28	
47+88	646.08	
48+00		
48+38	646.15	
48+88	646.28	
49+00		
49+38	646.42	
49+88	646.25	
50+00		
50+38	646.34	
50+88	646.59	
51+00		
51+38	646.81	
CHANGE	GROUND EL.	INVERT

NOTES:

DISCLAIMER

The information contained on this drawing may be based upon data provided by others and may not have been verified by either as-constructed drawings or an Ontario Land Surveyor. The City of North Bay cannot accept responsibility for any errors or omissions on any information shown herein. Field verification, land surveys or excavation (with City approvals) may be required to determine actual location of any and all utilities or property lines.

1	NEW DRAWING, FIELD NOTES	1971	JUNE 77	R.F.B.
2	PROPERTY LINES ADJUSTED ON EAST SIDE.		MAY 79	A.P.
3	PUT ON CHERRY POINT CT & SERVICES		JAN '02	J. STP.
4	REVISED WATER VALVE LOCATION		FEB 2006	RICK B
5	ADDED PREMIER ROAD CONDO 41 SERVICES SEE SUBDN		AUG 2009	RICK B
6	ADDED NEW 36R PLANS		NOV 2011	G.W.C.
No.	REVISION		DATE	INITIAL

APPROVED

PREMIER ROAD

STATION 38+00 TO STATION 51+00

Reg'd. Plan No. M-206, M-219, M-562

CITY OF NORTH BAY

ENGINEERING DEPARTMENT

SCALE: AS SHOWN

DATE: JUNE 1977.

DRAWN BY: RICK B

CK'D. BY:

FIELD BOOK No.

DRAWING No.

P- 254

REV.