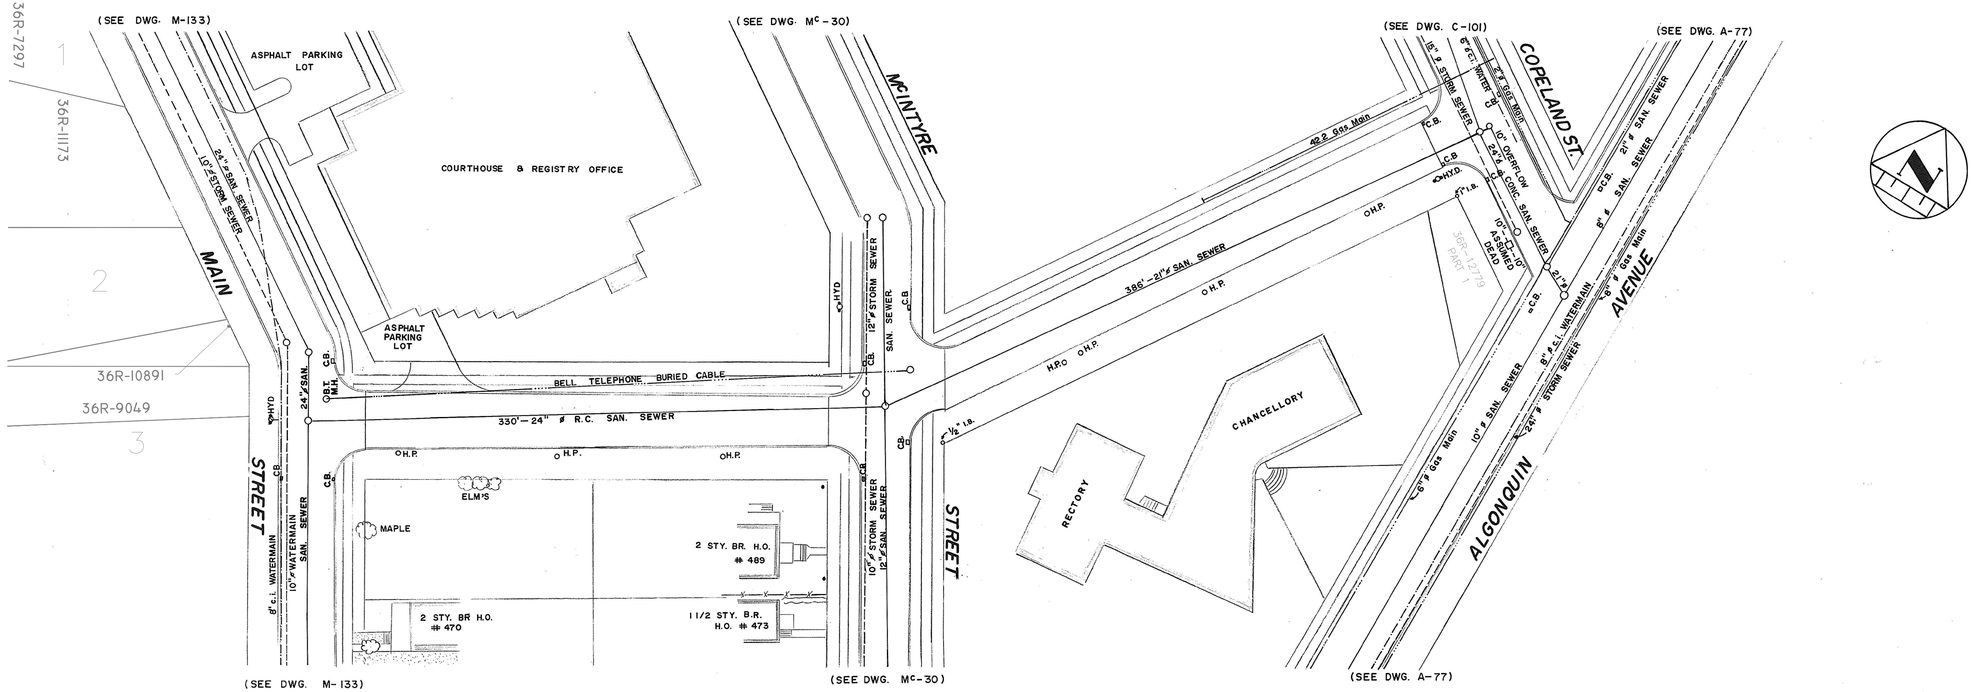

PLOUFFE STREET

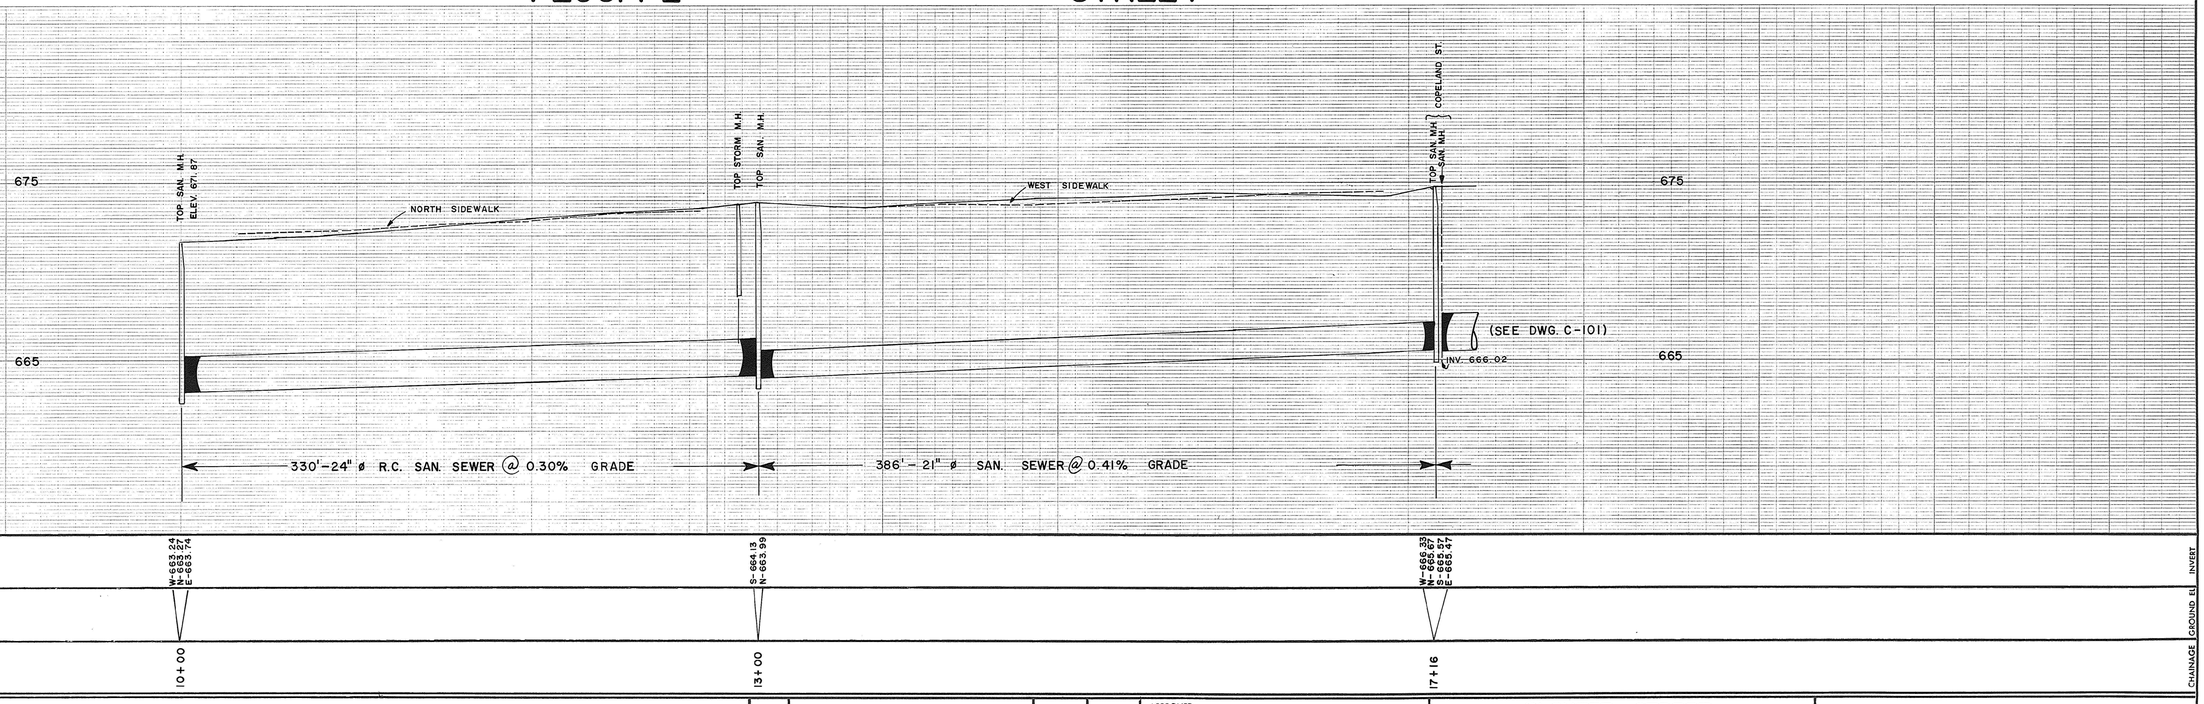

NOTES:

DISCLAIMER

The information contained on this drawing may be based upon data provided by others and may not have been verified by either as-constructed drawings or an Ontario Land Surveyor. The City of North Bay cannot accept responsibility for any errors or omissions on any information shown herein. Field verification, land surveys or excavation (with City approvals) may be required to determine actual location of any and all utilities or property lines.

DMC' 90'

No.	REVISION	DATE	INITIAL
5	Added 36R-12779	NOV 09	G.W.C.
4	REDRAWN FROM ORIGANAL PLAN & PROFILE	AUG. 88	J.D.R.
3	42.2 GAS MAIN	JAN. 82	B.D.
2	STREET NAME CHANGES	MAR. 73	P.F.B.
1	AS CONST'D SAN. SEWER REPLACEMENT BK-167 PG-60-1	JAN. 67	B.S.

APPROVED

PLOUFFE STREET
MAIN ST. TO COPELAND ST.

CITY OF NORTH BAY
ENGINEERING DEPARTMENT

SCALE: HOR: 1" = 40'
VER: 1" = 4'

DATE: AUG. 88

DRAWN BY: J.D.R.
CK'D. BY:

FIELD BOOK No.

DRAWING No. P-426

REV.