



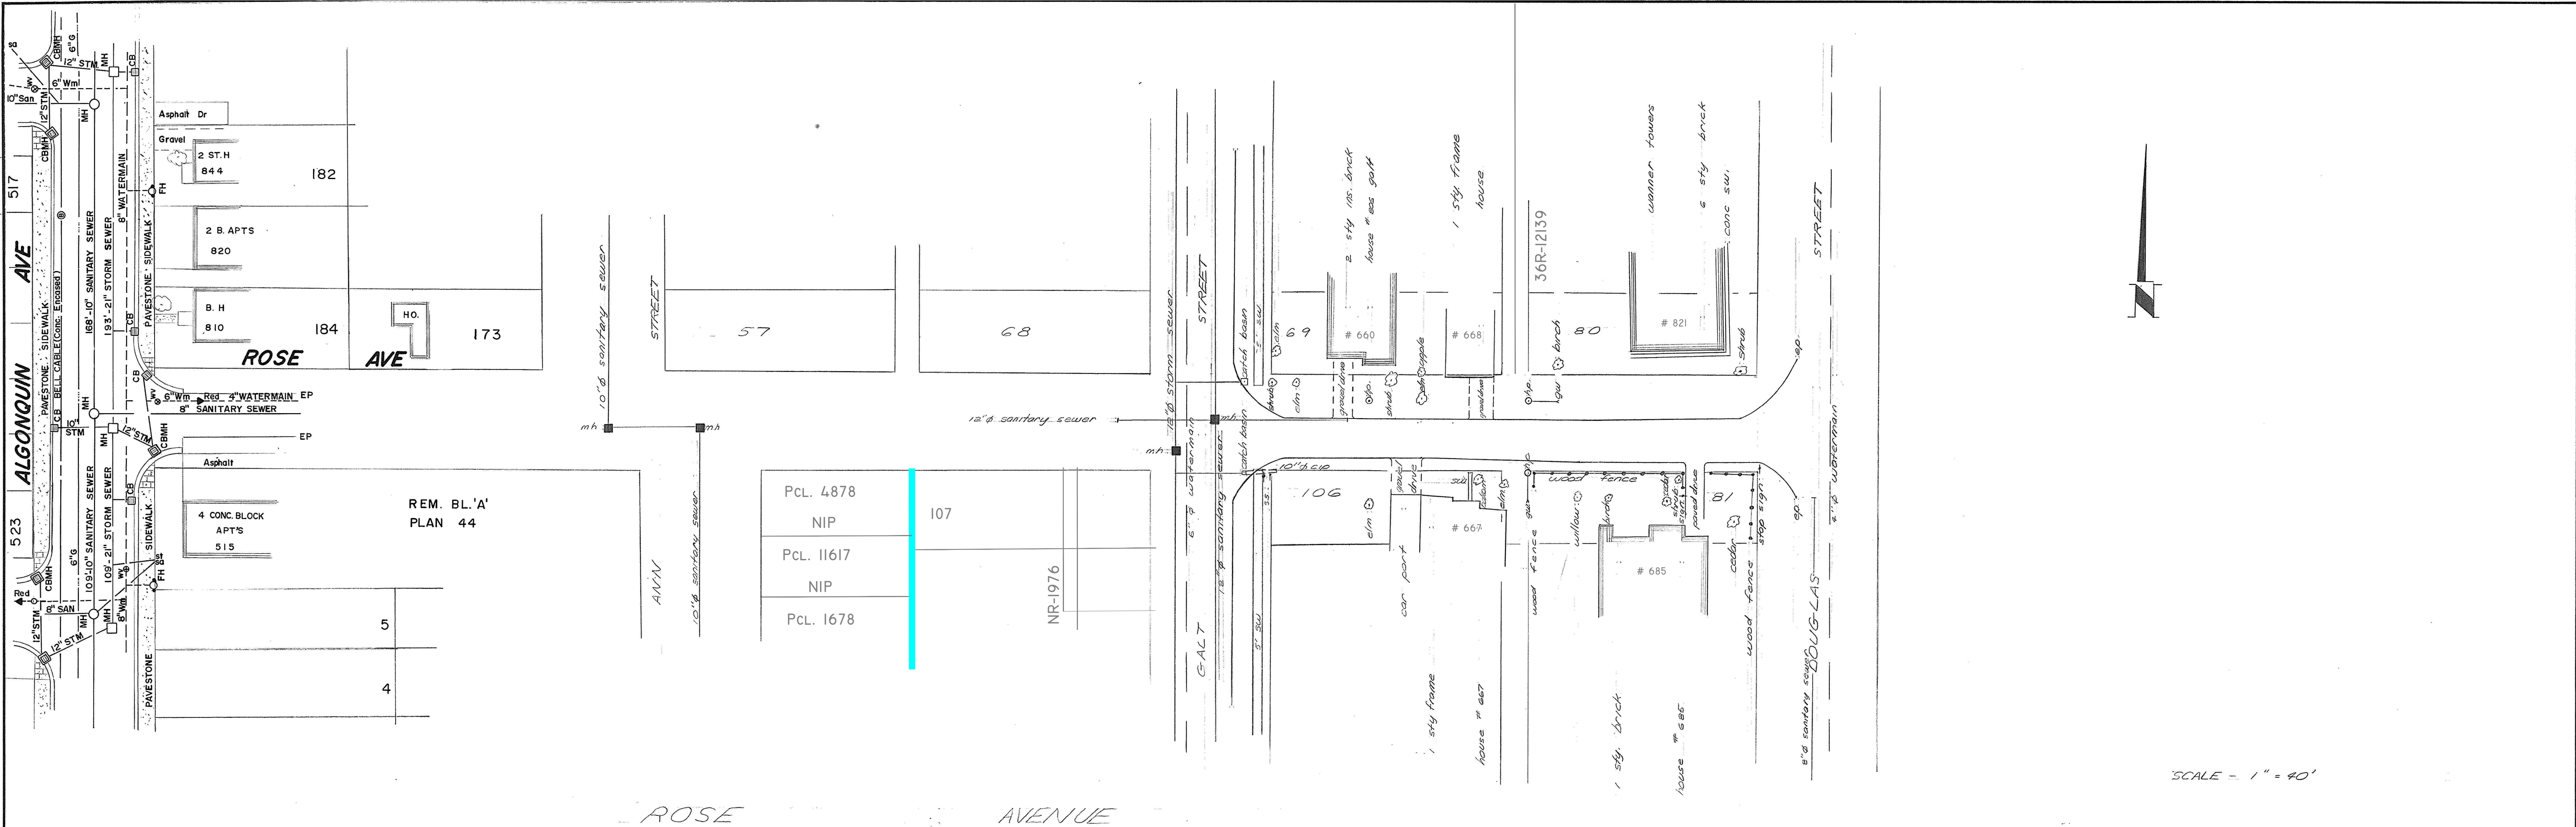

SCALE = 1" = 40'

SCALE VERT - 1" = 4'
HOR - 1" = 40'

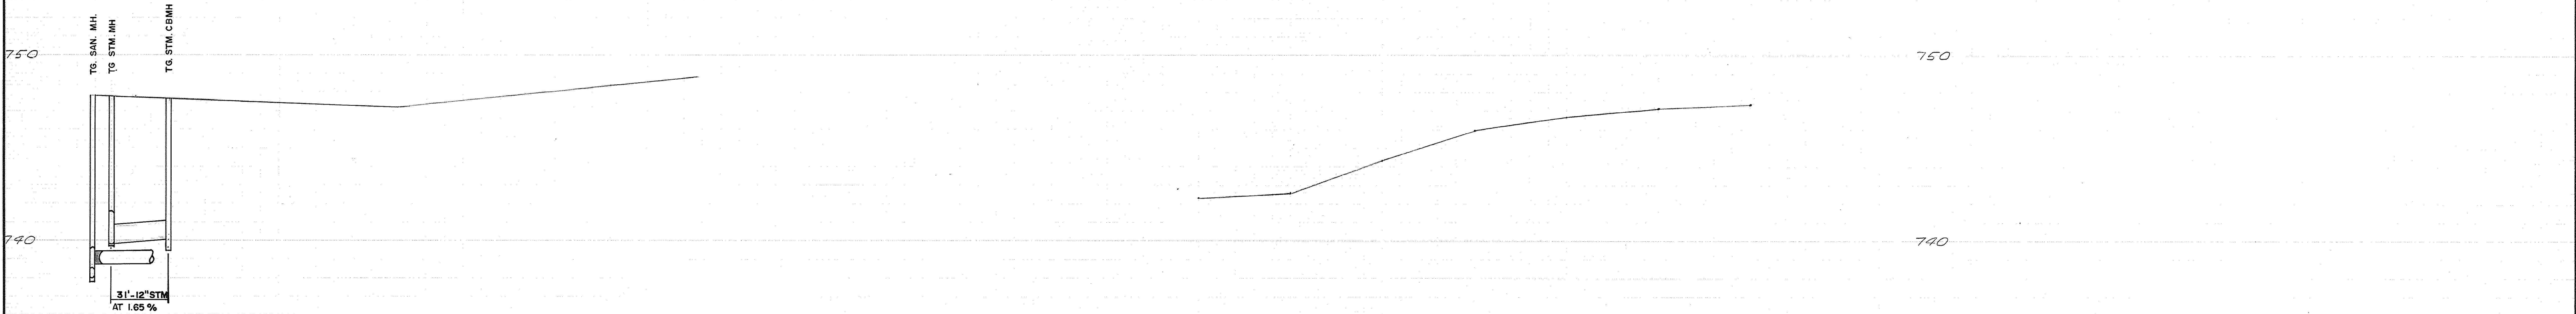

CHAINAGE	GROUND EL	INVERT
	750	
	740	
	-10	
	-20	
