
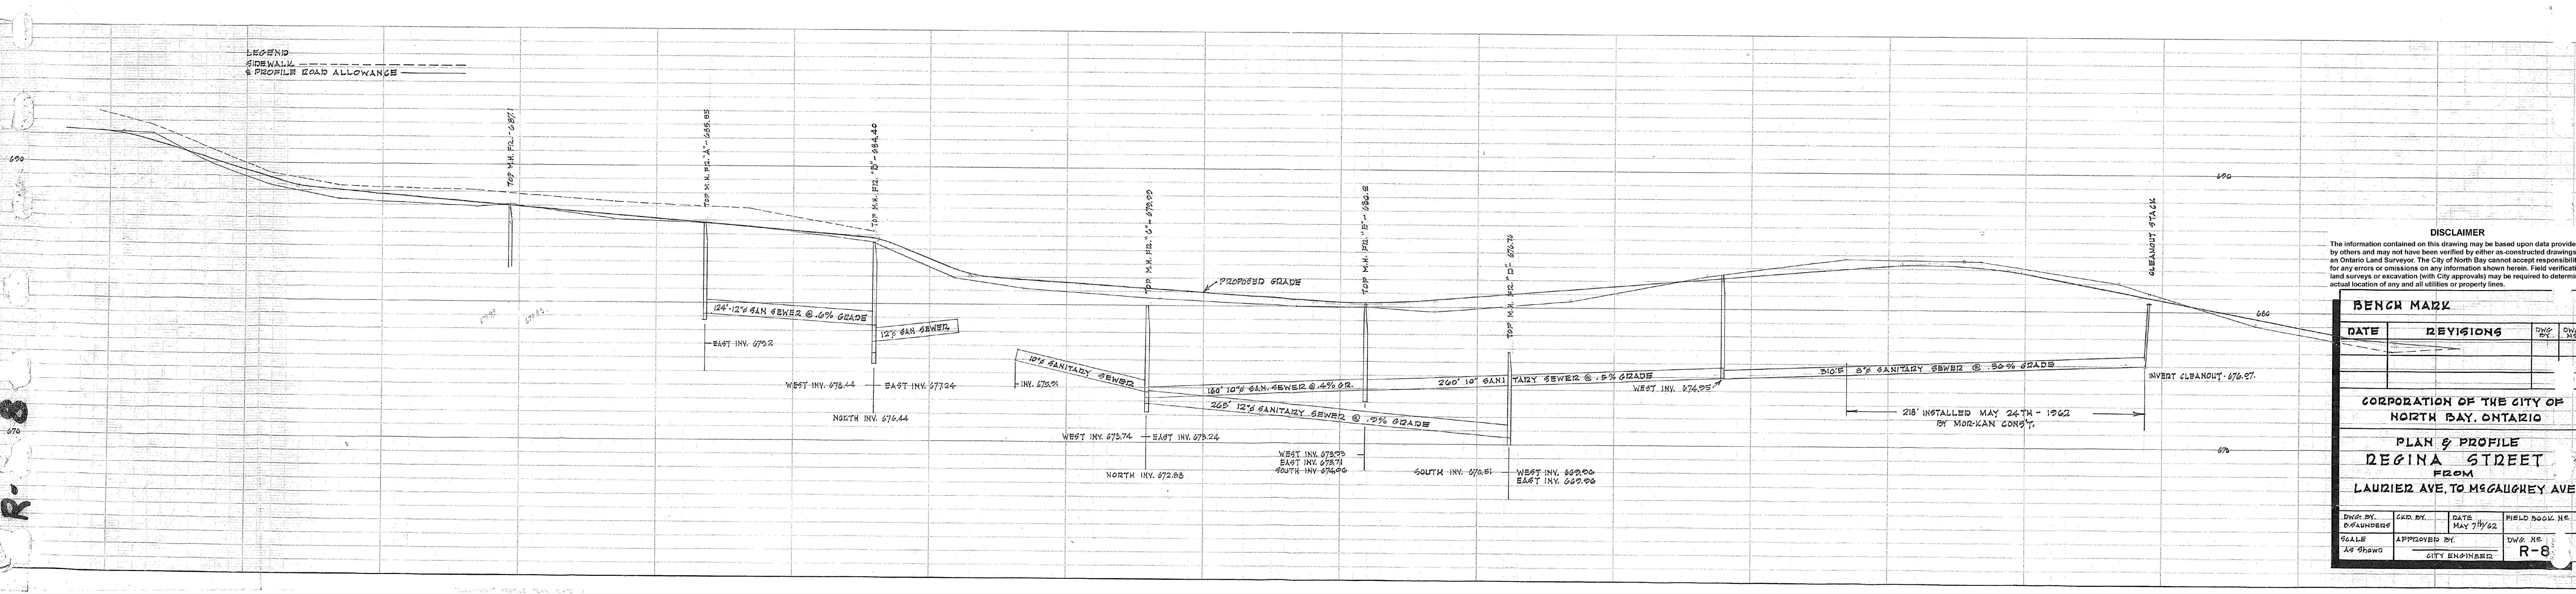


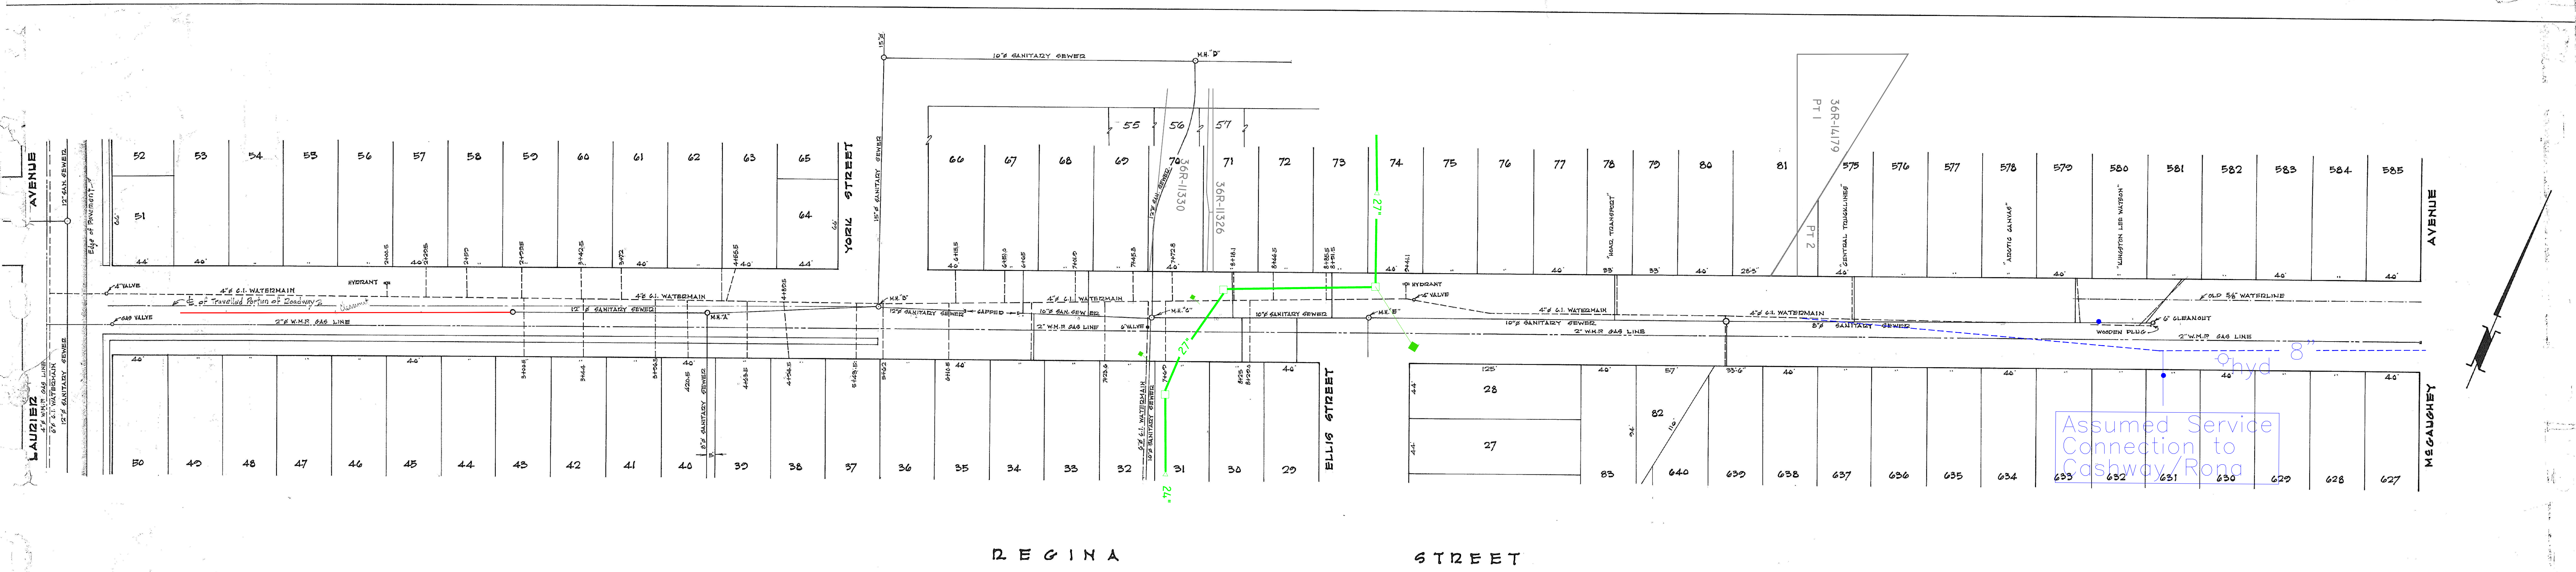

DISCLAIMER
The information contained on this drawing may be based upon data provided by others and may not have been verified by either as-constructed drawings or an Ontario Land Surveyor. The City of North Bay cannot accept responsibility for any errors or omissions on any information shown herein. Field verification, land surveys or excavation (with City approval) may be required to determine actual location of any and all utilities or property lines.

BENCH MARK			
DATE	REVISIONS	DWG. NO.	DWG. REV.

CORPORATION OF THE CITY OF NORTH BAY, ONTARIO

PLAN & PROFILE
REGINA STREET

DWG. BY	CHK. BY	DATE	FIELD BOOK NO.

SCALE	APPROVED BY	DWG. NO.
AS SHOWN		R-8

CITY ENGINEER