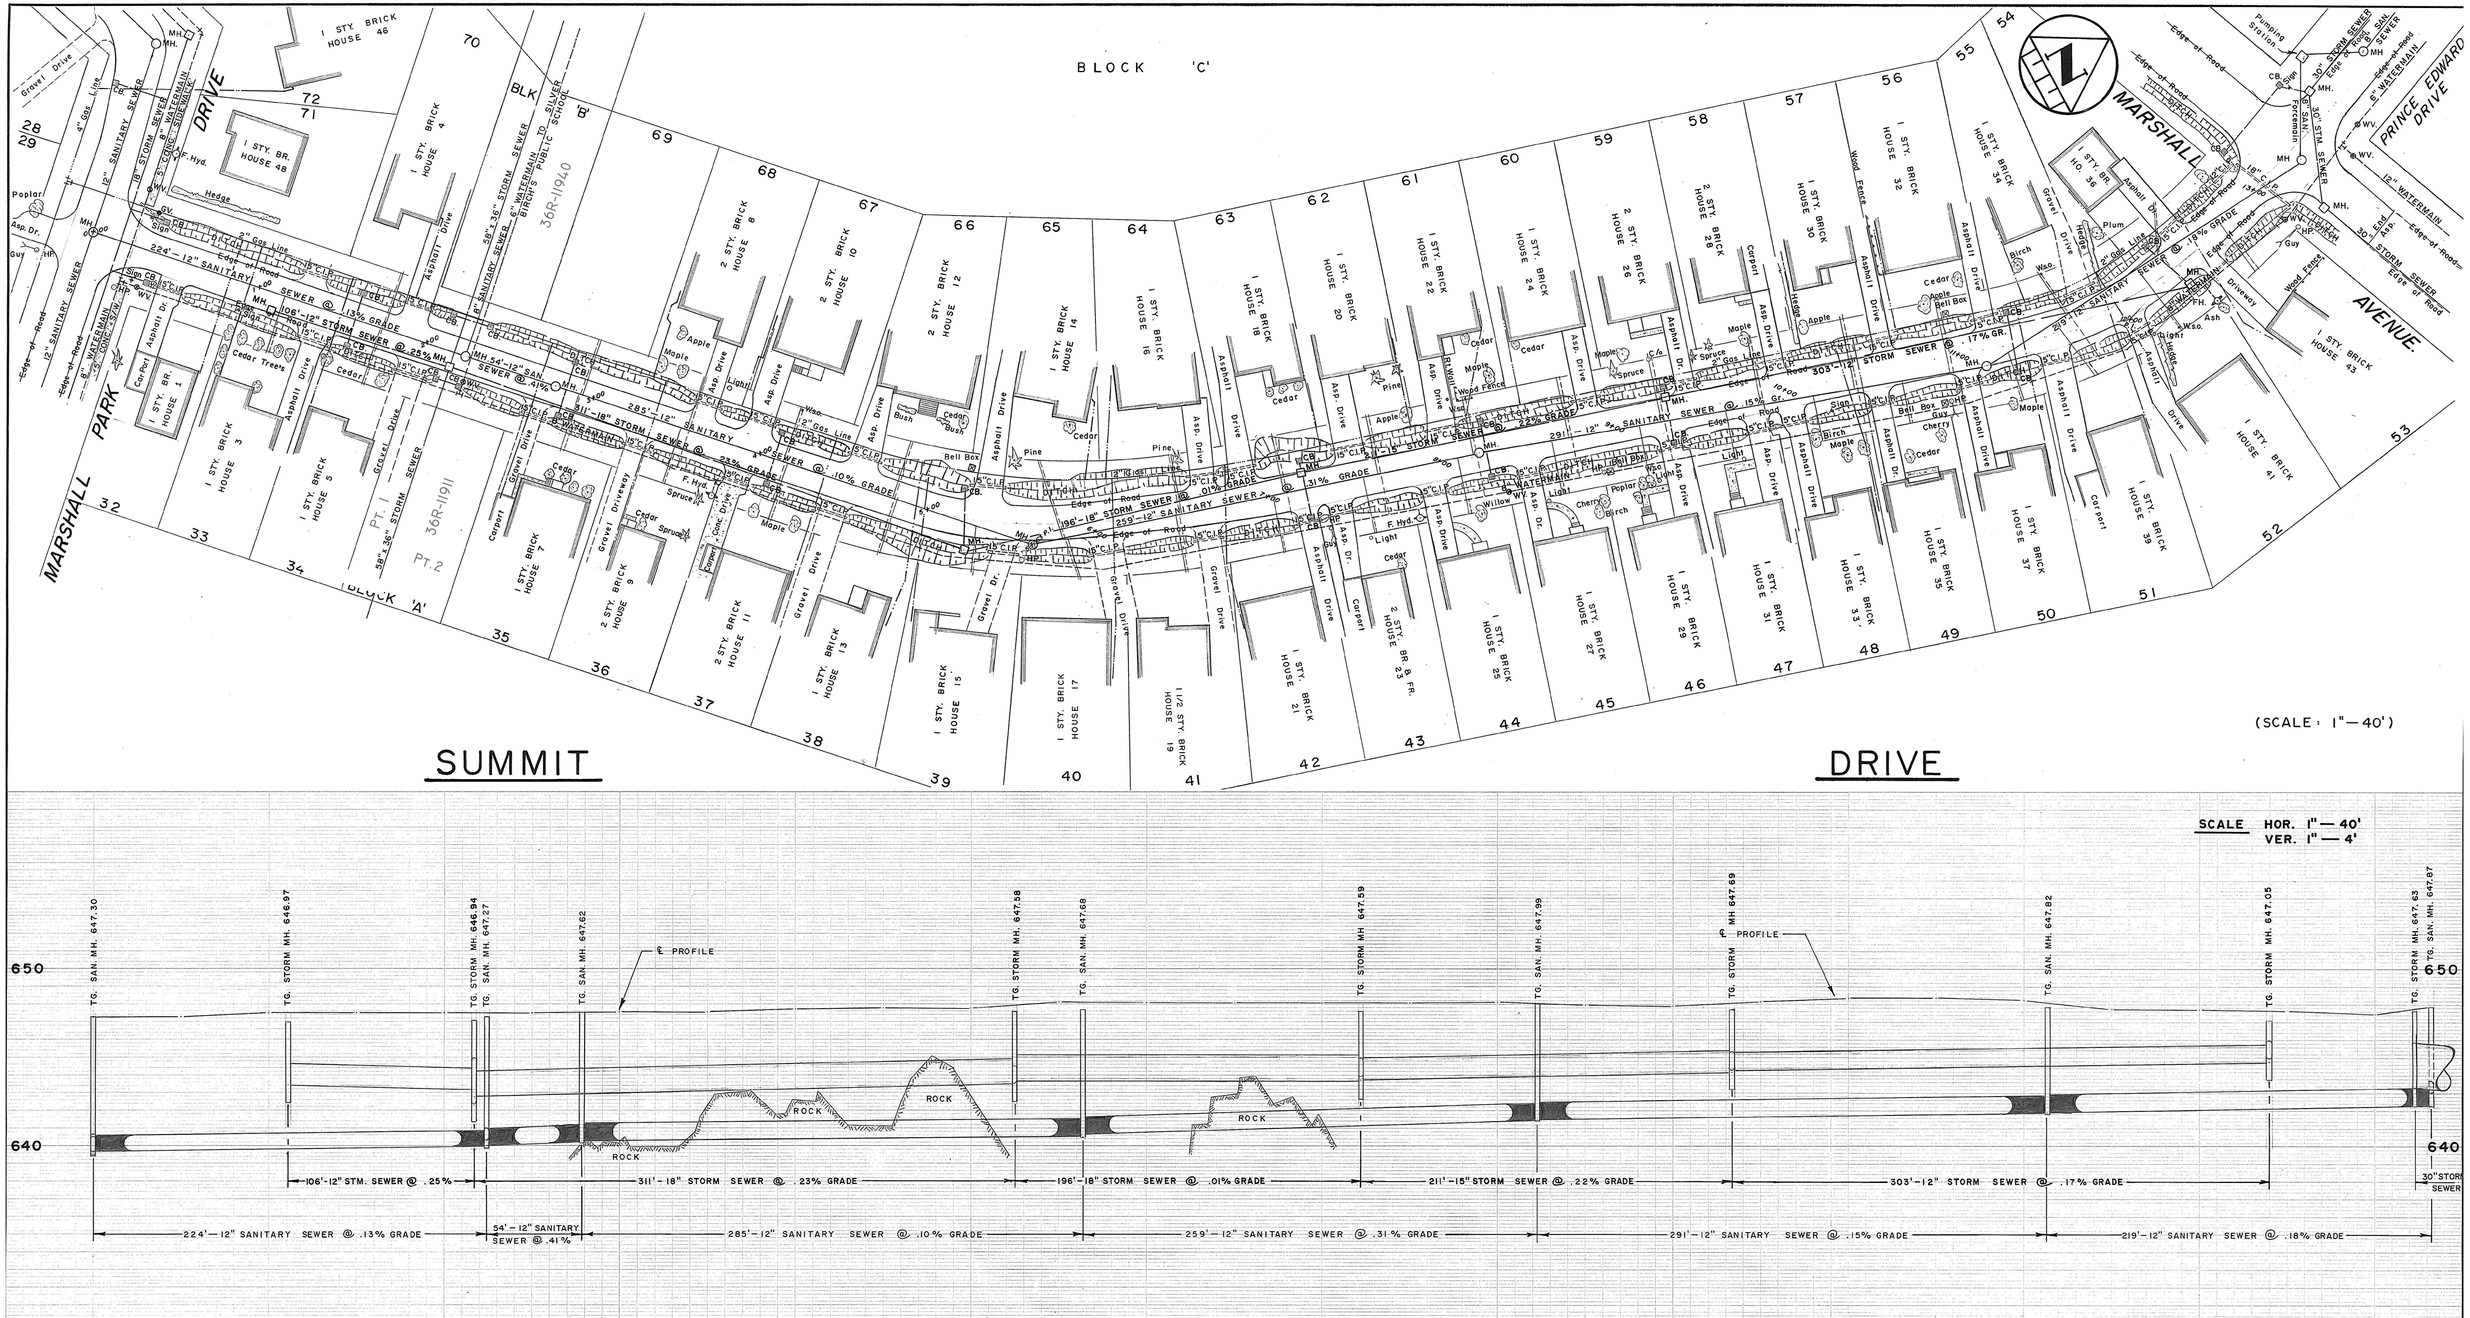

CHAINAGE	GROUND EL	INVERT
0+00	647.22	N-639.49 S-639.65 E-639.69
0+50	647.27	
1+00	647.52	E-643.44
1+11		
1+50	647.51	
2+00	647.49	W-643.18 E-642.78 N-642.37 S-642.32 W-639.99 N-640.36 E-640.00
2+17		
2+24		
2+50	647.47	
2+78		W-640.22 E-640.25
3+00	647.55	
3+50	647.57	
4+00	647.74	
4+50	647.79	
5+00	647.78	
5+25		SW-643.51 W-643.54 NE-643.54
5+50	648.16	9' LEFT W-640.53 NE-640.63
5+63		
6+00	648.11	6' LEFT
6+50	648.07	
7+00	648.08	
7+22		SW-643.62 E-643.99 W-643.97 NE-643.72
7+50	648.07	
8+00	648.13	
8+22		SW-641.42 NE-641.47
8+50	647.99	
9+00	647.93	
9+33		SW-644.19 W-644.32 E-644.32 NE-644.27
9+50	648.17	
10+00	648.39	
10+50	648.39	
11+00	648.27	SW-641.92 N-641.97
11+13		
11+50	647.76	
12+00	647.66	12' LEFT
12+39		SW-644.79 W-644.95
12+50	647.66	
13+00	647.43	
13+23		NW-643.30 E-643.30 S-642.36 NW-643.02
13+32		

NOTES:

DISCLAIMER

The information contained on this drawing may be based upon data provided by others and may not have been verified by either as-constructed drawings or an Ontario Land Surveyor. The City of North Bay cannot accept responsibility for any errors or omissions on any information shown herein. Field verification, land surveys or excavation (with City approvals) may be required to determine actual location of any and all utilities or property lines.

No.	REVISION	DATE	INITIAL
1.	New Drawing	April 1975	R.f.B.
2.	Gas Services 3/4"	Feb. 76	R.f.B.
3.	AS CONSTRUCTED STORM SEWER	MAR. 76	R.f.B.

APPROVED

SUMMIT DRIVE
MARSHALL PARK DRIVE to MARSHALL AVE.
Registered Plan No. M-355

CITY OF NORTH BAY
ENGINEERING DEPARTMENT

SCALE: As Shown
DATE: April 75.
DRAWN BY: CK'D. BY:
FIELD BOOK No. 242
DRAWING No. S-301
REV.