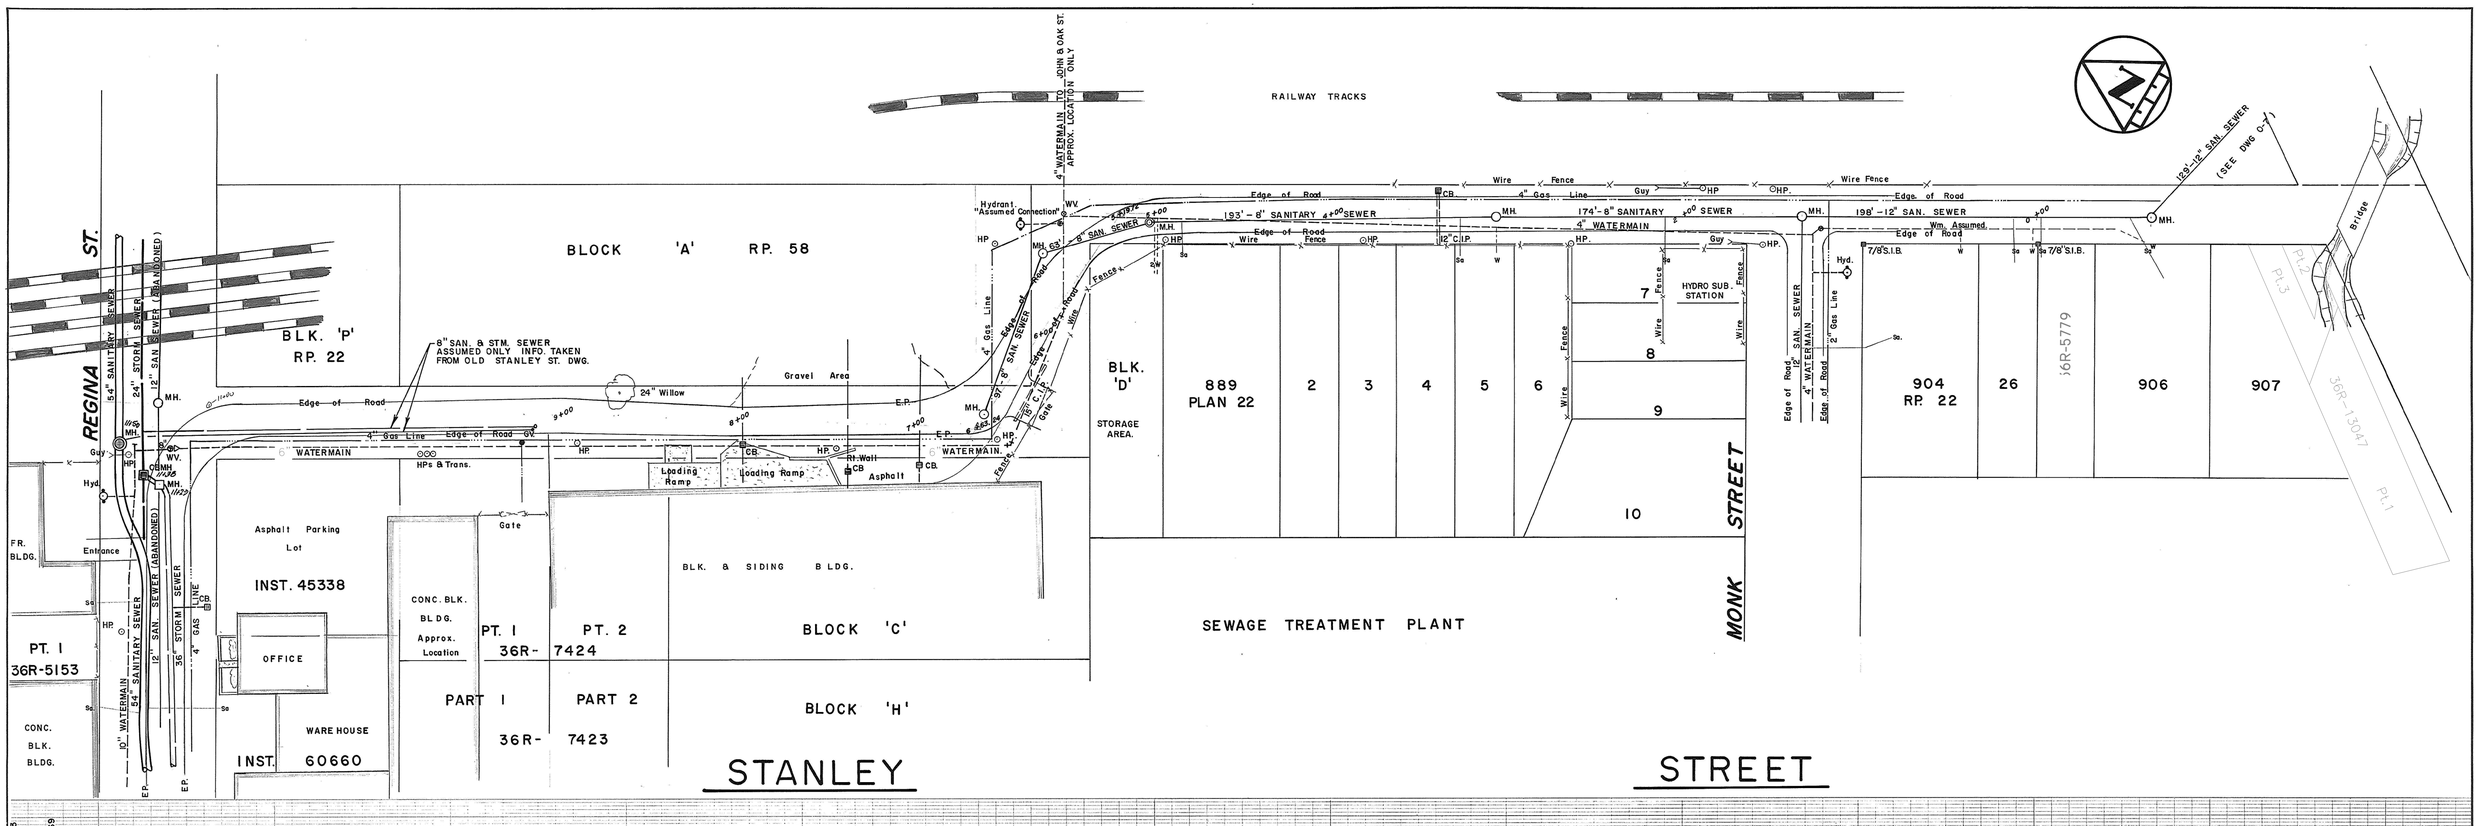

NOTES:

DISCLAIMER

The information contained on this drawing may be based upon data provided by others and may not have been verified by either as-constructed drawings or an Ontario Land Surveyor. The City of North Bay cannot accept responsibility for any errors or omissions on any information shown herein. Field verification, land surveys or excavation (with City approvals) may be required to determine actual location of any and all utilities or property lines.

DMG' 1/0'

No.	REVISION	DATE	INITIAL
3.	Updated Watermain Size from Regina to Bend	Jan '14	J.J.M.
2.	Added 36R-13047	May '11	G.W.C.
1	AS BUILT SANITARY SEWER 5+00 to 6+55	June '90	P.L.C.

NOTE: UNDERGROUND SERVICES FROM AS CONST'D. DRAWINGS APRIL 19 1961.

STANLEY STREET

REGINA STREET TO SOUTH OF MONK STREET

CITY OF NORTH BAY

ENGINEERING DEPARTMENT

SCALE: HOR. 1"=40' VER. 1"=4'

DATE: SEPT. 88

DRAWN BY: Rick B.

CK'D. BY:

FIELD BOOK No. 283

DRAWING No. S-551

REV.